


16

CLARK

6773

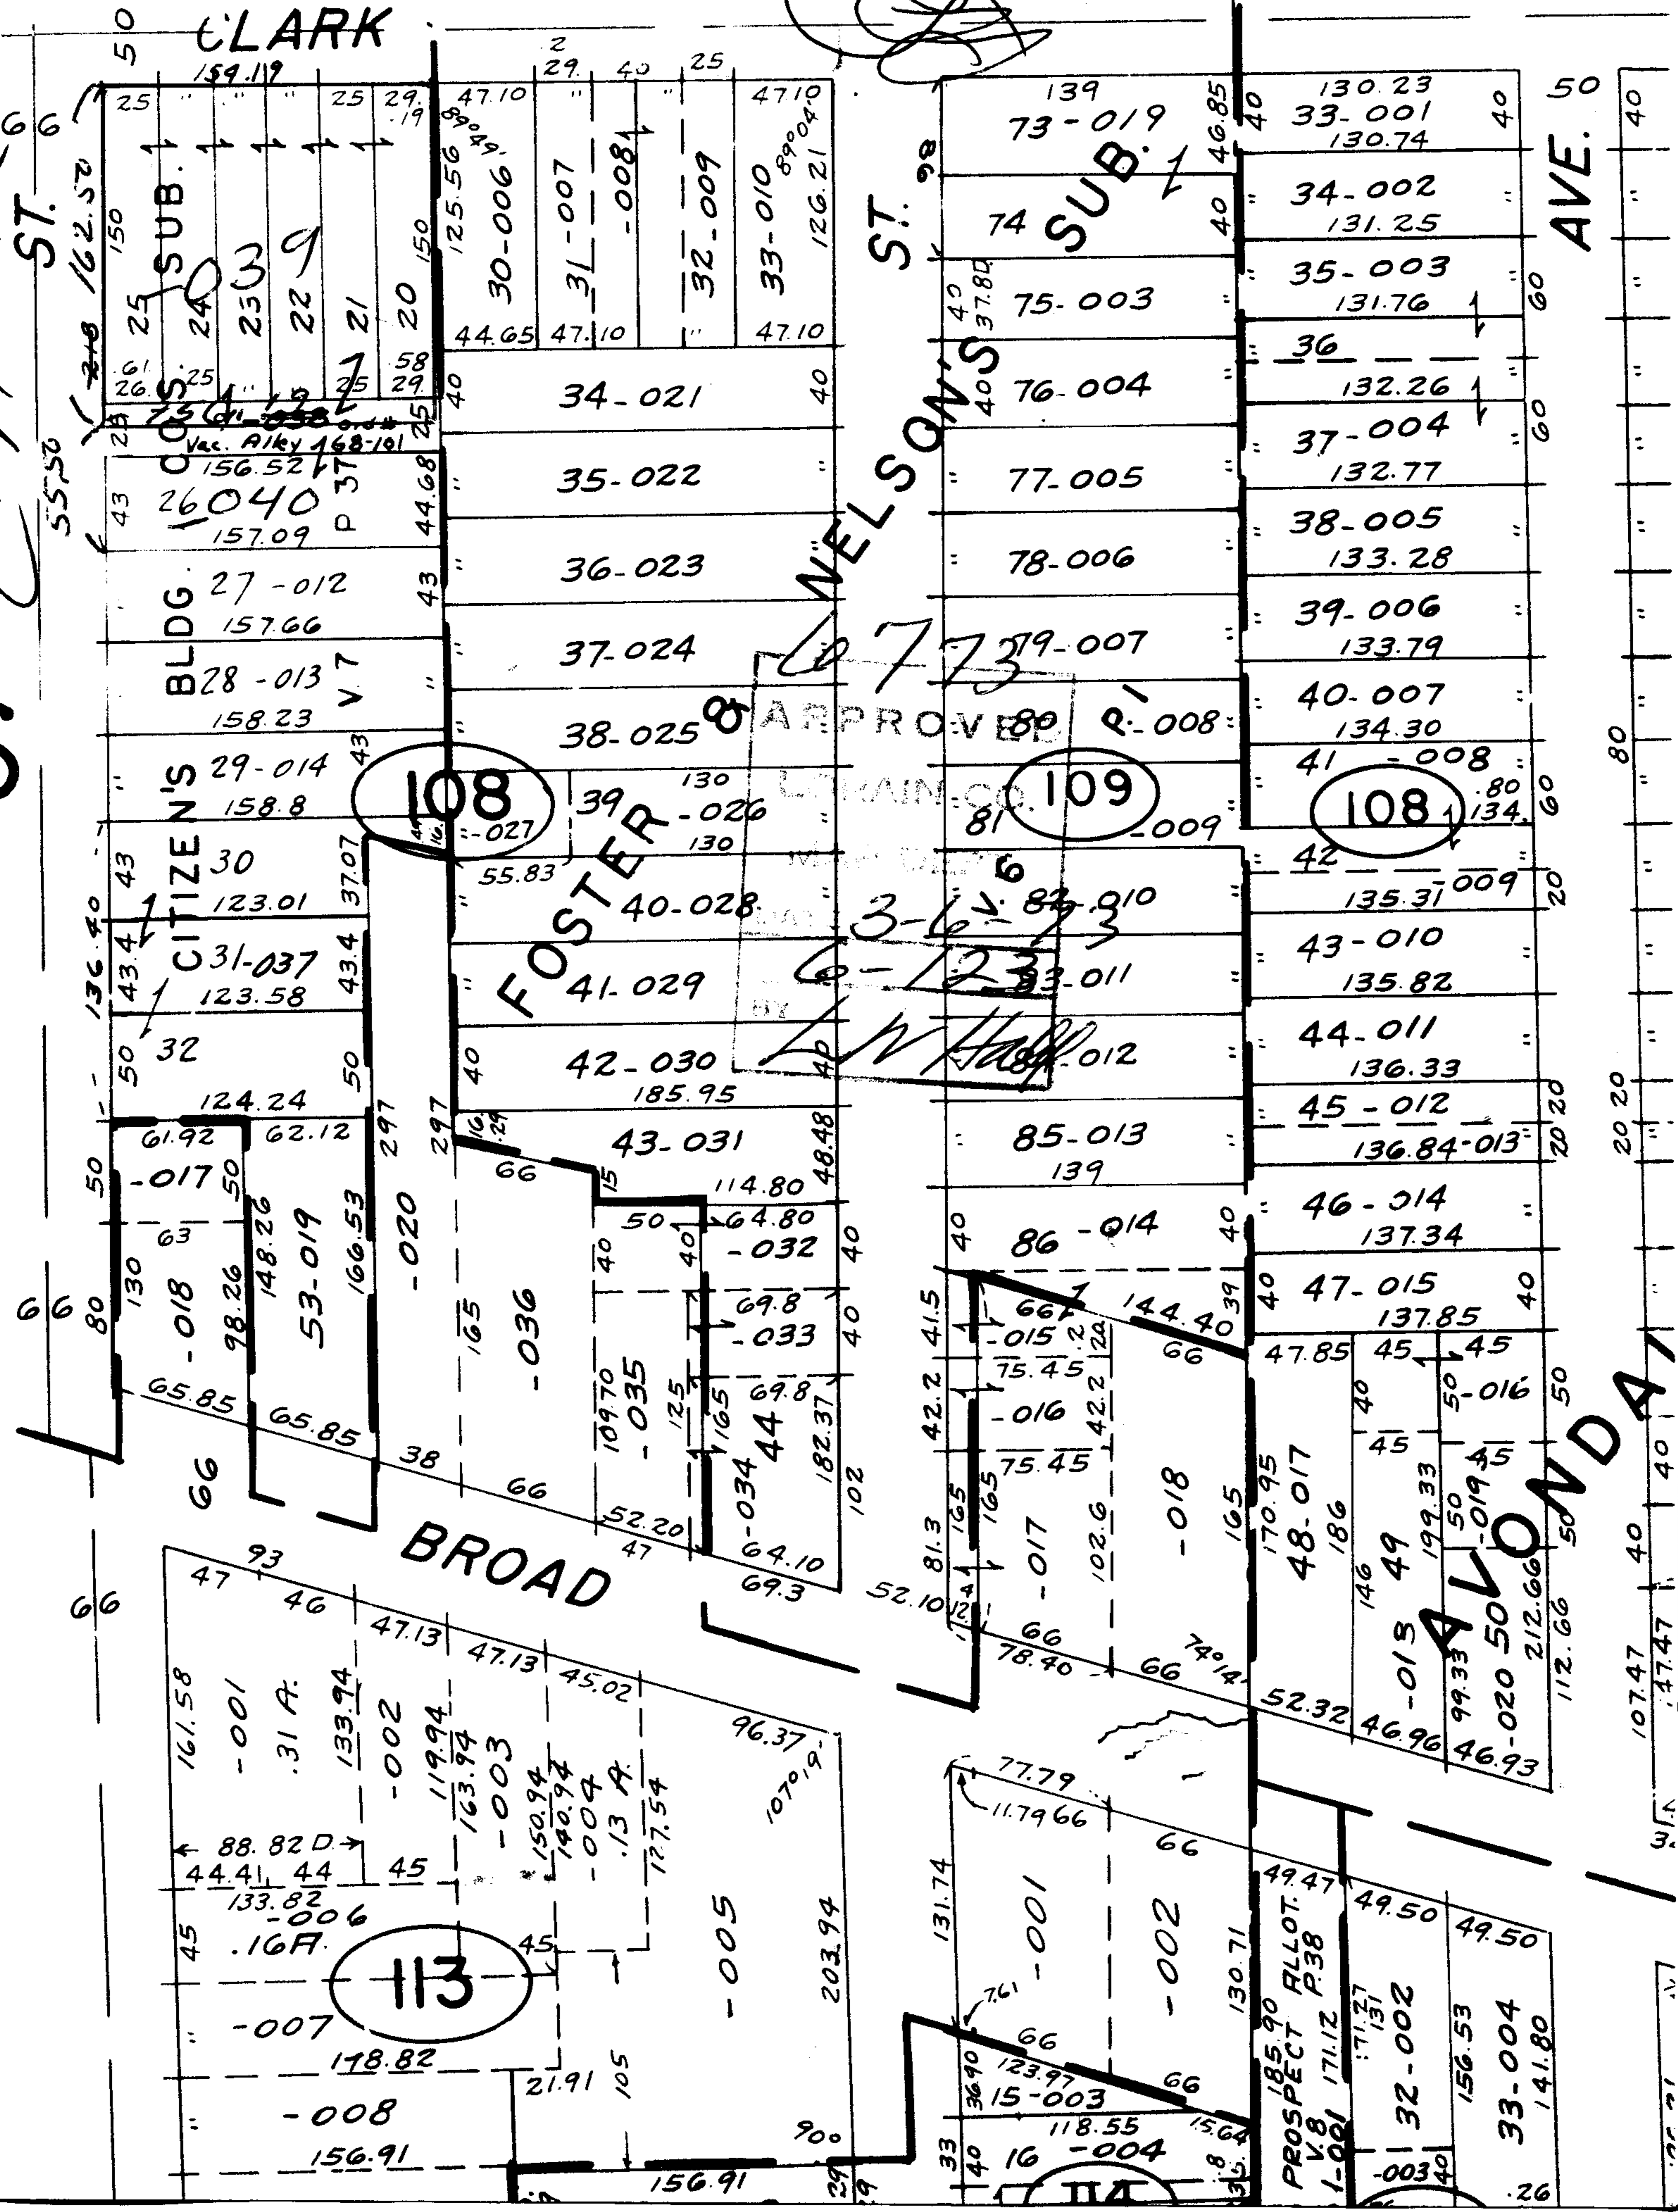

108

109

108

113

114

AVE.

AVALONDA

APPROVED

3-6-73

AP

PROSPECT ALLOT.

V.B.

Vac. Alley 168-101

BLDG.

28-013

29-014

30

31-037

32


















34-021

35-022

36-023

37-024

38-025

39-026





















30-006

31-007

























73-019


























AVE.

AVALONDA

PROSPECT ALLOT.

V.B.