

6790


SEE 5
MILAN - ELYRIA
(66)

SEE 5

113

OBERLIN - NORTH

58

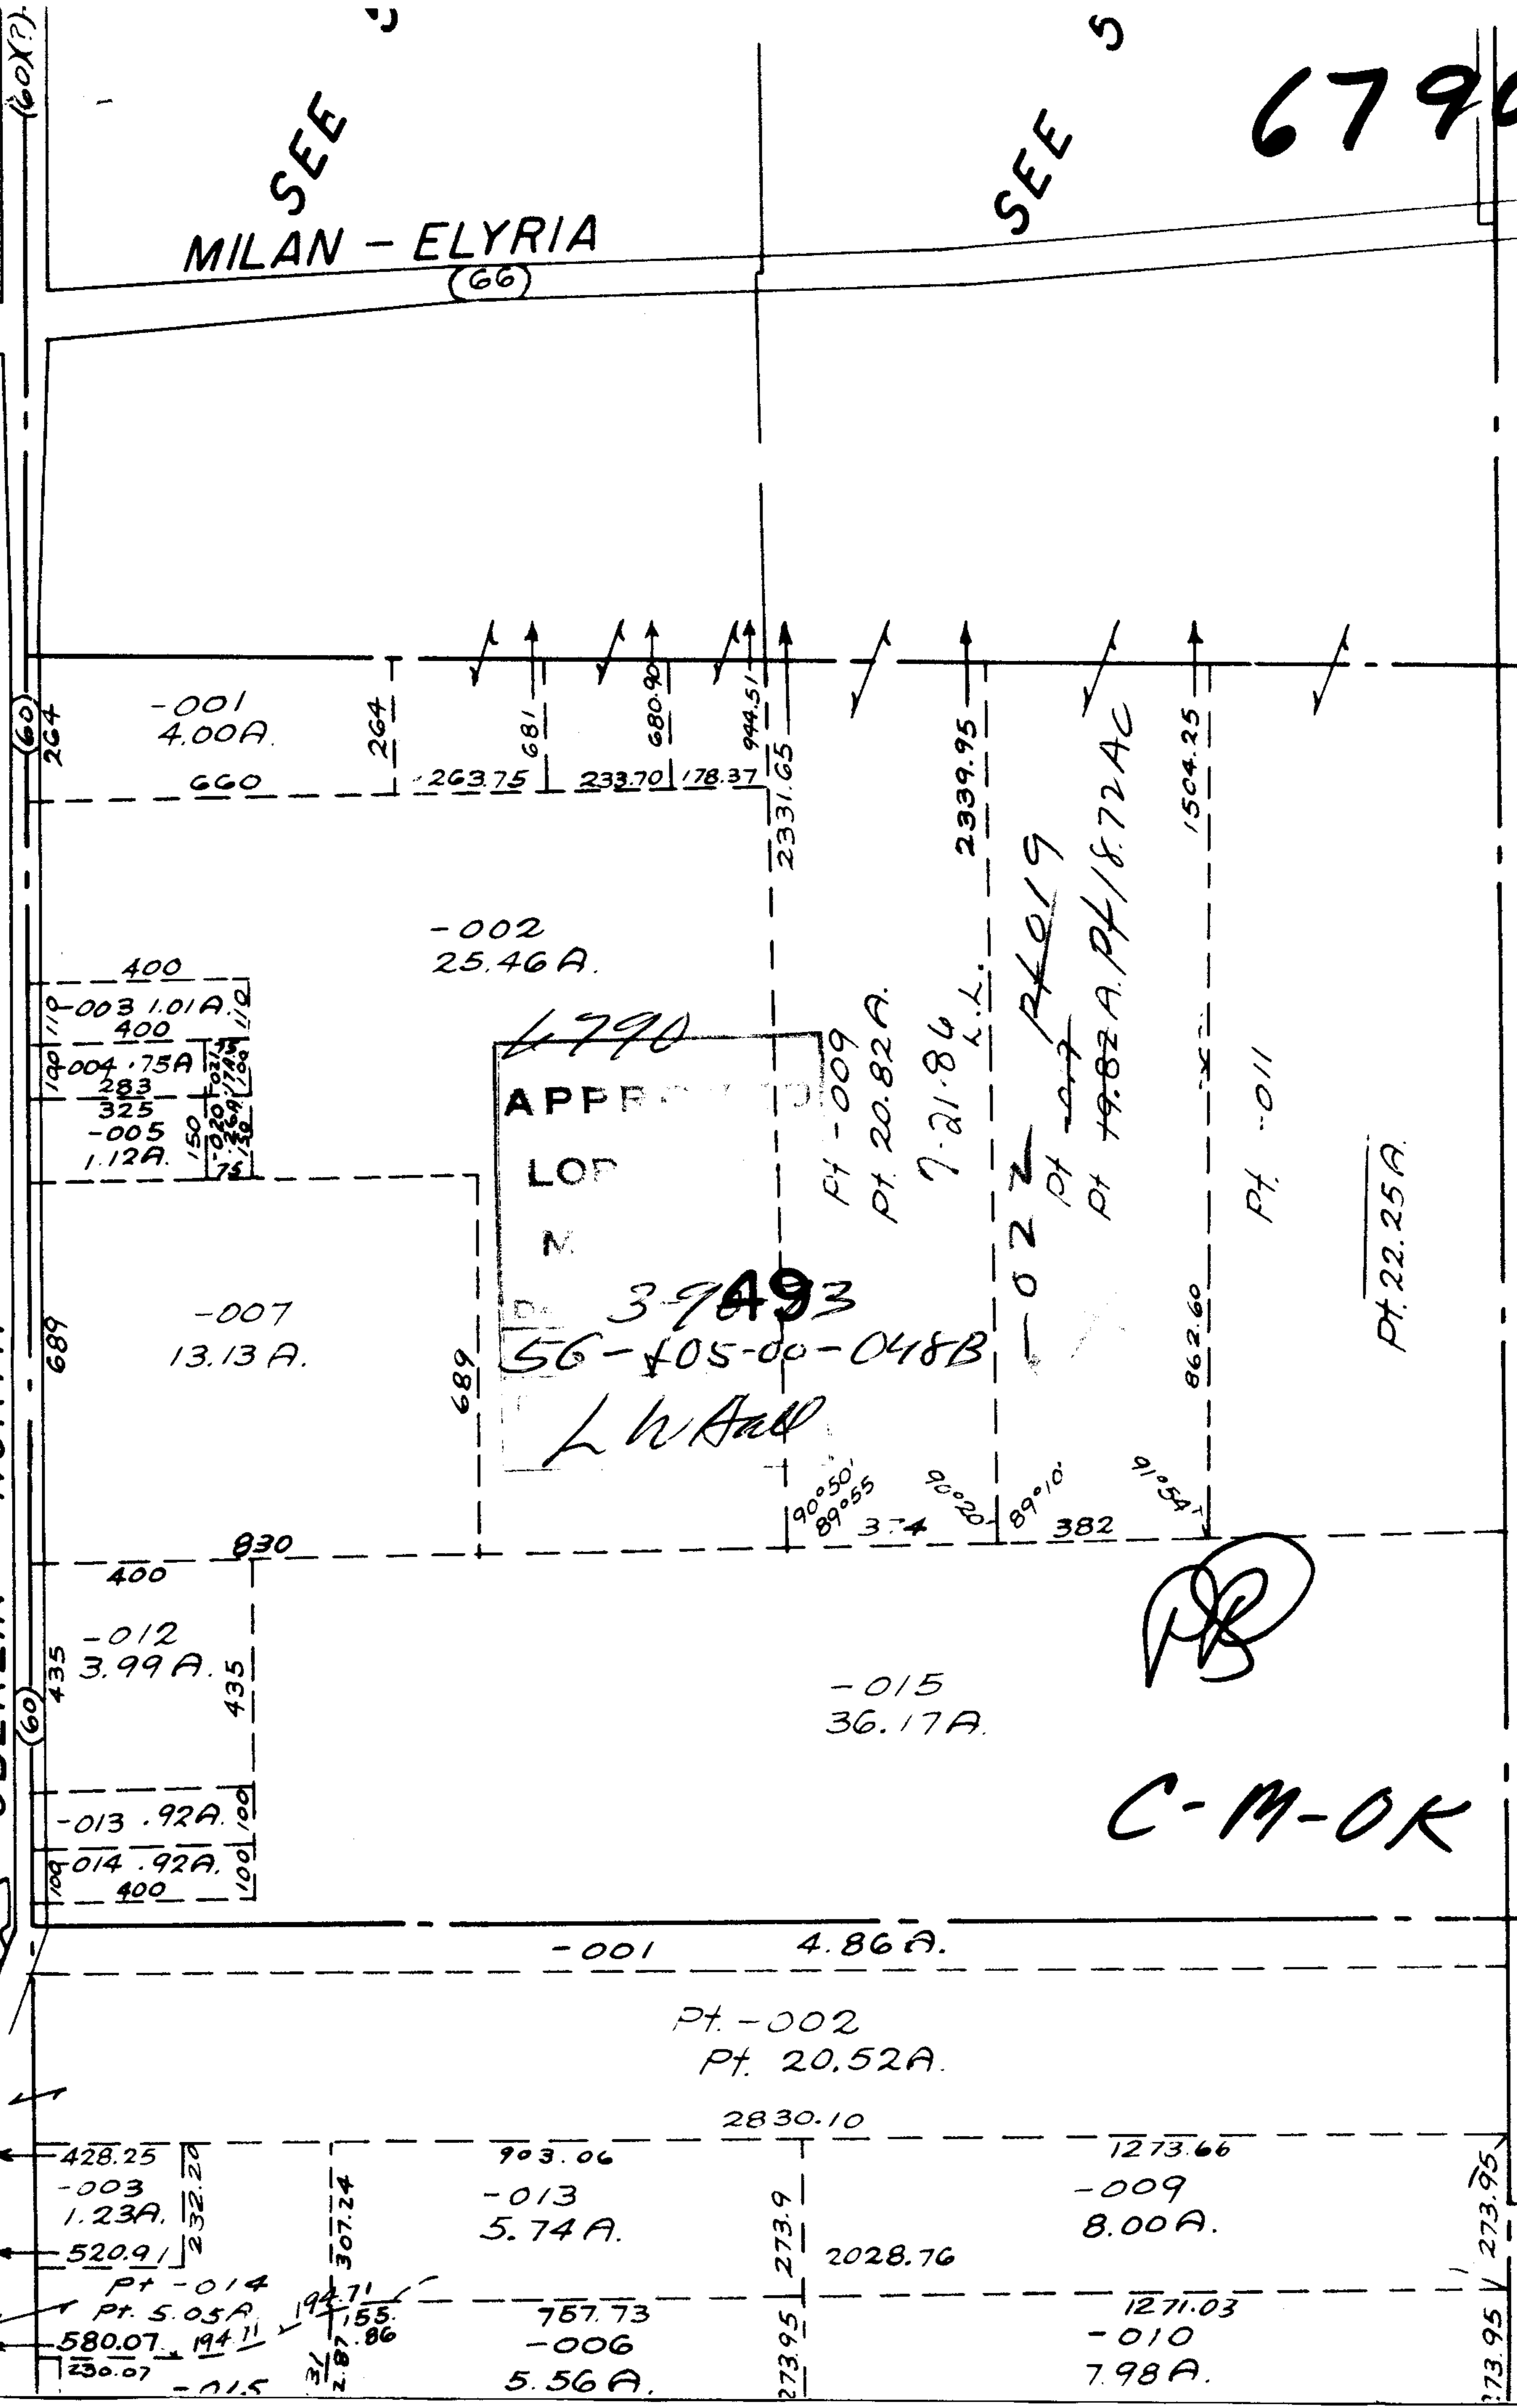

6790
 APPROXIMATE
 LOP
 M
 39493
 56-105-00-048B
 L W Hall

CR
 C-M-OK