


6792

(Handwritten initials)

SEE 2-02-006-B

7-21-84 5.5
 6792
 APPROVED
 LORAIN
 39-73
 02-02-005B
 BY L W Hall

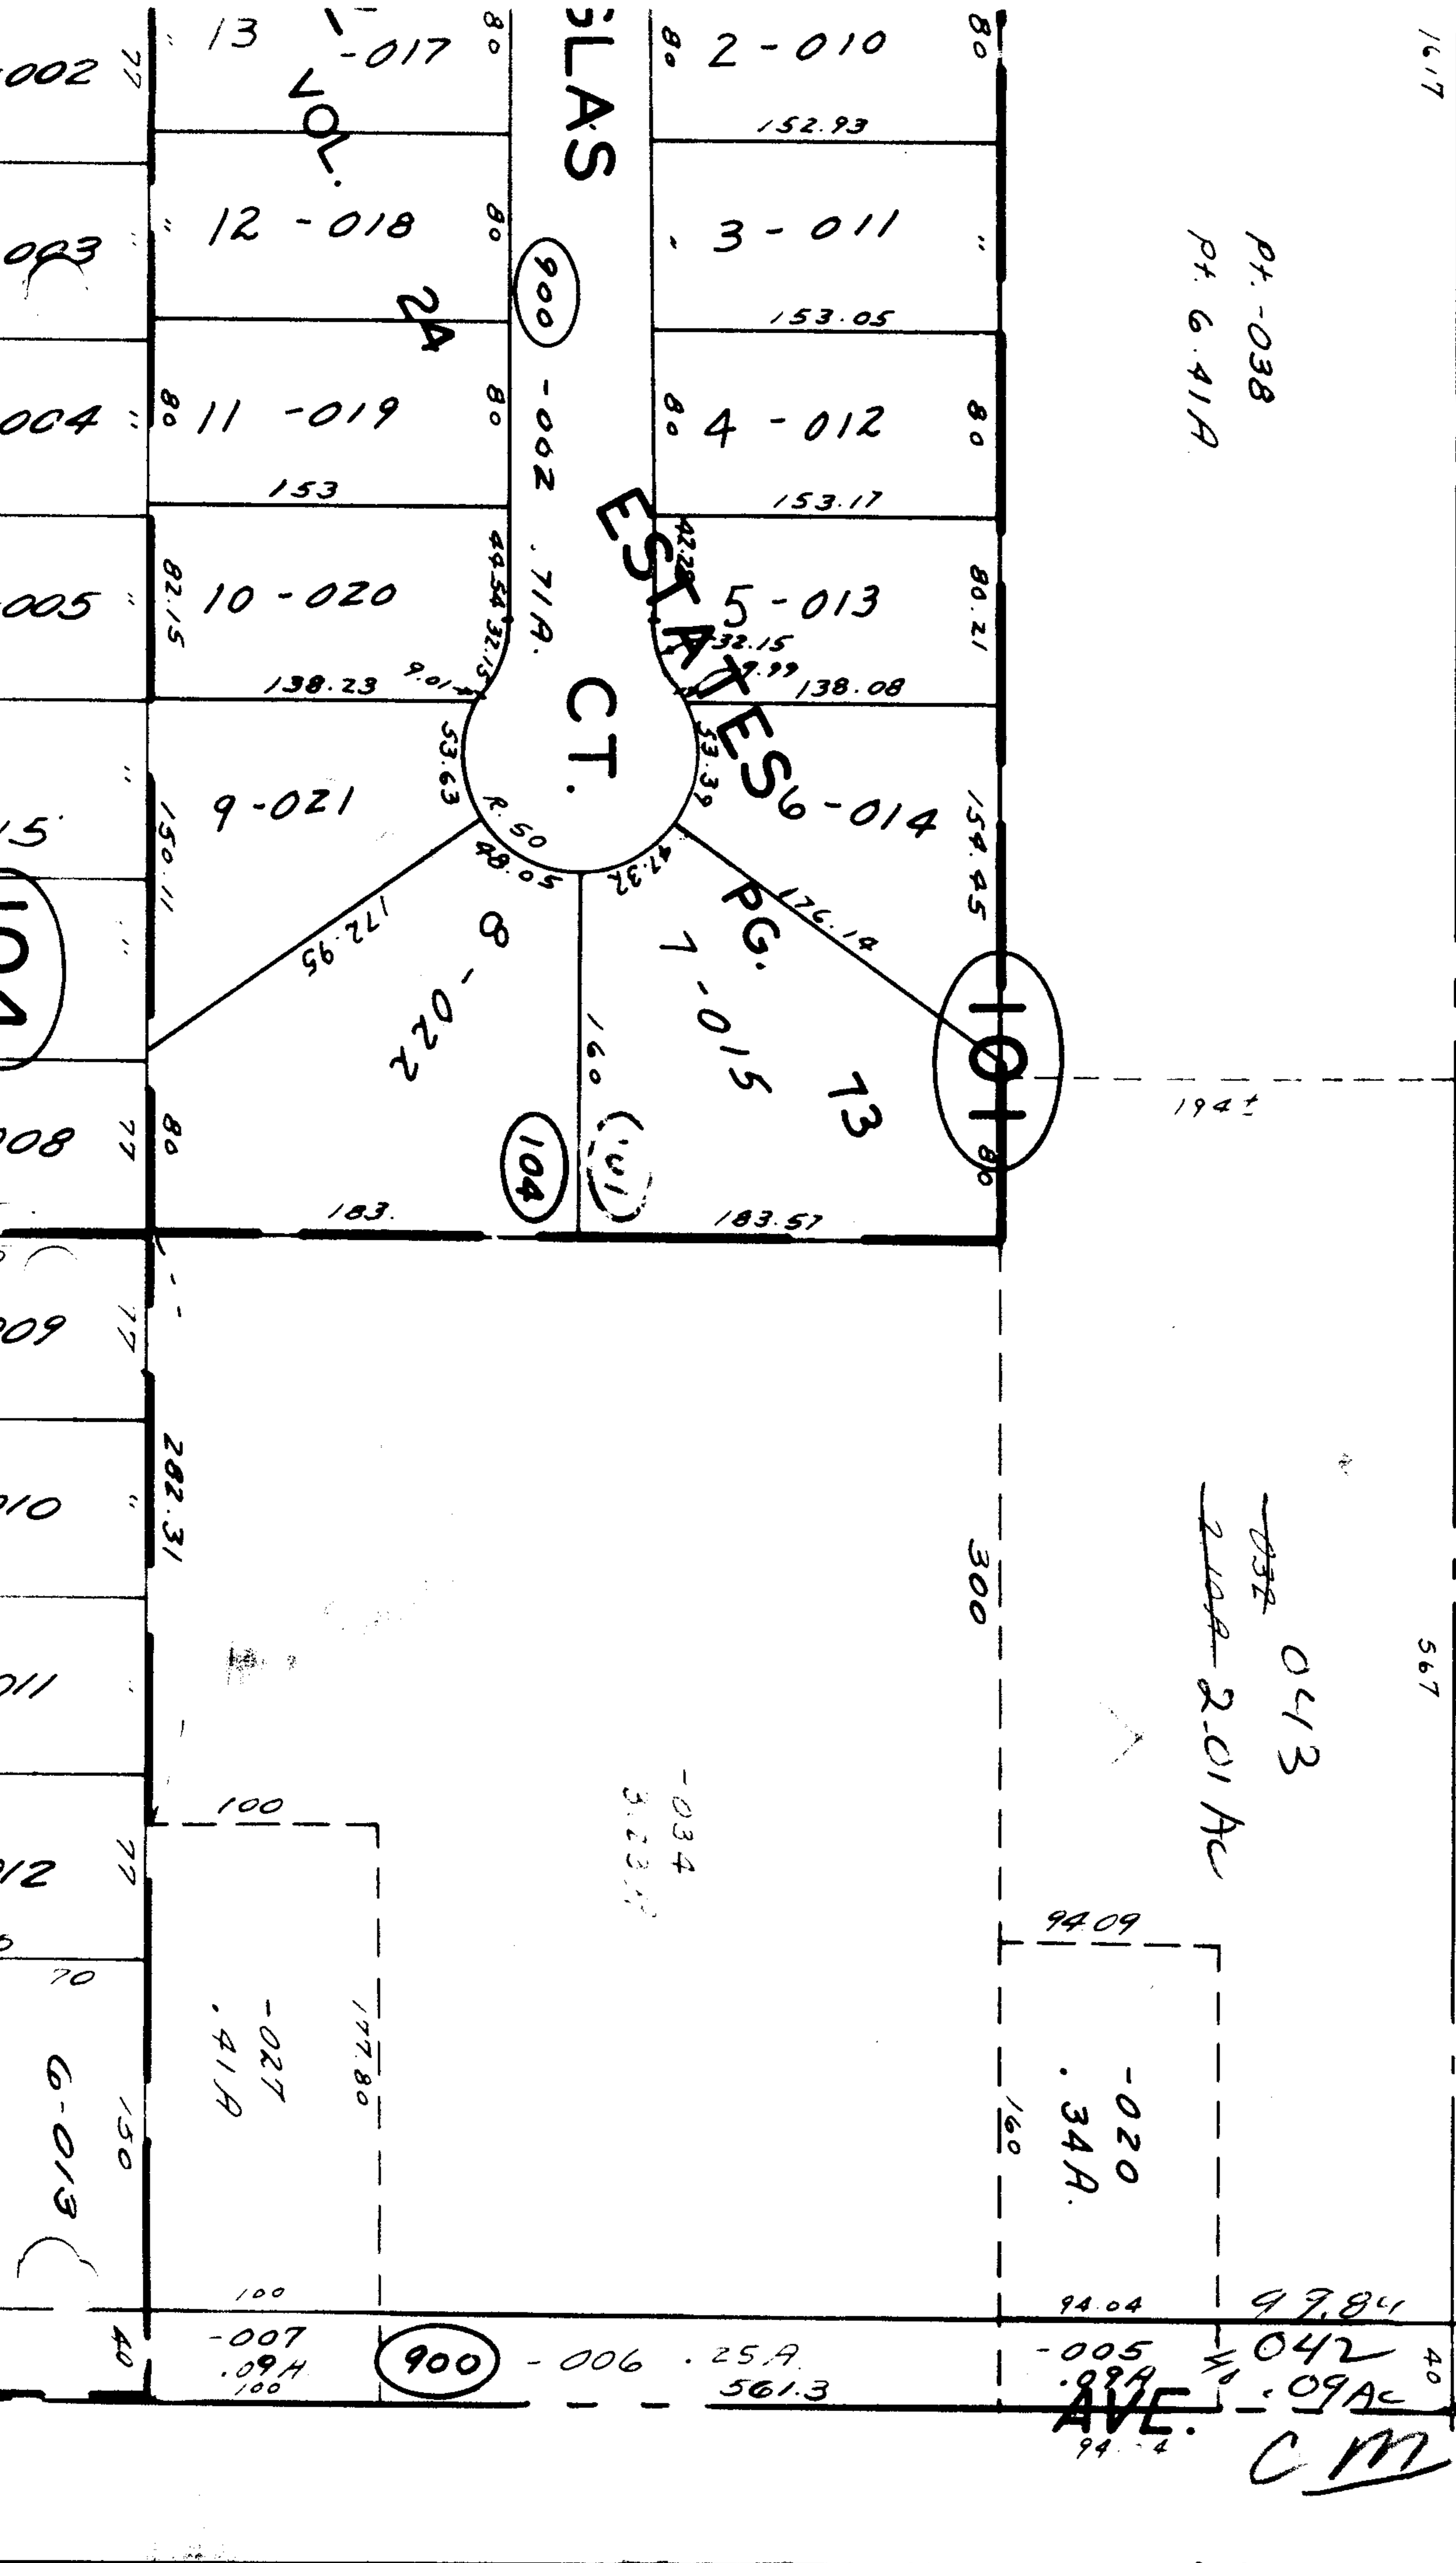

AVE. C.M. - OK