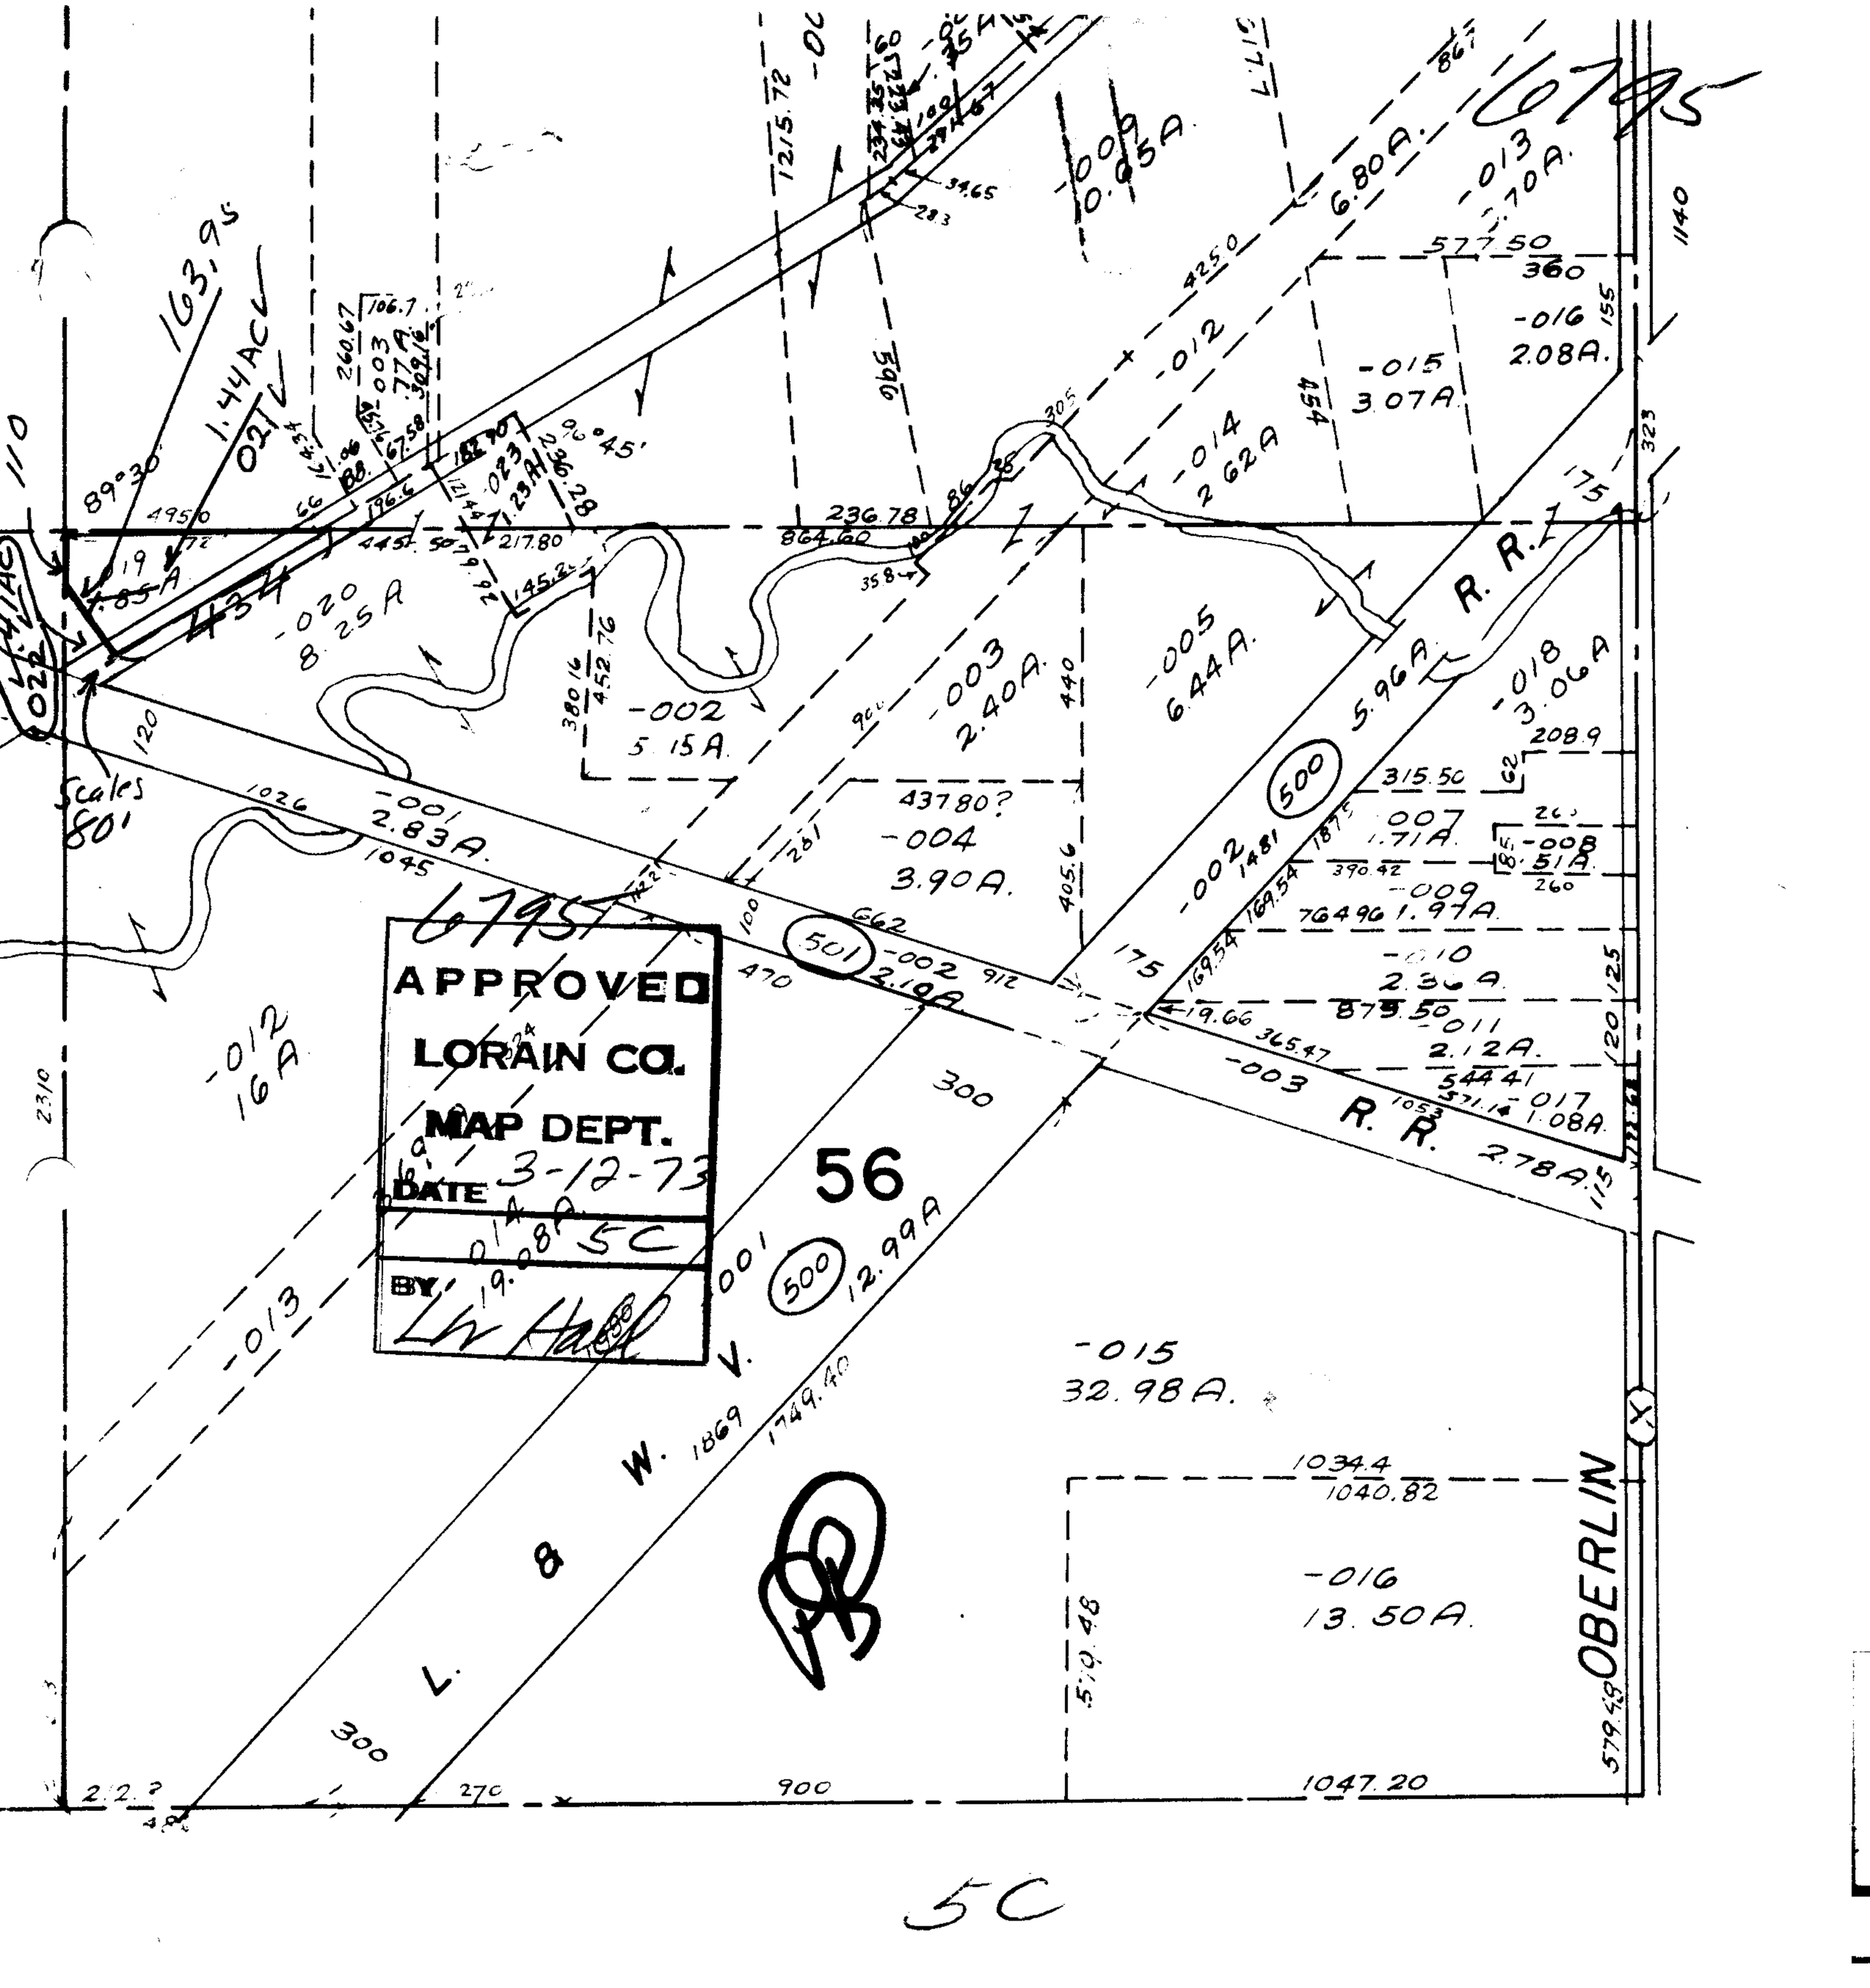

5C

Cm — ok

LOTS 41 THRU 45 & 56 THRU 60