


MARK

UNZ214 (105)

6807

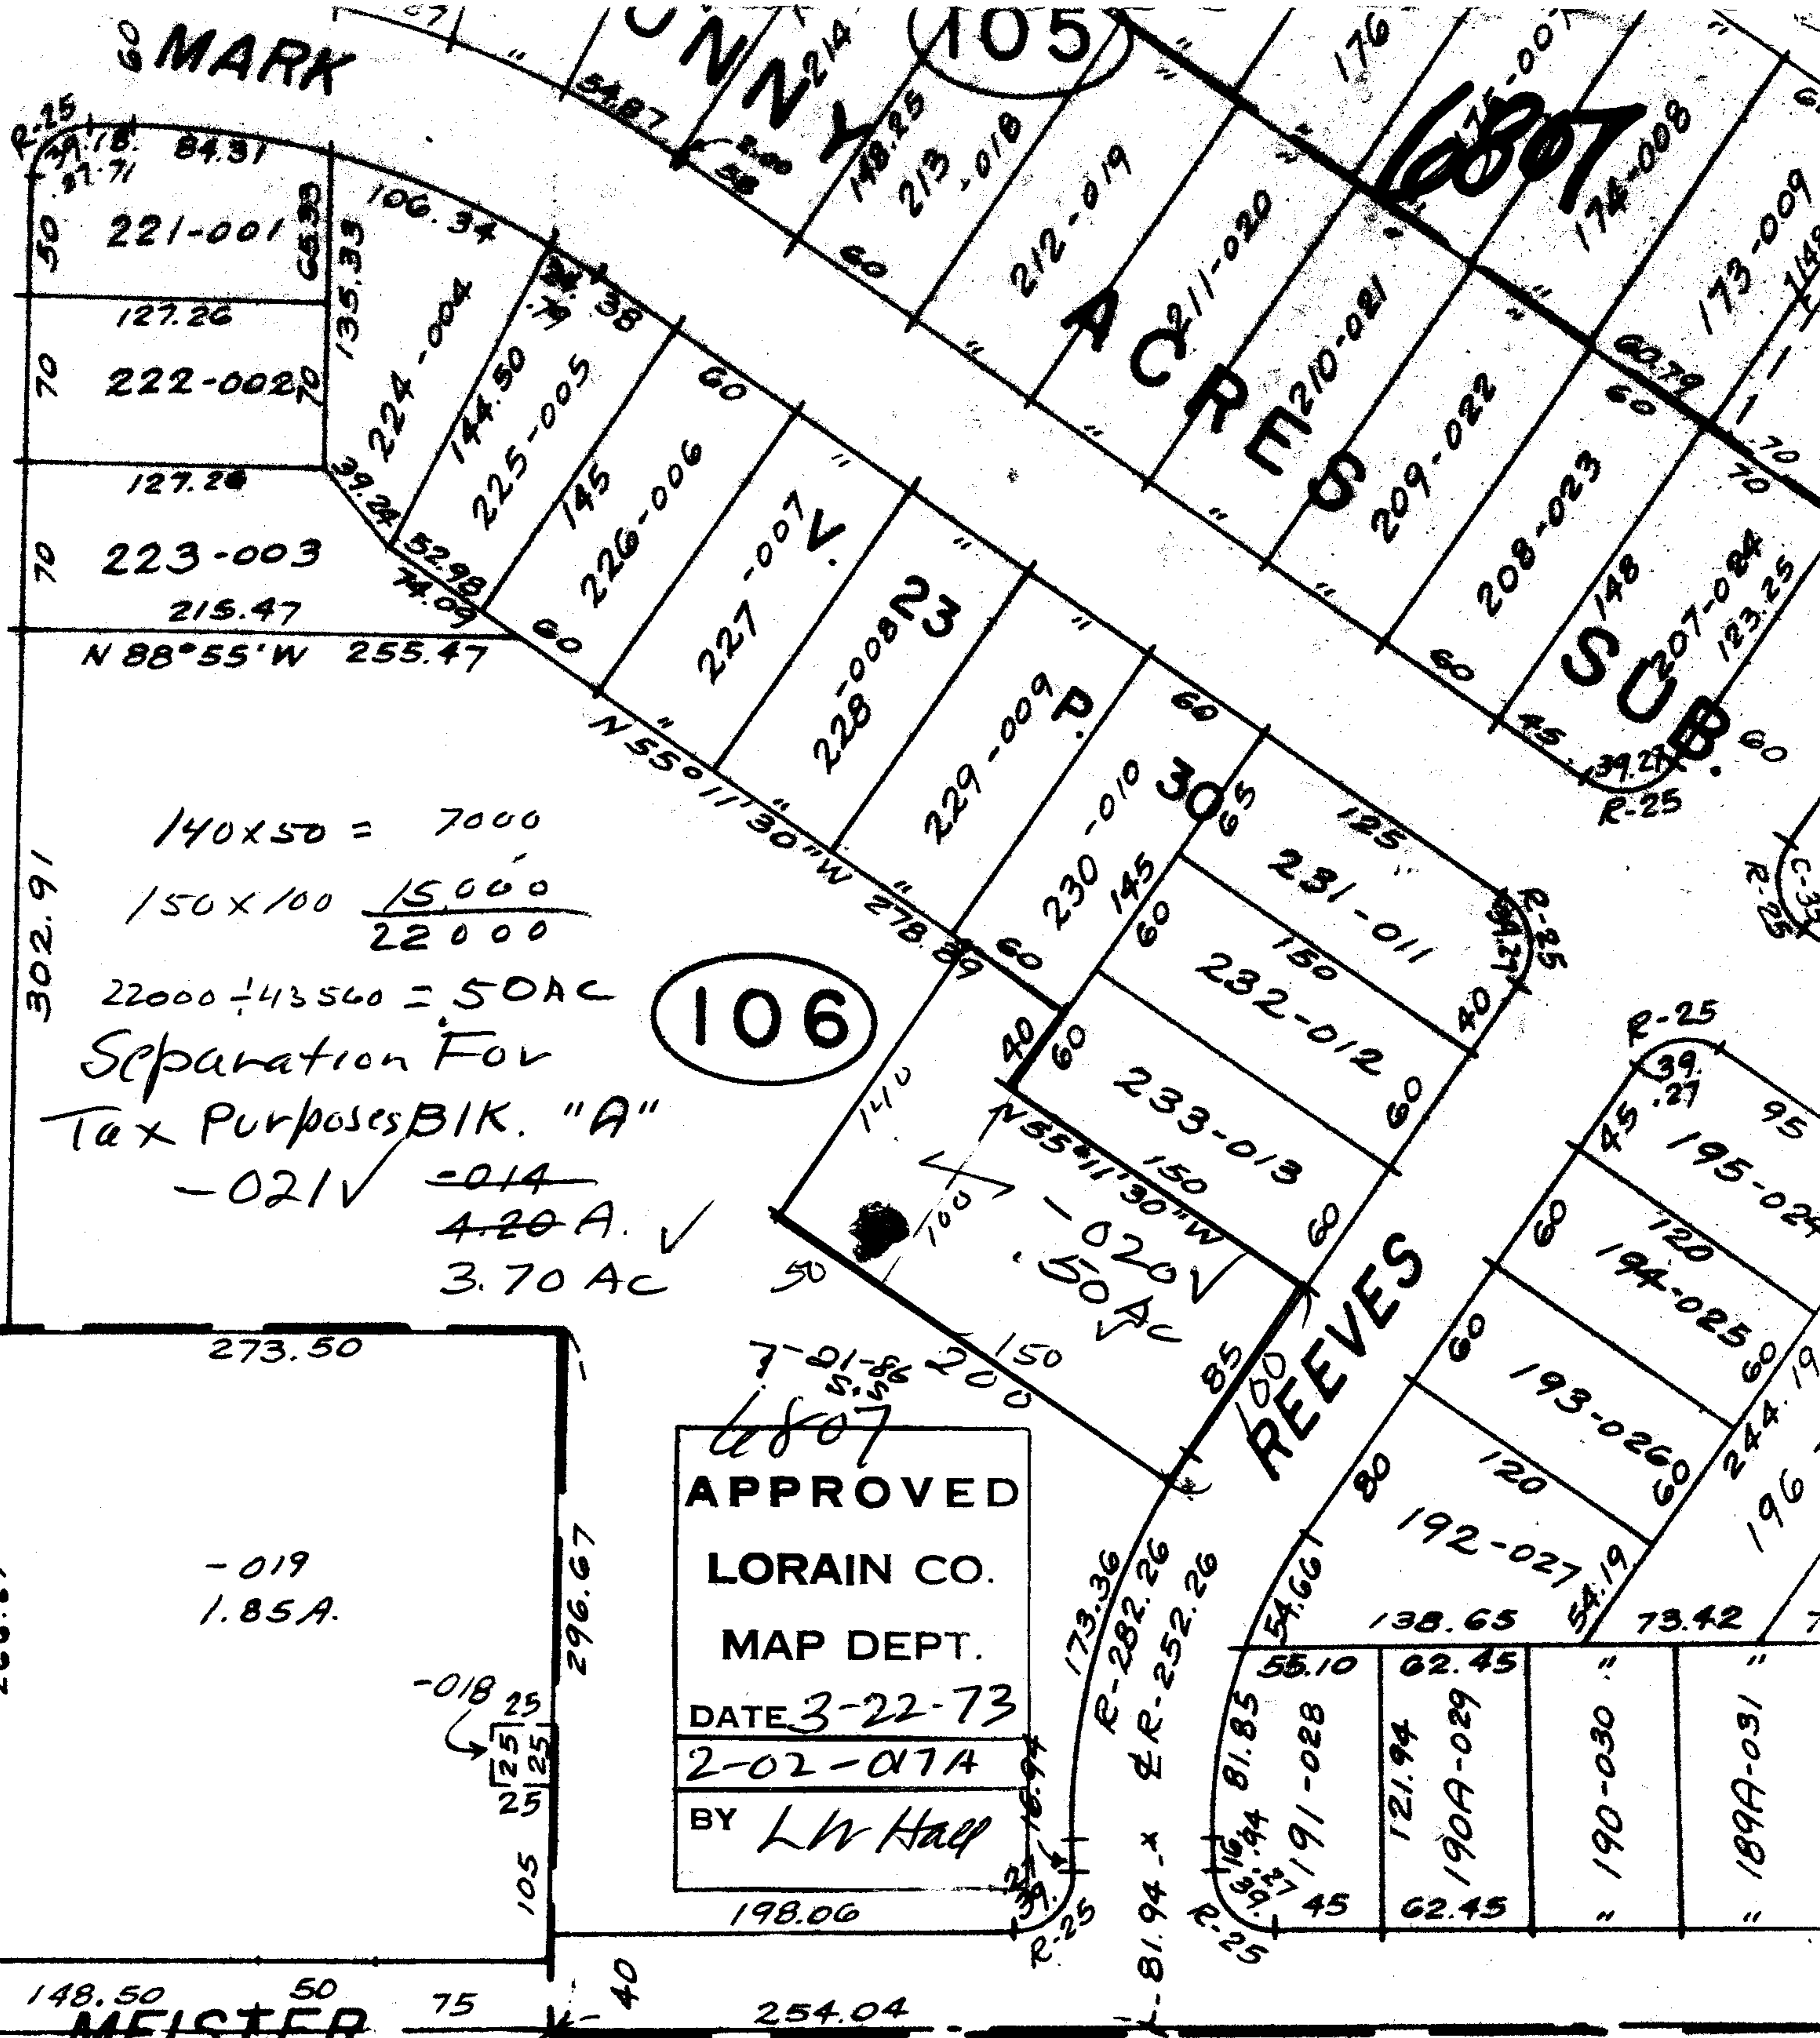

$140 \times 50 = 7000$
 $150 \times 100 = 15000$
 $\hline 22000$
 $22000 \div 43560 = 50 \text{ AC}$
 Separation For
 Tax Purposes BIK. "A"
 -021V = 0.14
 4.20 A. ✓
 3.70 AC

106

APPROVED
 LORAIN CO.
 MAP DEPT.
 DATE 3-22-73
 2-02-07A
 BY L W Hall
 198.06

LEAVITT
 146.67 50 100
 266.67
 273.50
 -019
 1.85 A.
 296.67
 105
 225 25
 225 25
 198.06

MEISTER
 148.50 50 75 40
 273.50 254.04

REEVES

SEE 2

PRS

C-MOK

BLACK RIVER TWP.

SCALE: 1" = 100'