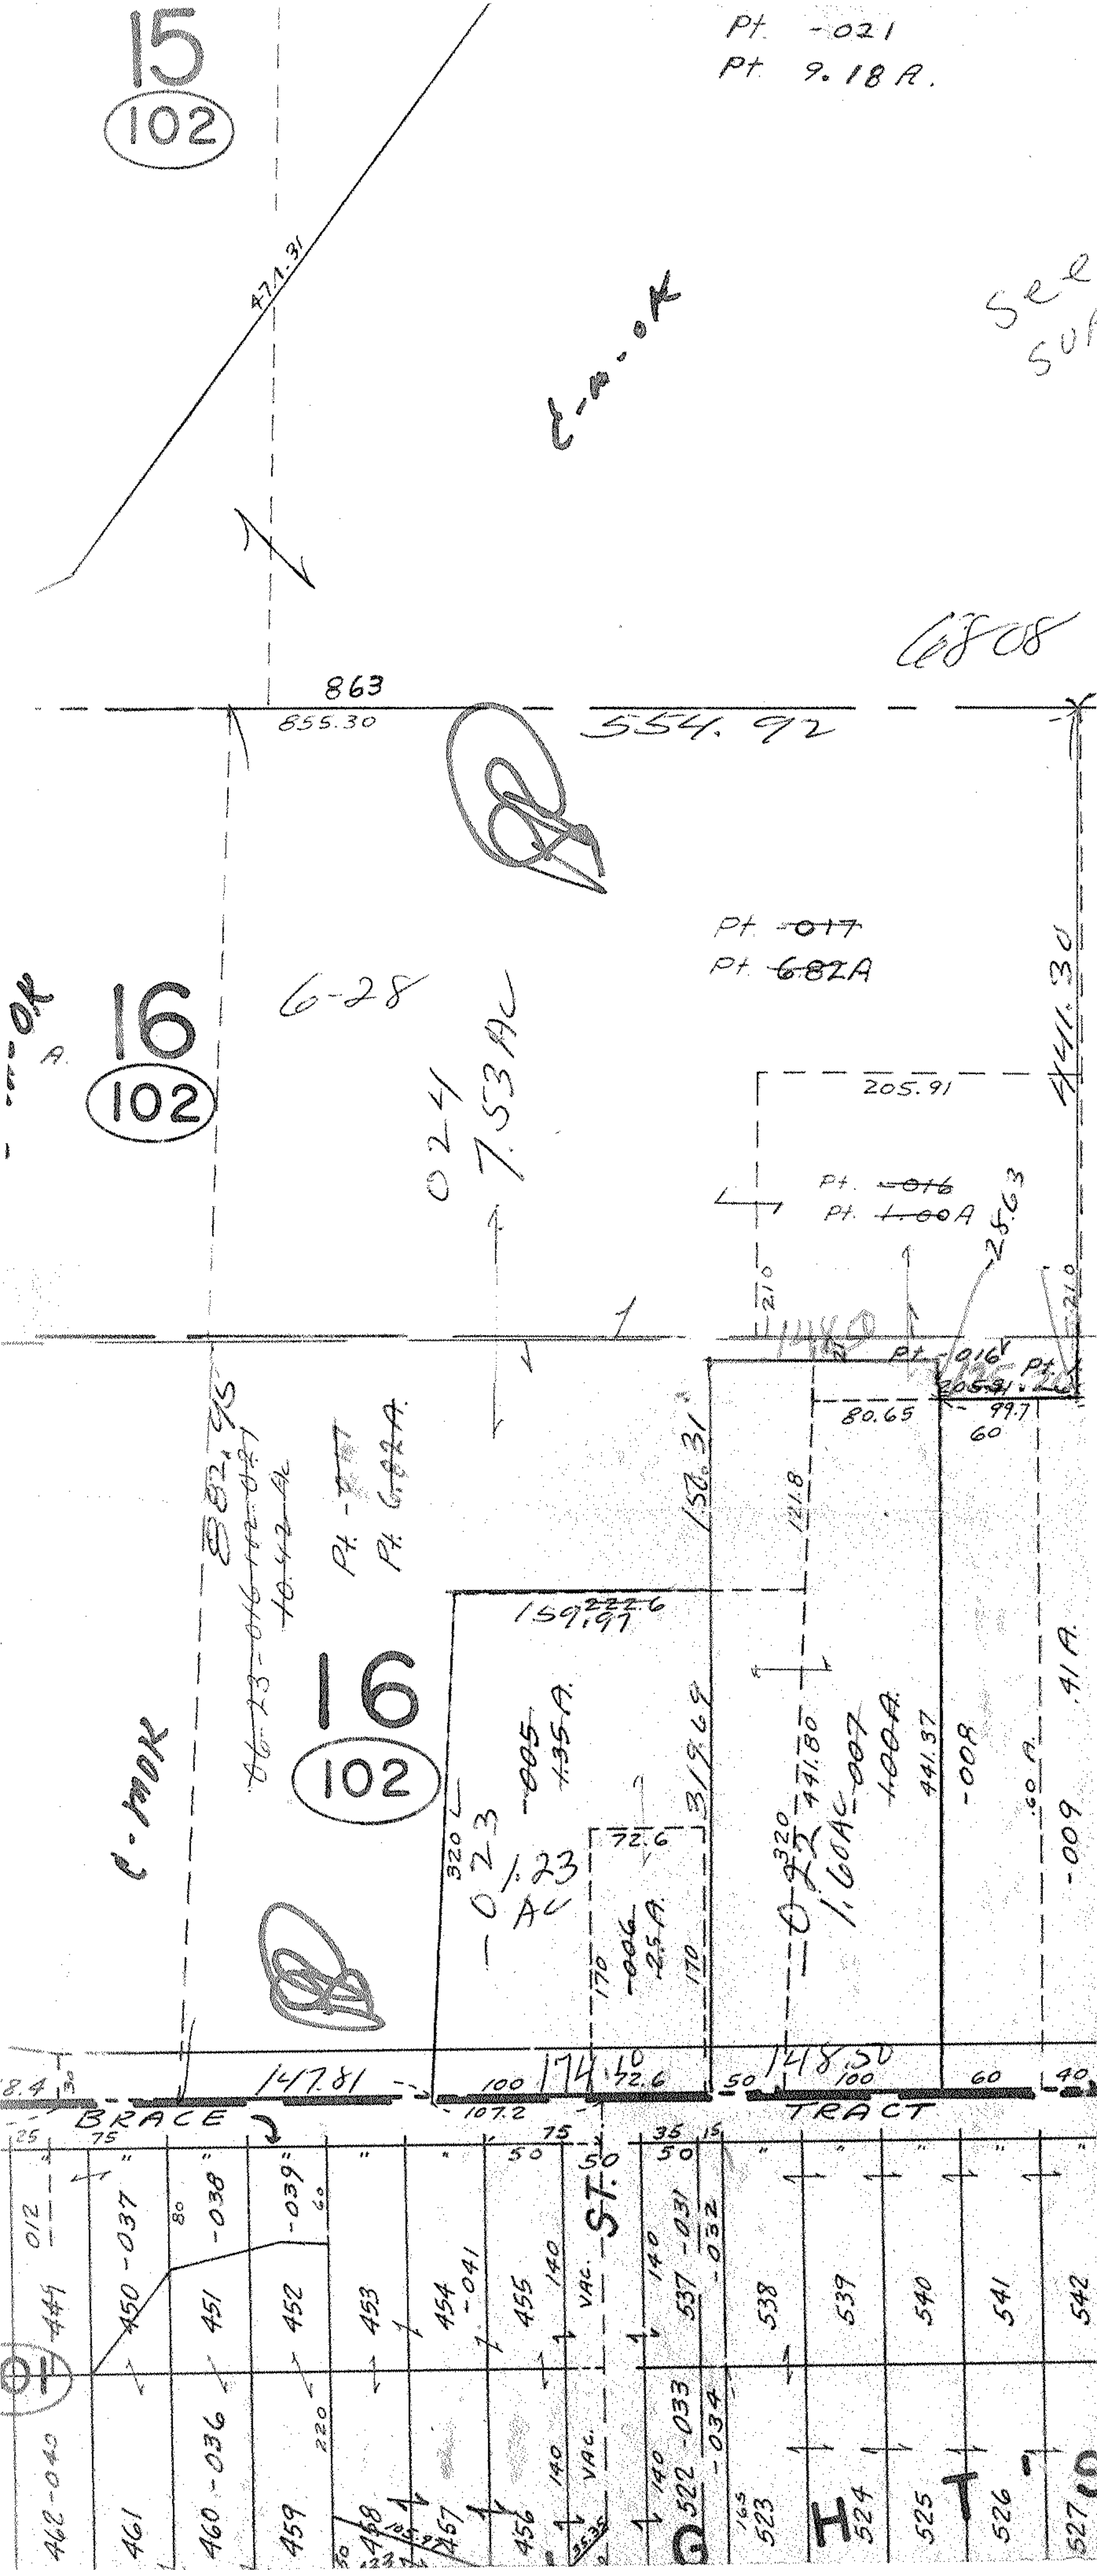

15
102
Pt. -021
Pt. 9.18 A.
471.31
See
6808
863
855.30
554.92
Pt. -017
Pt. 6.82A
16
102
6-28
024
7.53 Ac
205.91
Pt. -016
Pt. 1.00A
25.63
441.30
Pt. -016
80.65
99.7
60
150.31
121.8
159.97
16
102
-005
1.35 A.
319.69
-023
1.23 Ac
72.6
-006
.25 A.
-022
1.60 Ac
441.80
-007
1.00 A.
441.37
-008
.60 A.
-009
.41 A.
147.81
174.10
148.50
BRACE
TRACT
107.2
ST.
VAC.