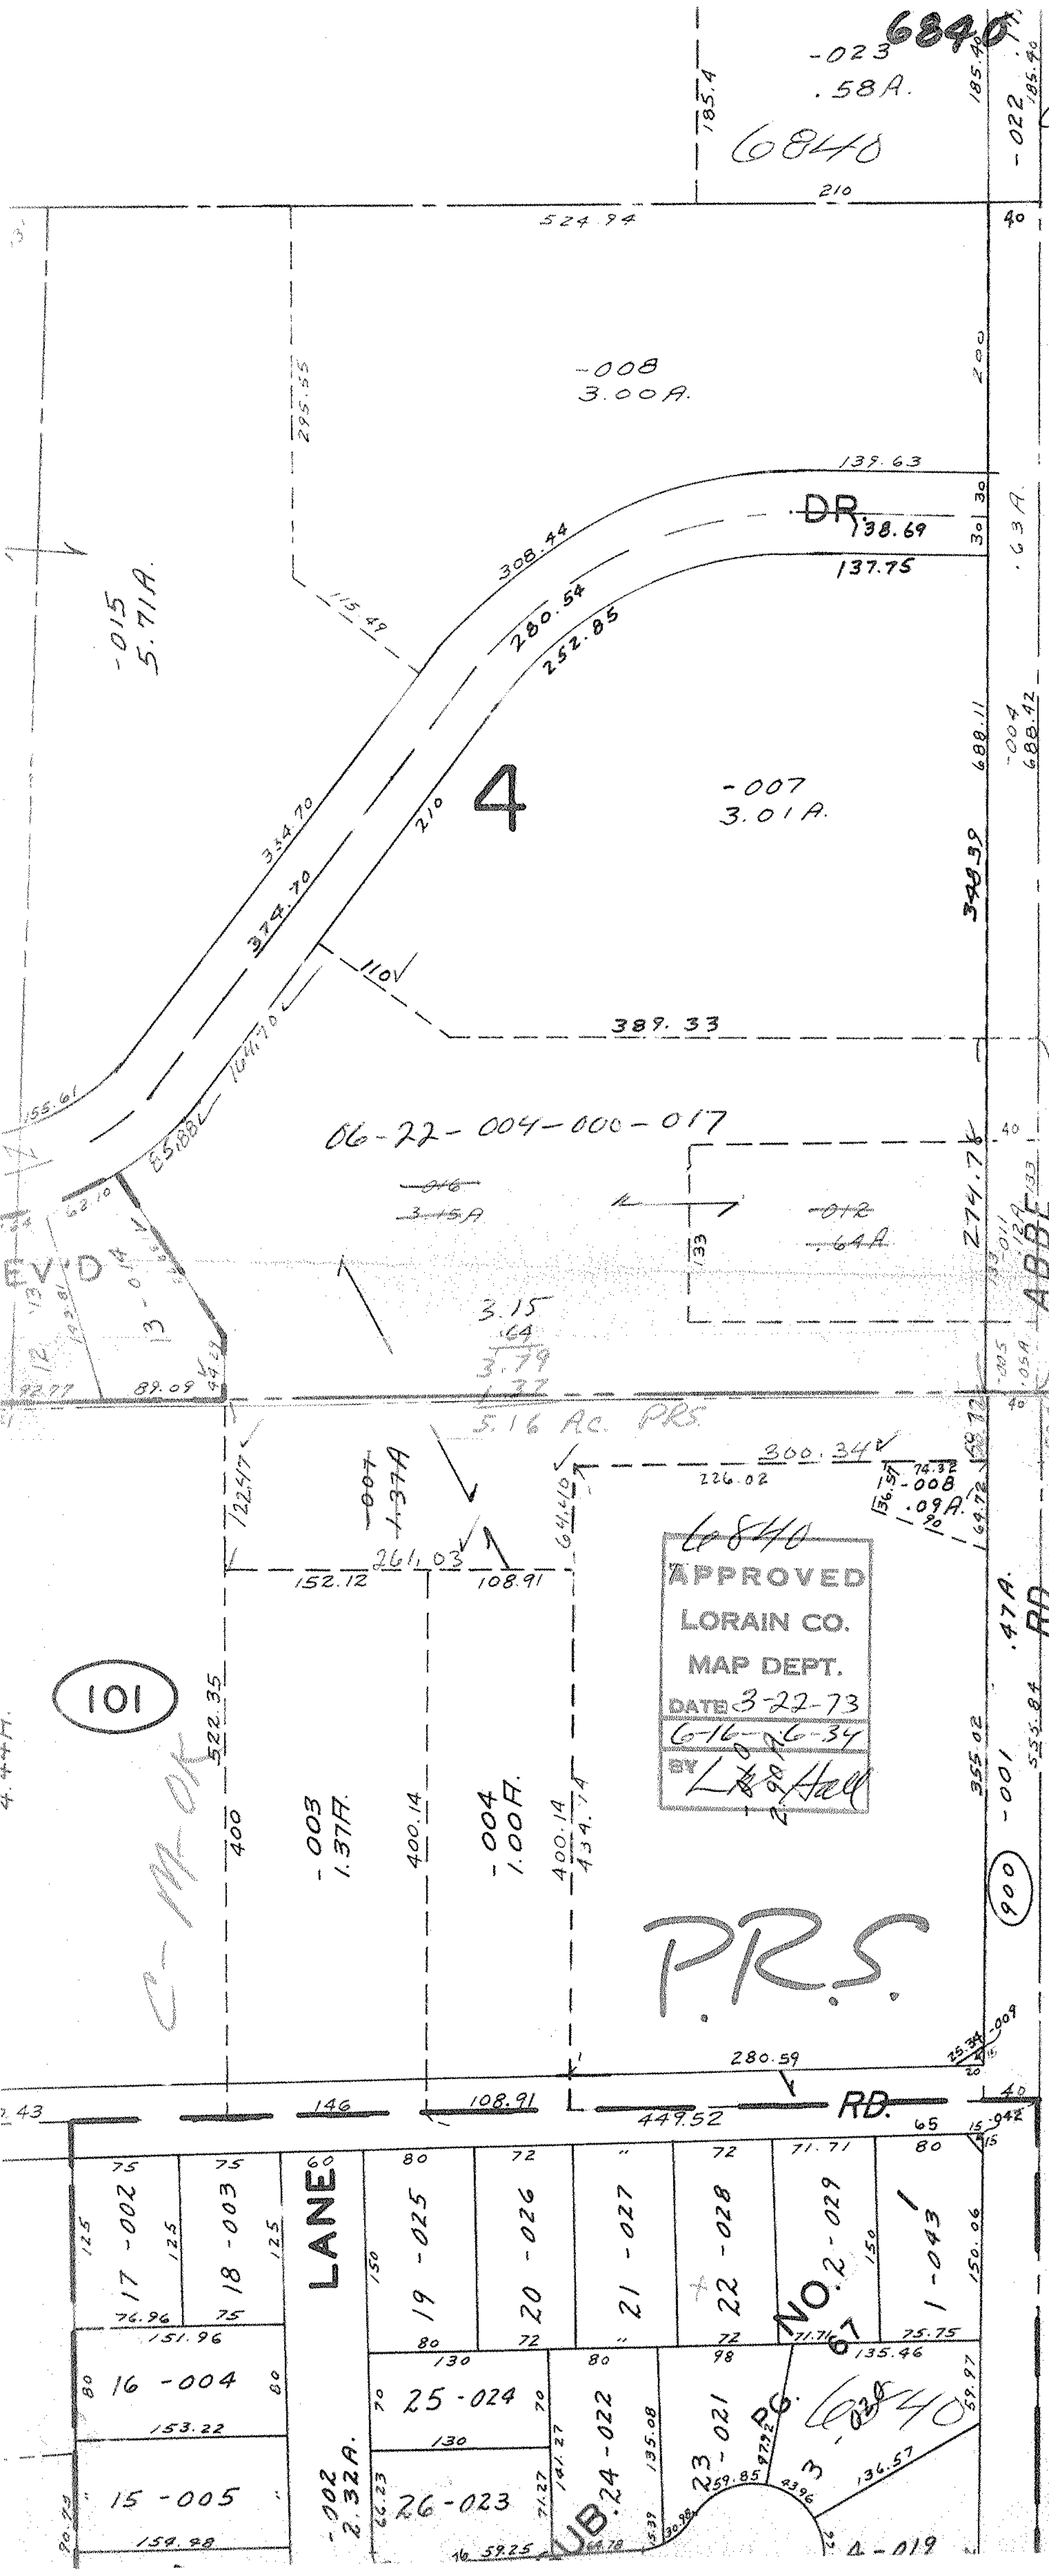

6840
-023
.58A.
6840
-022
-008
3.00A.
DR.
-015
5.71A.
4
-007
3.01A.
06-22-004-000-017
3.15
5.16 Ac. PRS.
ABBE
RD.
101
-003
1.37A.
-004
1.00A.
APPROVED
LORAIN CO.
MAP DEPT.
DATE 3-22-73
6-16-6-34
BY
P.R.S.
900
RD.
LANE
17-002
18-003
19-025
20-026
21-027
22-028
NO. 2-029
1-043
16-004
25-024
15-005
26-023
UB. 24-022
23-021
PG. 67
3
4-019