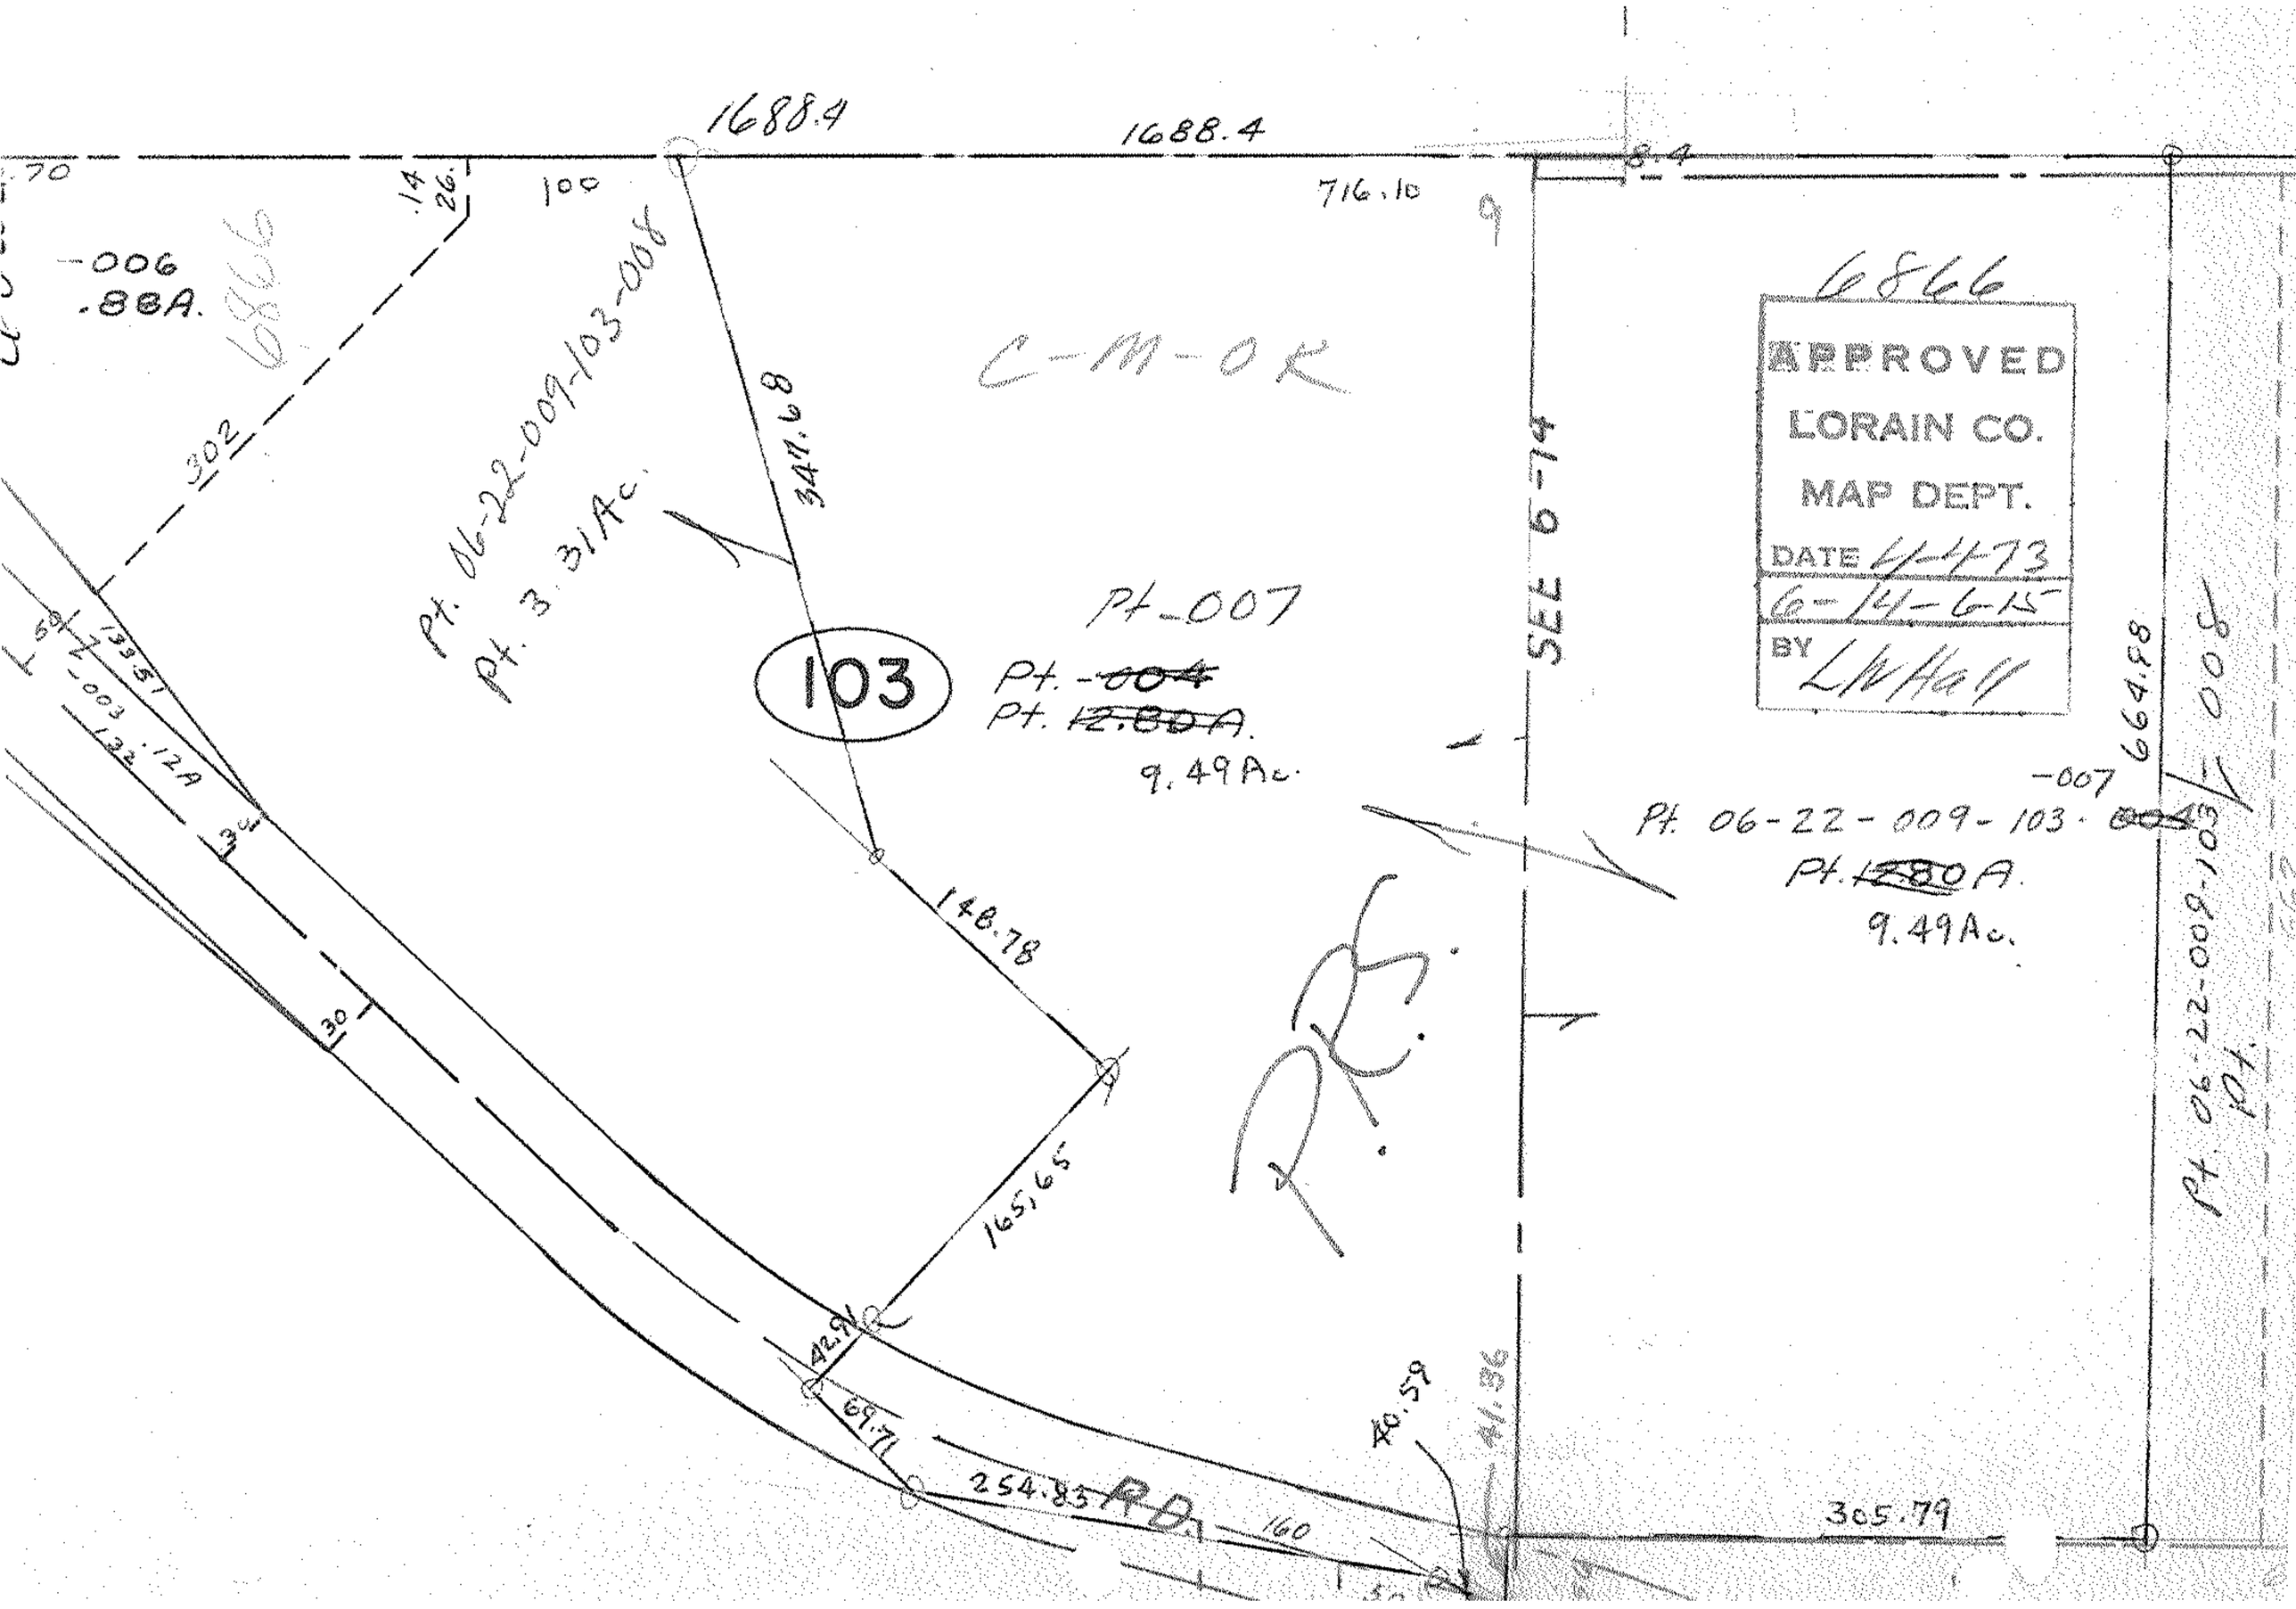
1688.4
1688.4
716.10
8.4
100
-006
.88A.
6866
302
Pt. 06-22-009-103-008
Pt. 3.31Ac.
347.68
C-M-OK
103
Pt-007
Pt. ~~-004~~
Pt. ~~12.80A.~~
9.49Ac.
SEE 6-14
6866
APPROVED
LORAIN CO.
MAP DEPT.
DATE 4-4-73
6-14-6-15
BY LWHall
664.88
-007
Pt. 06-22-009-103-~~004~~
Pt. ~~12.80~~A.
9.49Ac.
Pt. 06-22-009-103-008
Pt.
148.78
165.65
42.91
69.71
254.83
R.D.
160
40.59
41.36
305.79
30
30