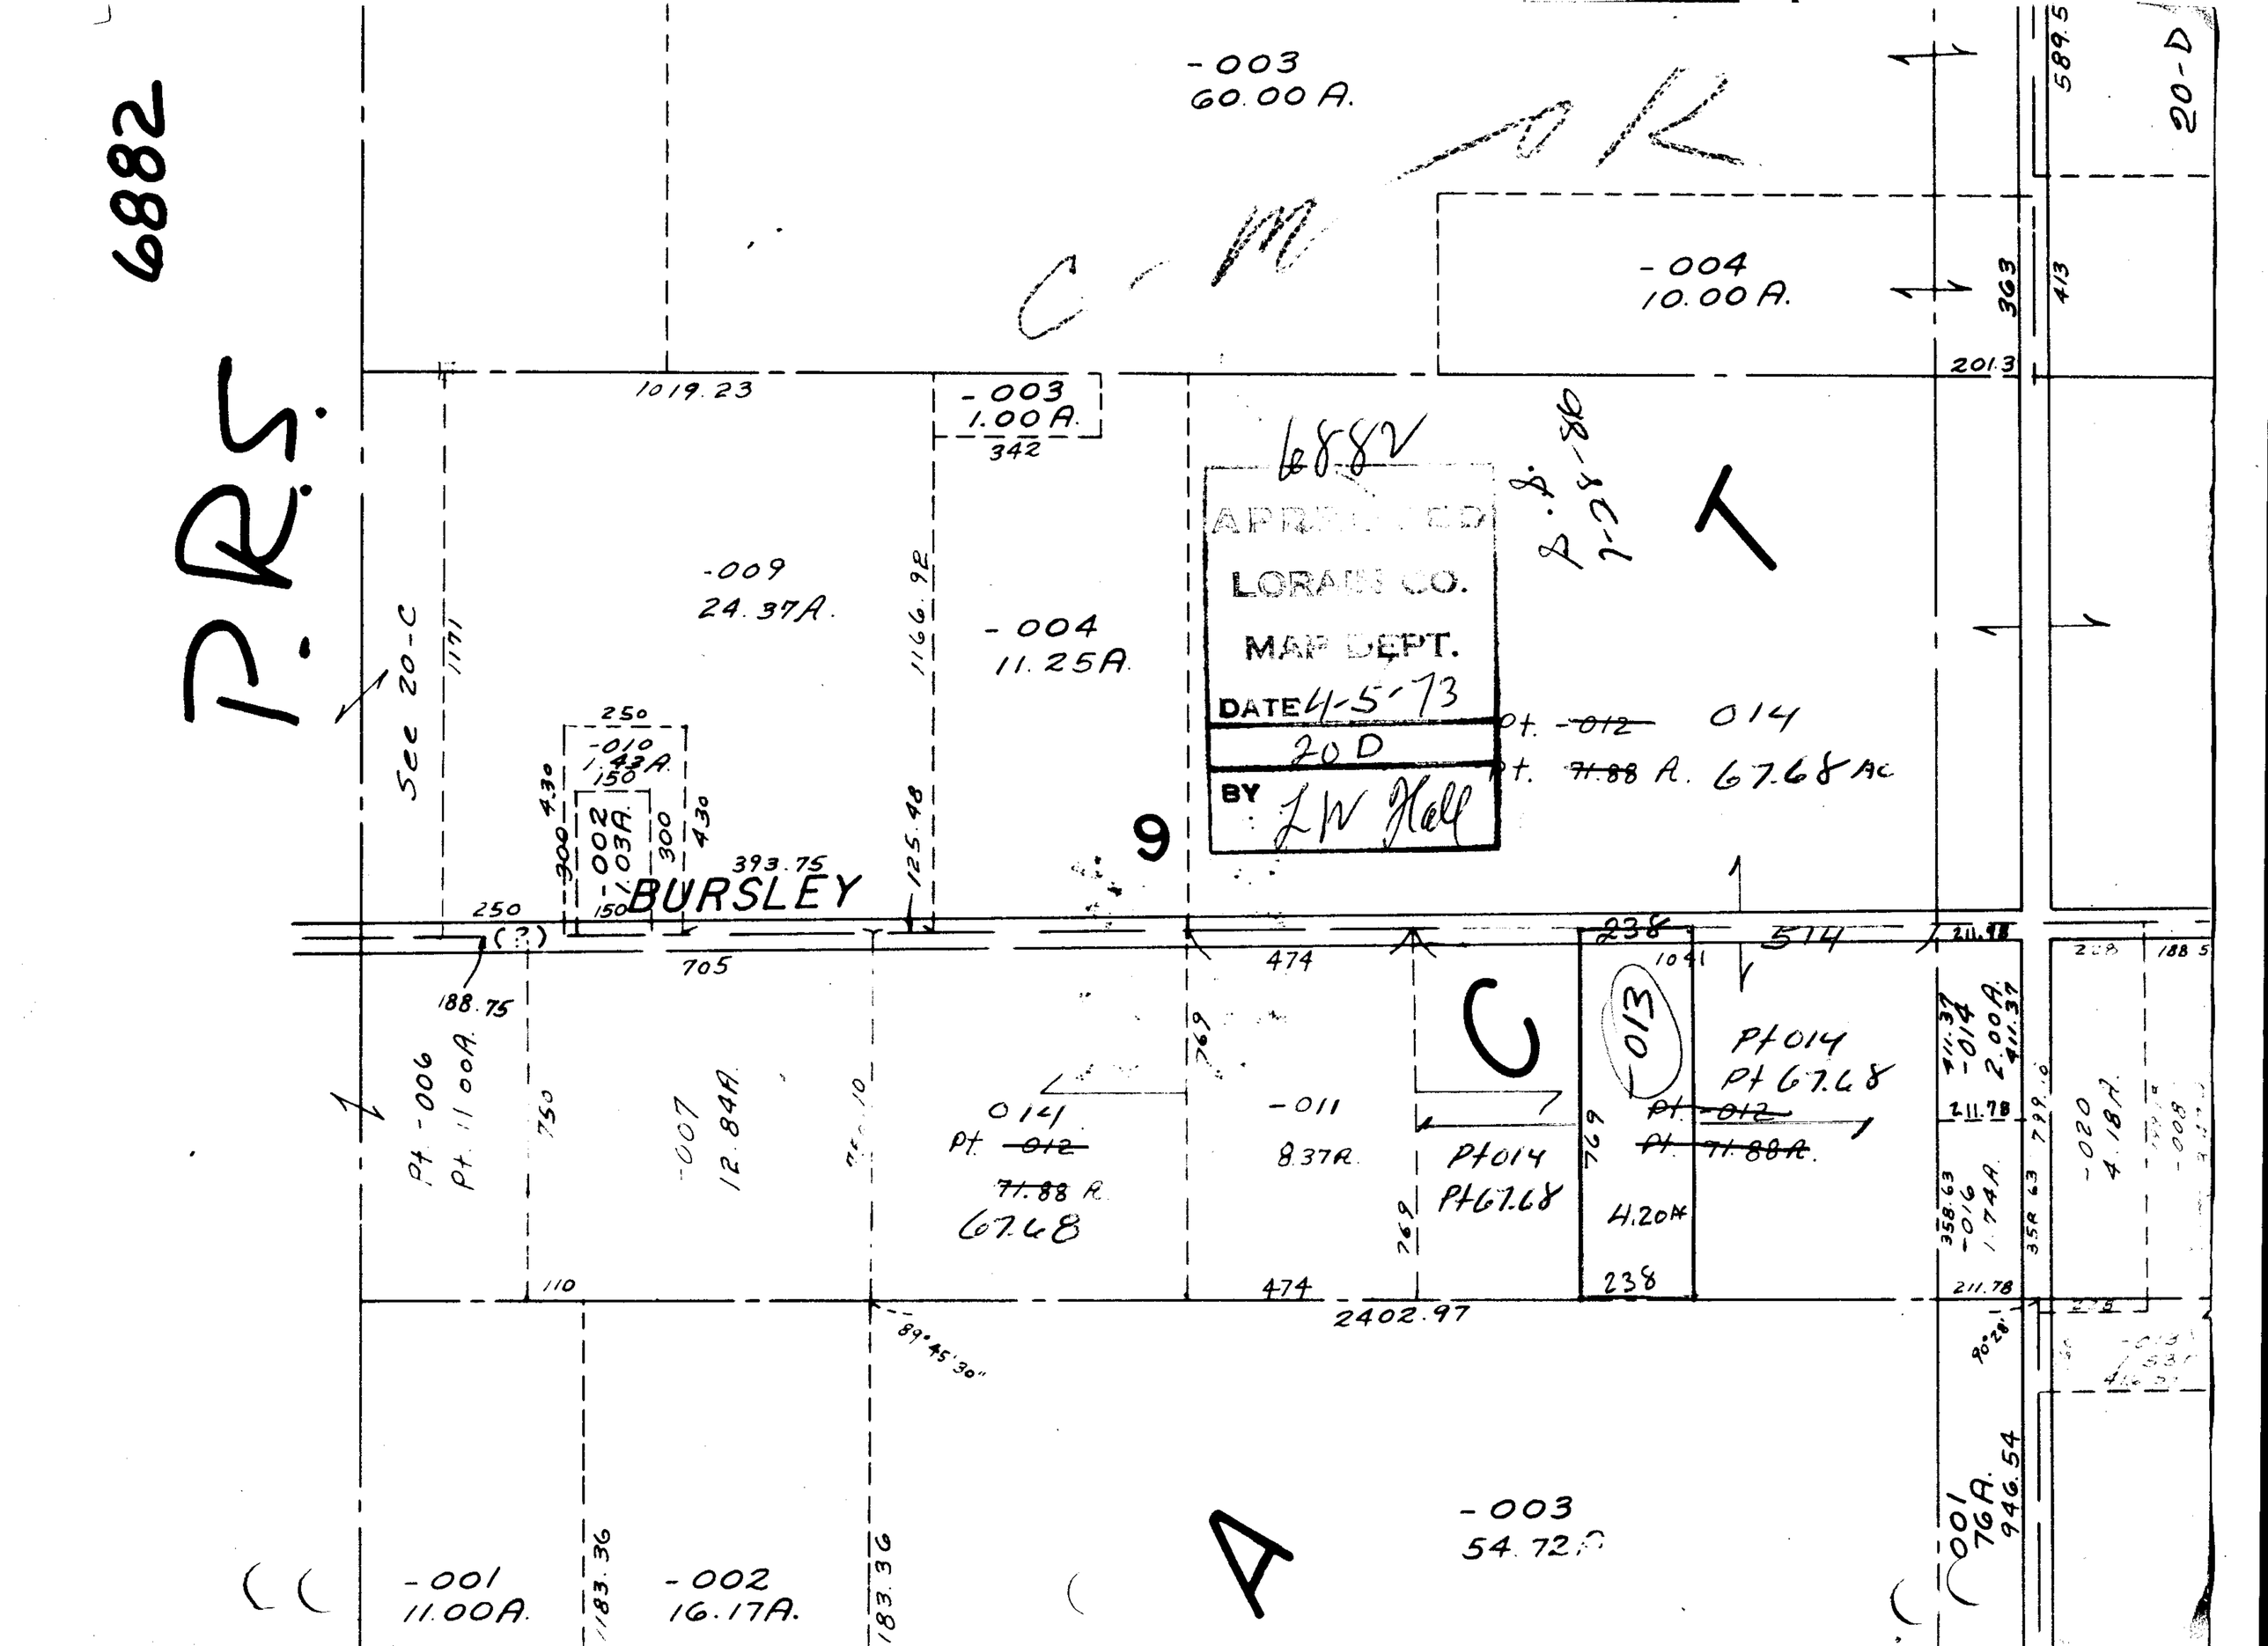
6882
P.R.S.
-003
60.00 A.
-004
10.00 A.
20-D
589.5
363
413
201.3
1019.23
-003
1.00 A.
342
6882
APPROVED
LORAIN CO.
MAP DEPT.
DATE 4-5-73
20 D
BY LW Hall
-009
24.37A.
-004
11.25A.
1166.92
See 20-C
1171
250
-010
1.43A.
150
430
300
-002
1.03A.
393.75
BURSLEY
125.48
9
Pt. ~~-012~~ 014
Pt. ~~71.88~~ A. 67.68 AC
250
(?)
188.75
705
474
238
514
1041
211.78
Pt -006
Pt. 11.00A.
750
-007
12.84A.
014
Pt. ~~-012~~
~~71.88~~ A.
67.68
769
-011
8.37A.
Pt014
Pt67.68
C
-013
Pt014
Pt 67.68
~~Pt. -012~~
~~Pt. 71.88A.~~
4.20A
-014
2.00A.
411.37
358.63
-016
1.74A.
-020
4.18A.
110
474
2402.97
89°45'30"
90°28'
-001
11.00A.
1183.36
-002
16.17A.
A
-003
54.72A
001
76A.
946.54