


Pt. ~~032~~
 Pt. ~~54-029~~
 Pt. 034
 Pt. 53.39Ac
 See Also
 05-00-006B →

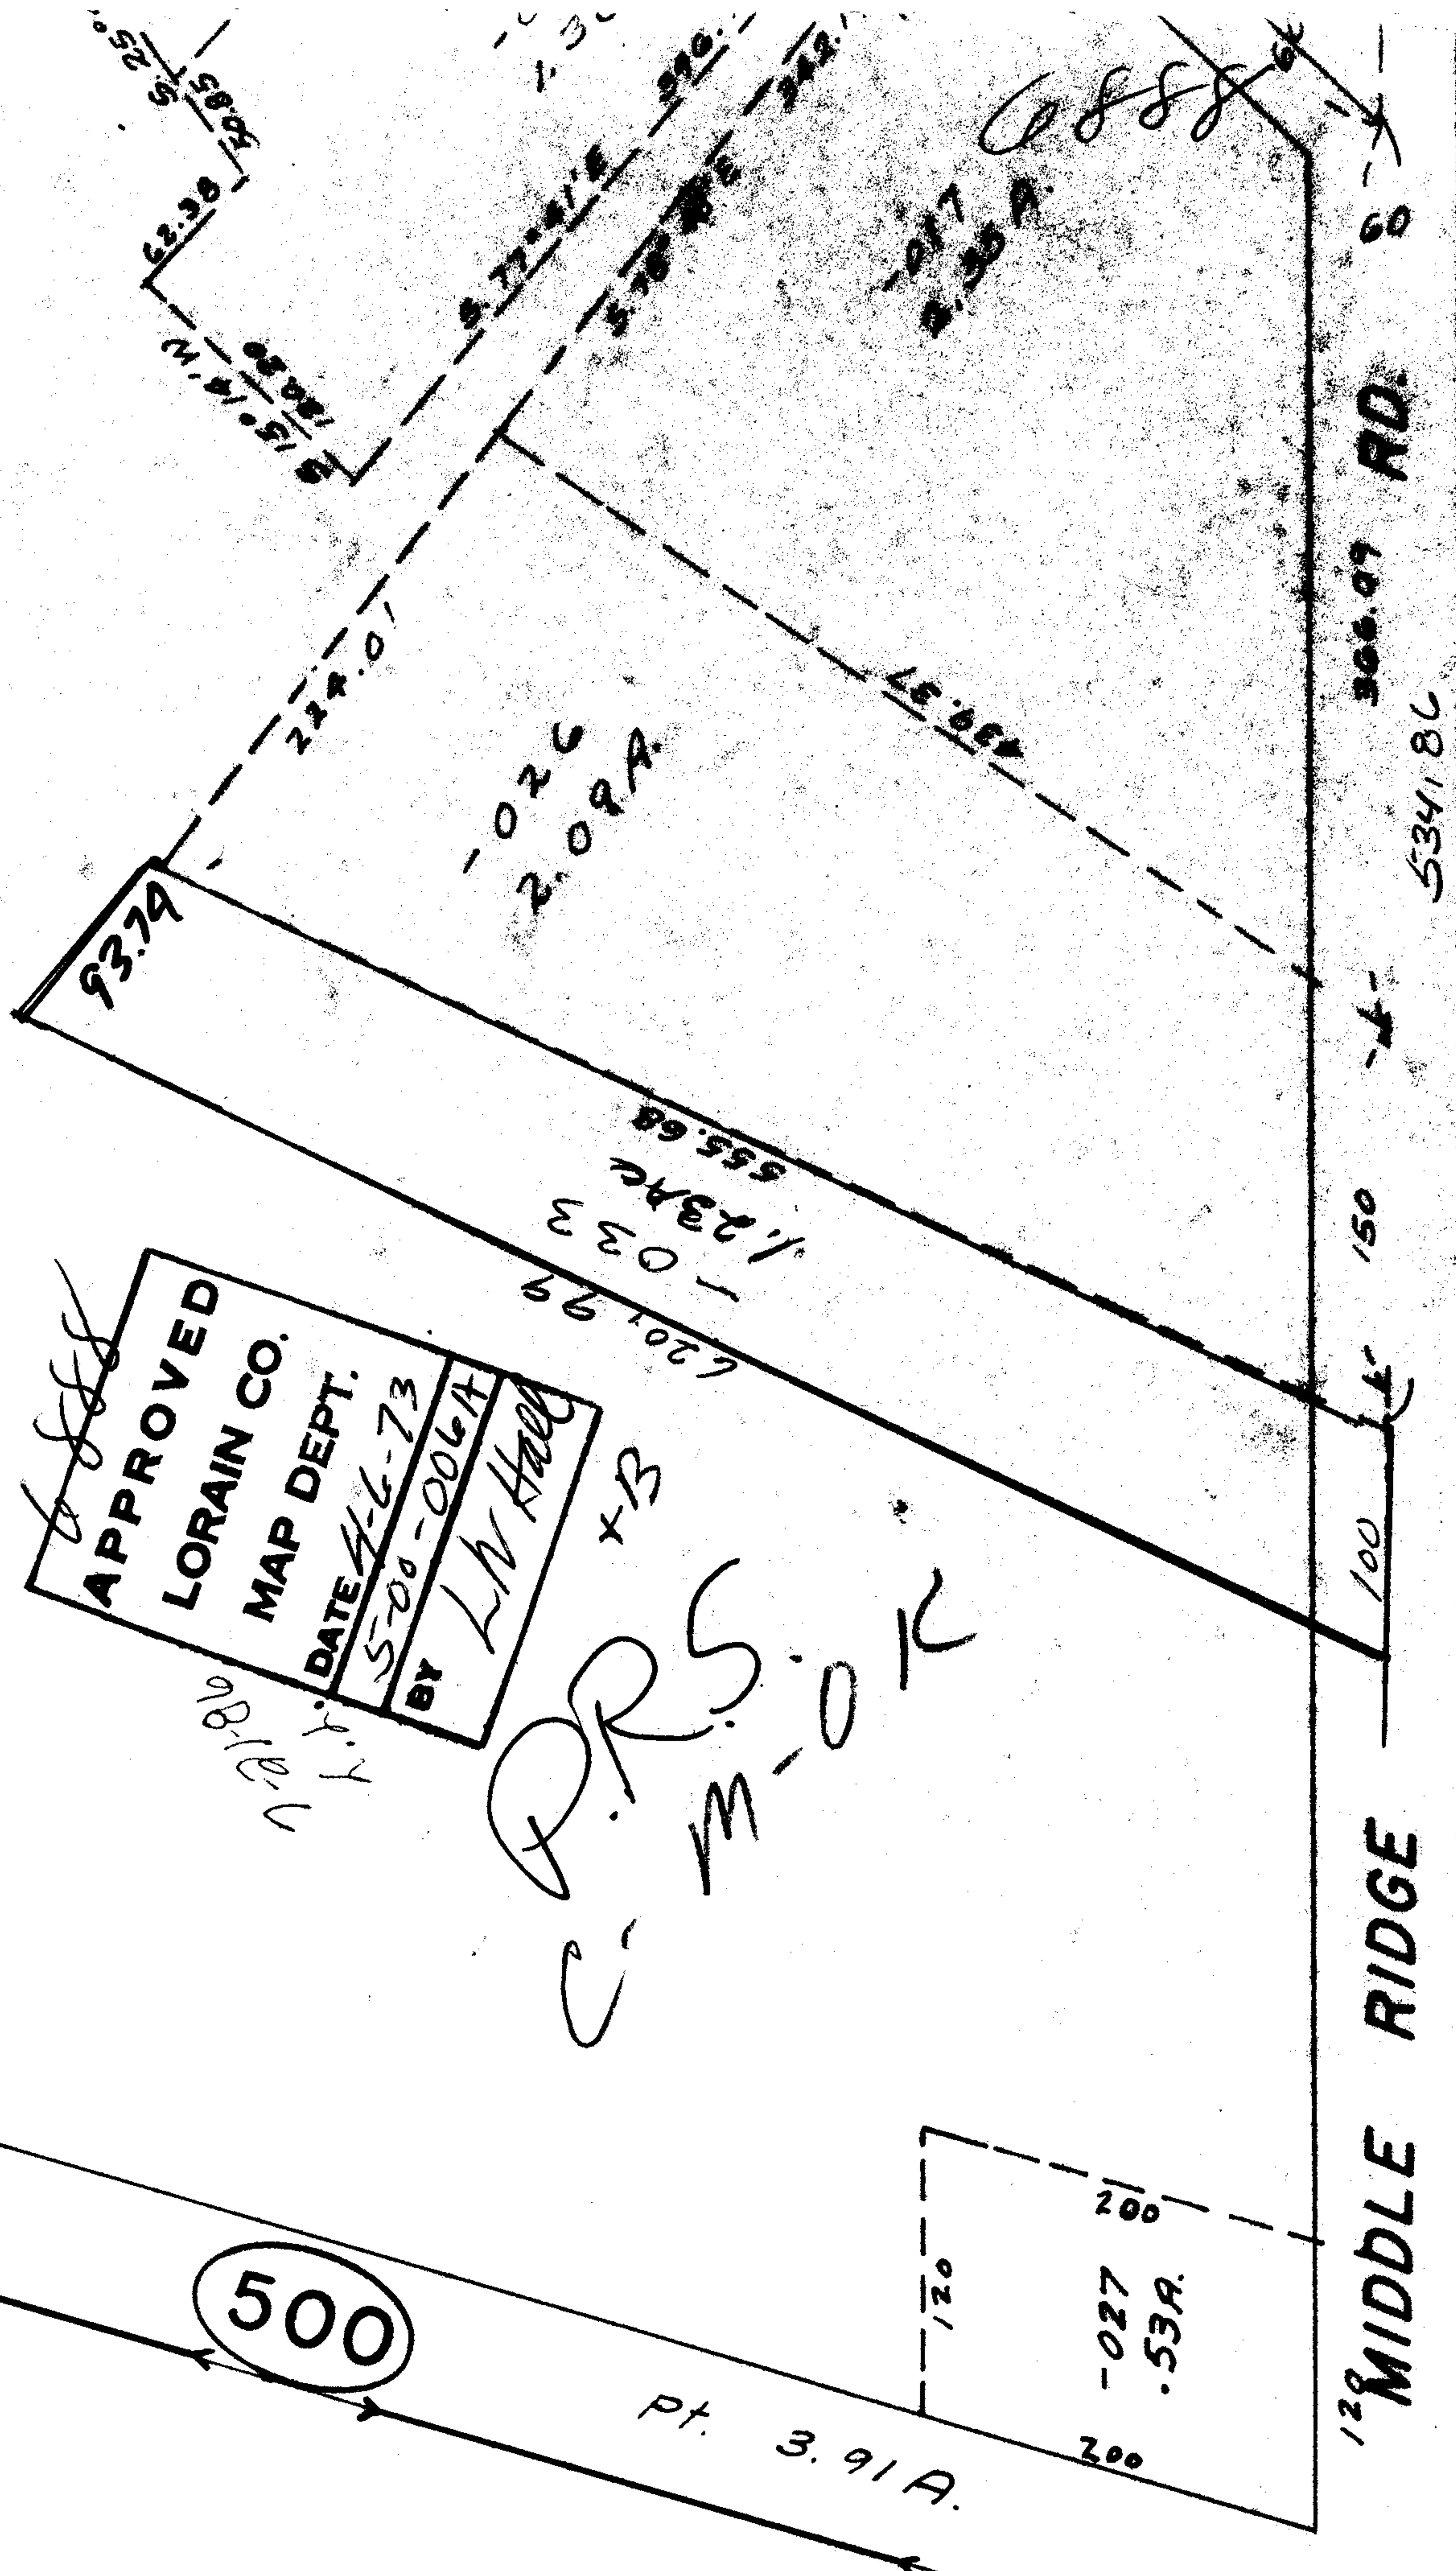

APPROVED
 LORAIN CO.
 MAP DEPT.
 DATE 4-6-73
 BY L.V. Hall

P.R.S.
 M.I.O.K.

500

Pt. -001

Pt. 3.91A