


RR.

C-M-OK

6890  
 APPROVED  
 LORAIN CO.  
 MAP DEPT.  
 DATE 4-9-73  
 10-00-004A  
 BY L.W. Hall

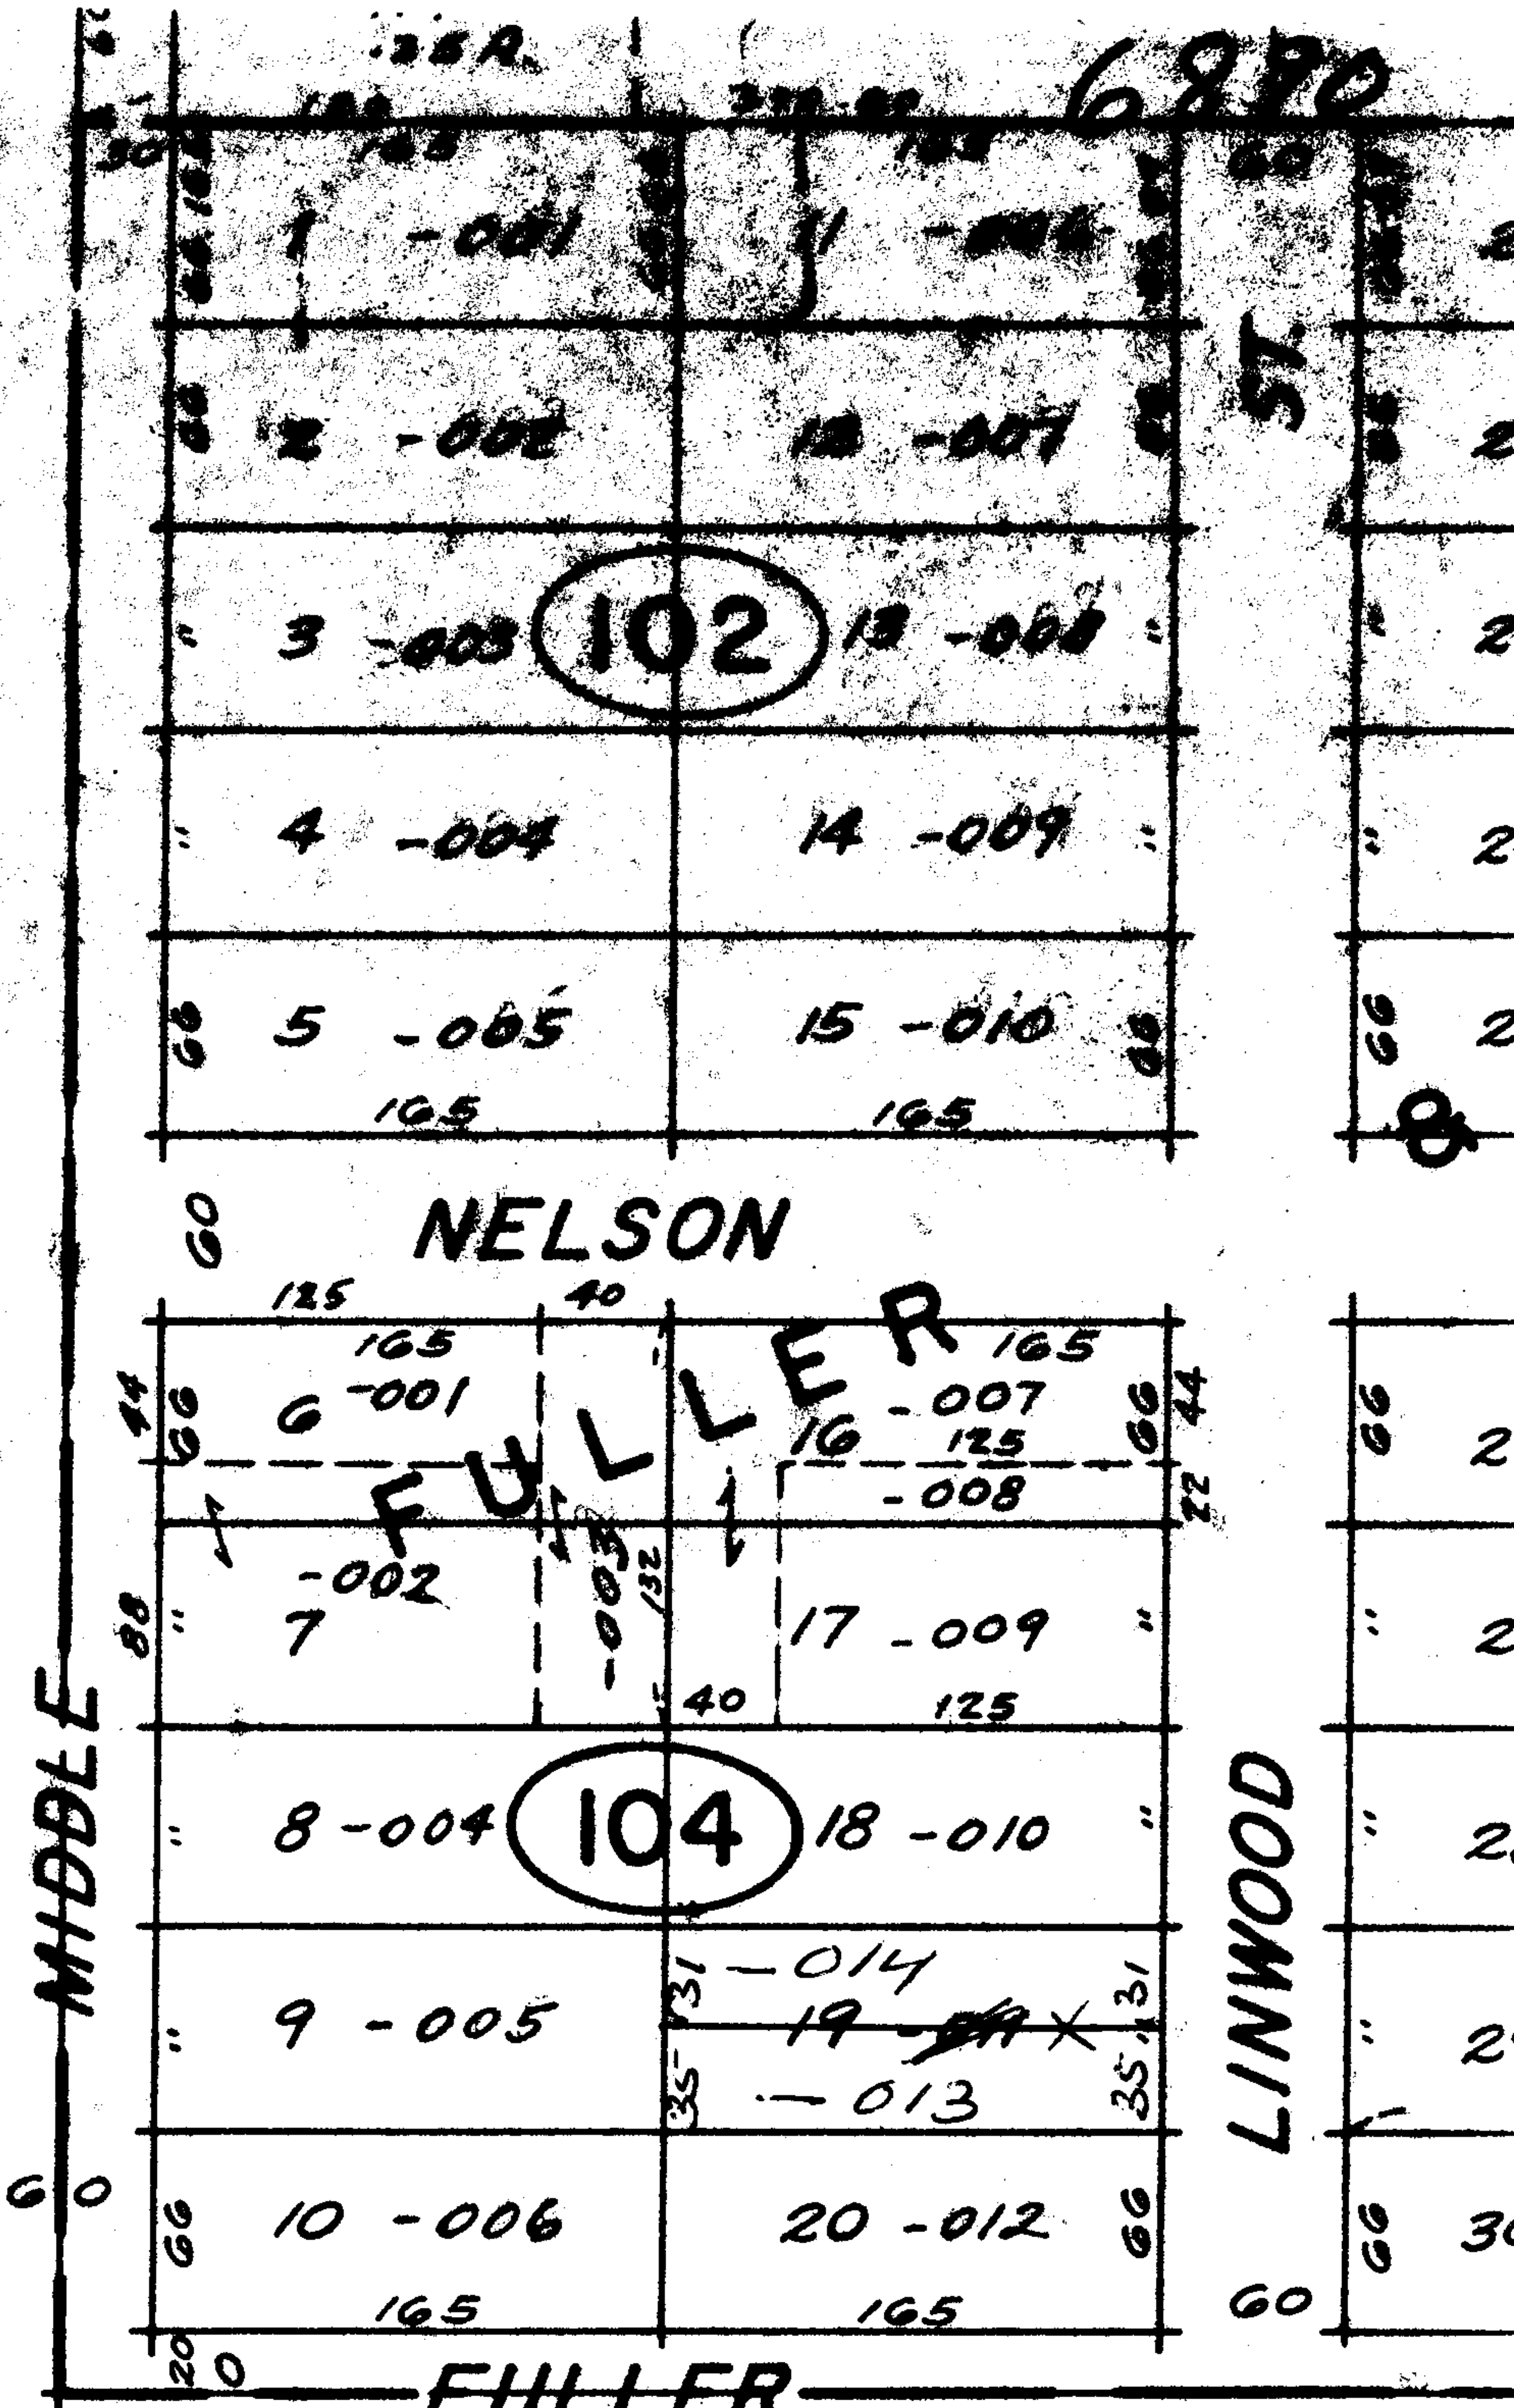

FULLER

S.S.  
7-24-86

Transferred.

4-6-73

CARLISLE T

SCALE: 1" = 100'

004-A