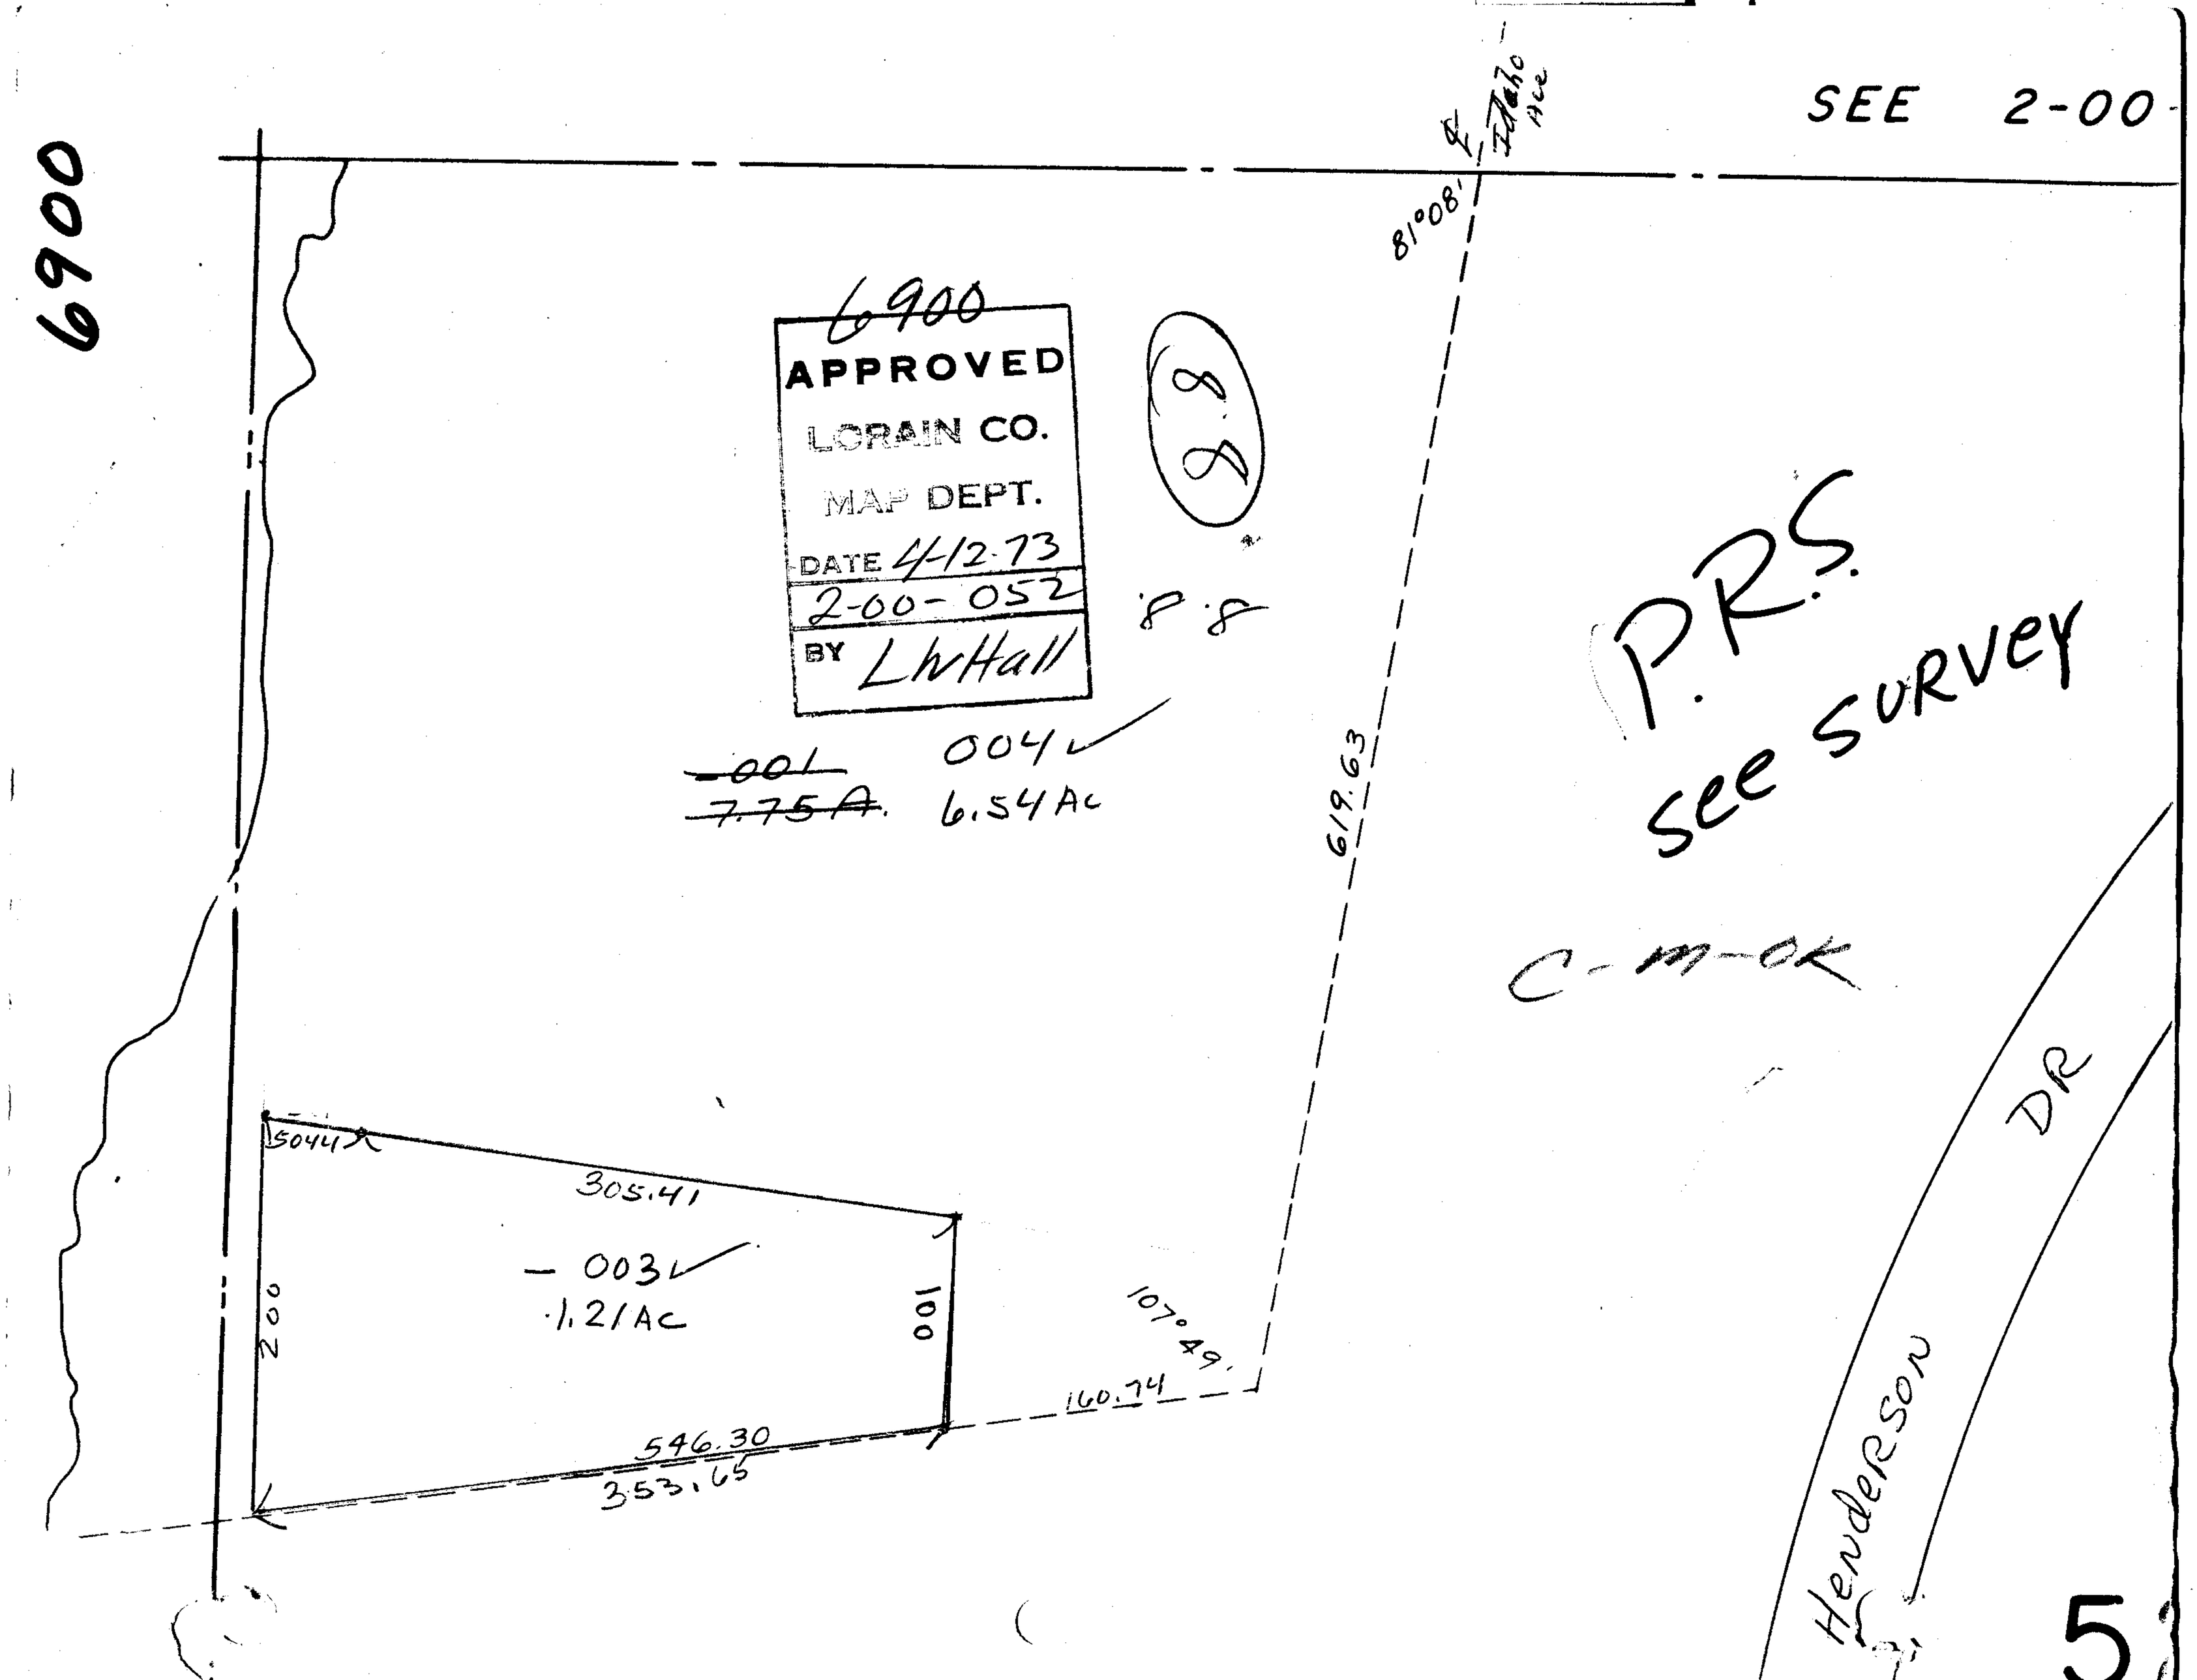

6900
SEE 2-00
Idaho Ave
81°08'
6900
APPROVED
LORAIN CO.
MAP DEPT.
DATE 4-12-73
2-00-052
BY LWHall
8.8
8.8
~~001~~
~~7.75A~~
004
6.54 Ac
619.63
P.R.S.
see survey
C-M-OK
5044
305.41
- 003
1.21 Ac
200
100
107°49'
160.74
546.30
353.65
DR
Henderson