6910

Change
Acres & Number

Pt. ~~-022~~ -024
Pt. ~~45.81A.~~
45.68 Ac.

P.R.S.

C-M-OK

6910

APPROVED
LORAIN CO.
MAP DEPT.
DATE 4-13-73
11-B & 11-00-075 B
BY [signature]

~~45.81~~
13
~~46.68~~
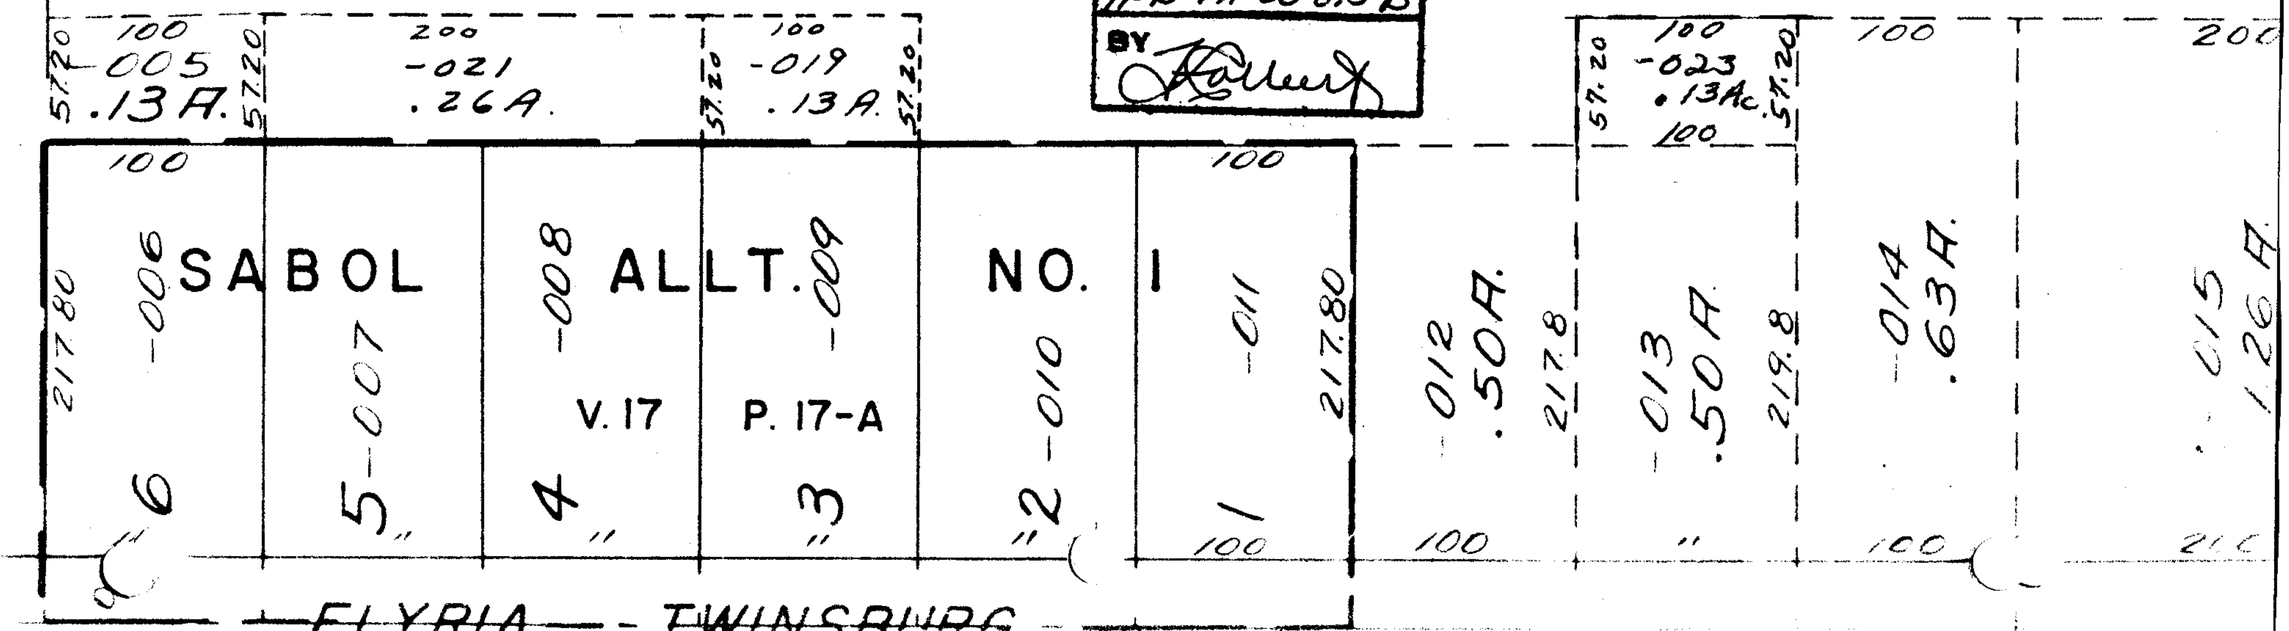
8.8.8-13-73