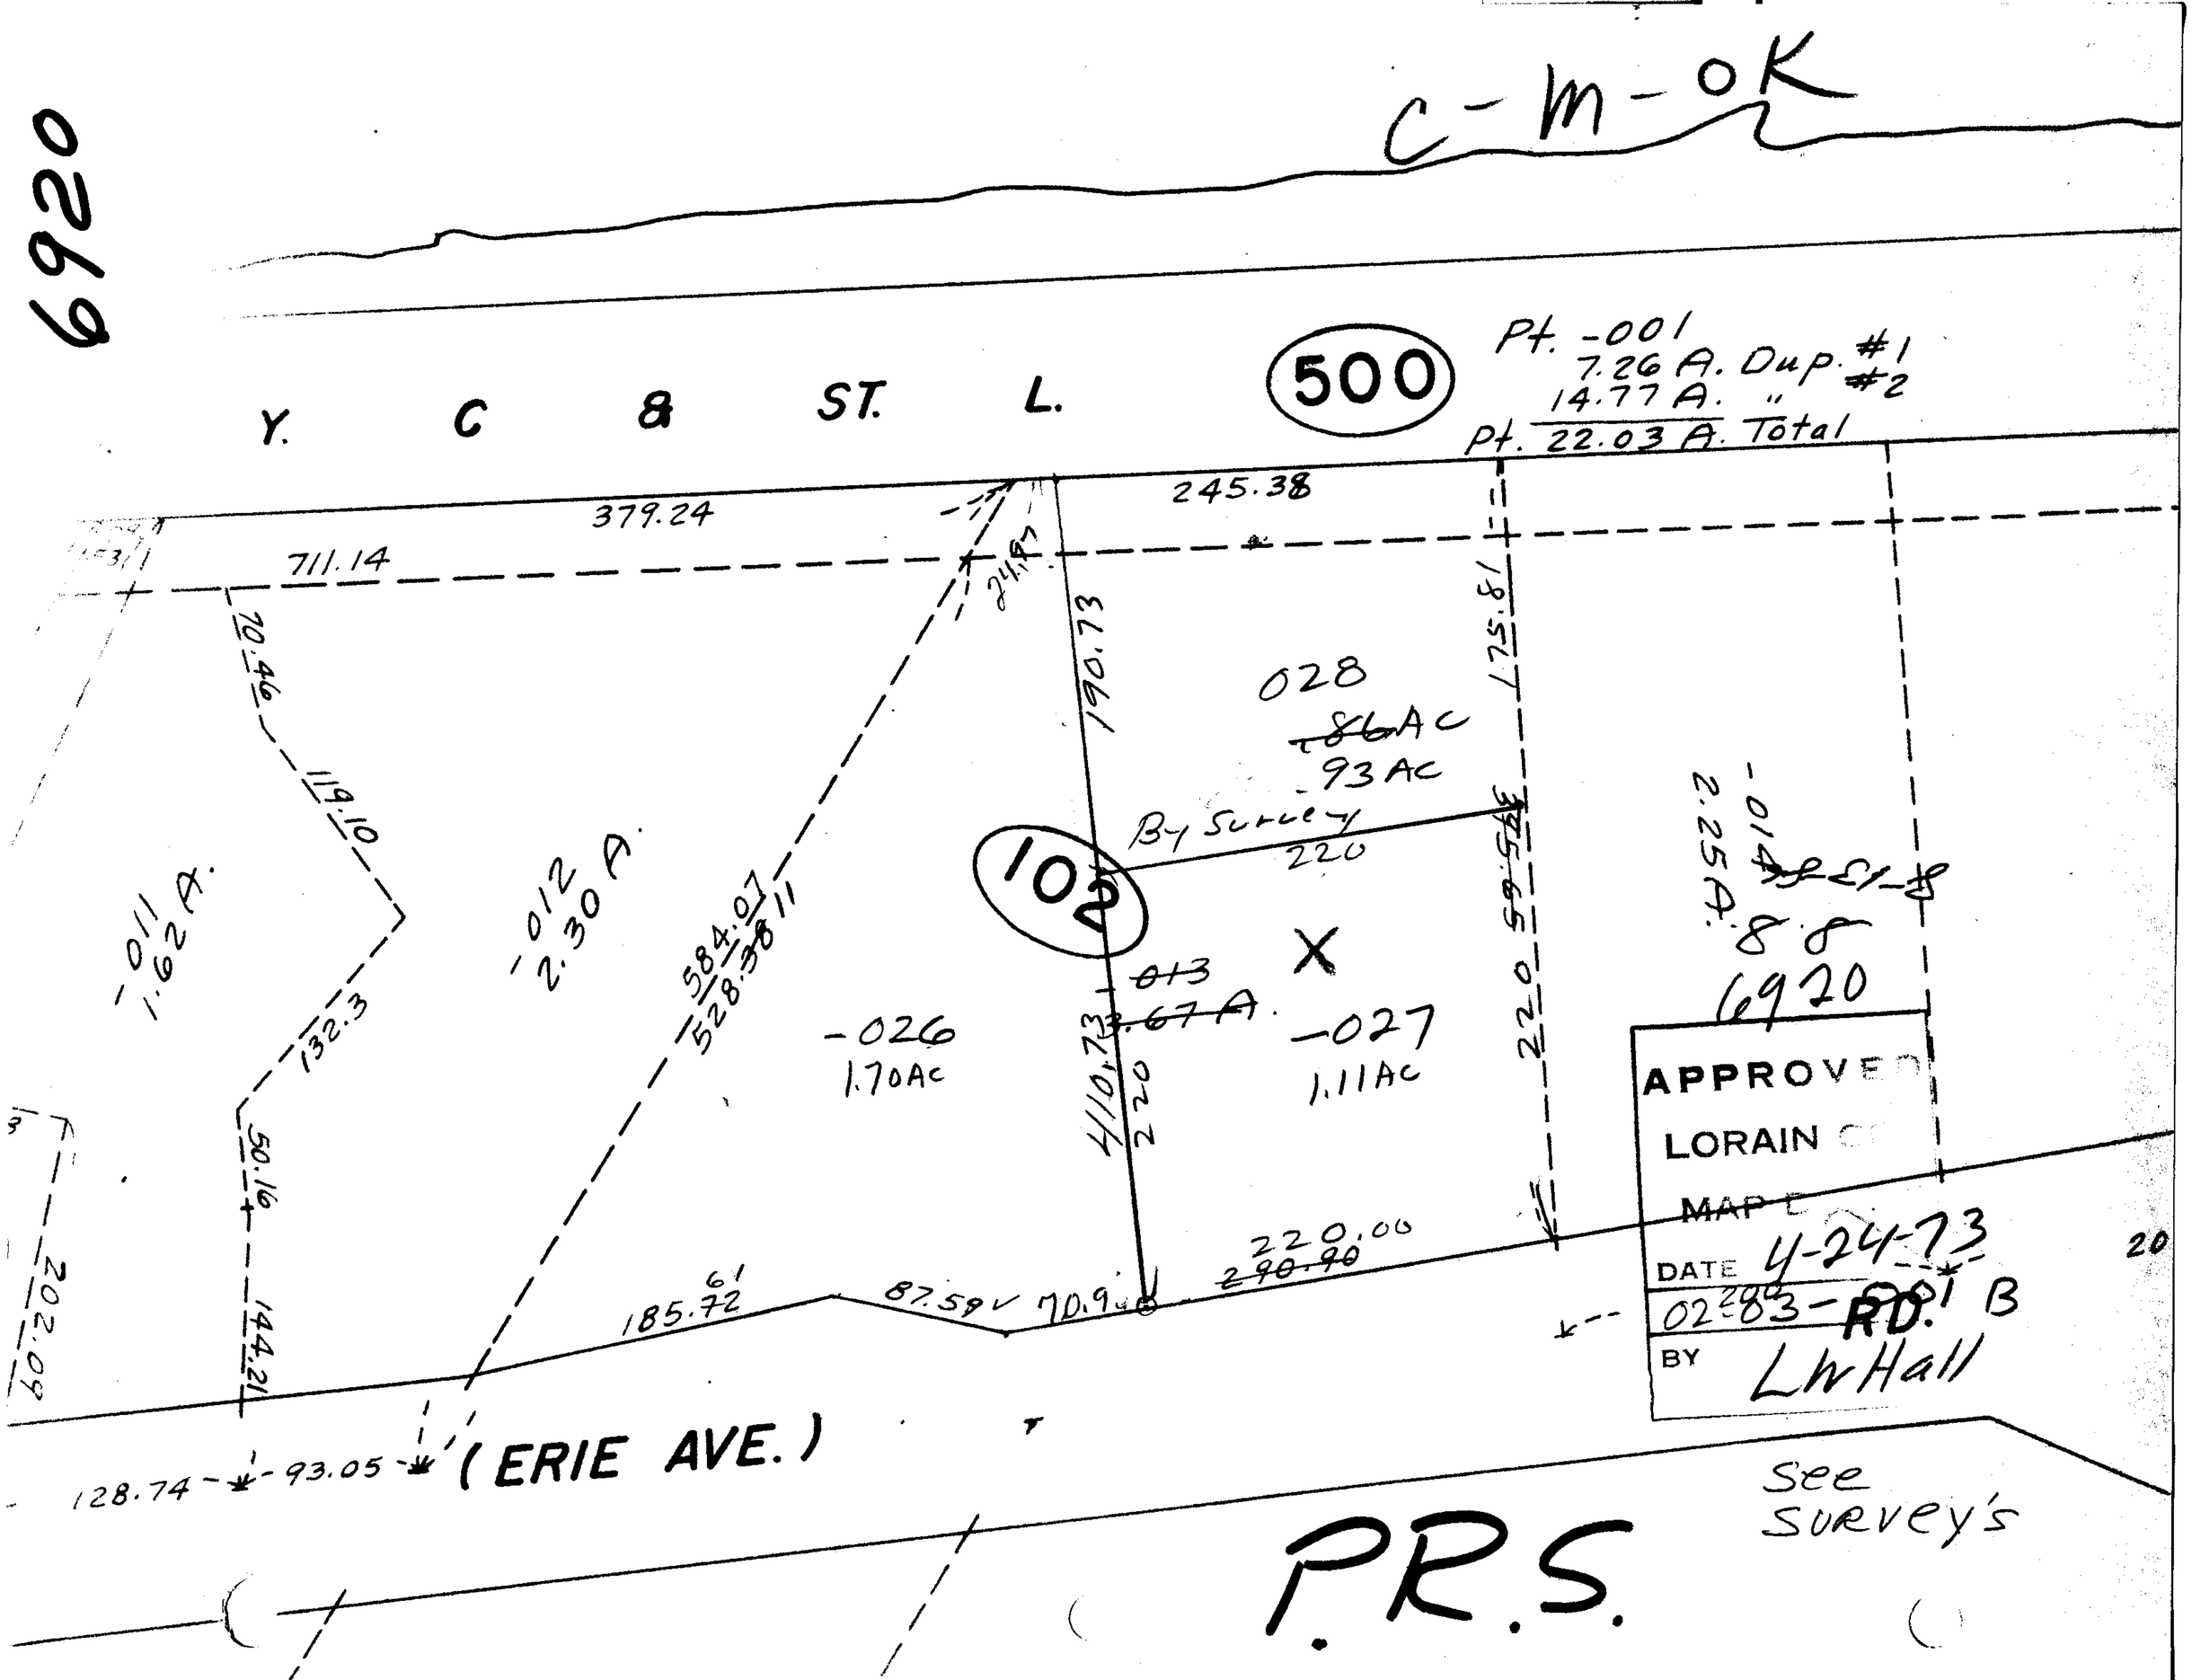

6920
C-M-OK
Y. C & ST. L.
500
Pt. -001
7.26 A. Dup. #1
14.77 A. " #2
Pt. 22.03 A. Total
379.24
245.38
711.14
24.97
190.73
175.81
028
~~.86~~ AC
.93 AC
By Survey
220
102
X
~~.013~~
~~3.67 A.~~
-026
1.70 AC
-027
1.11 AC
410.73
220
220
-011
1.62 A.
-012
2.30 A.
584.07
528.38
11
70.46
119.10
132.3
50.16
144.21
202.09
185.72
61
87.59
70.9
220.00
~~290.90~~
-014
2.25 A.
8.8
6920
APPROVED
LORAIN CO
MAP D
DATE 4-24-73
02-03-001 B
RD.
BY LWHall
20
128.74
93.05
(ERIE AVE.)
See Survey's
P.R.S.