


6922

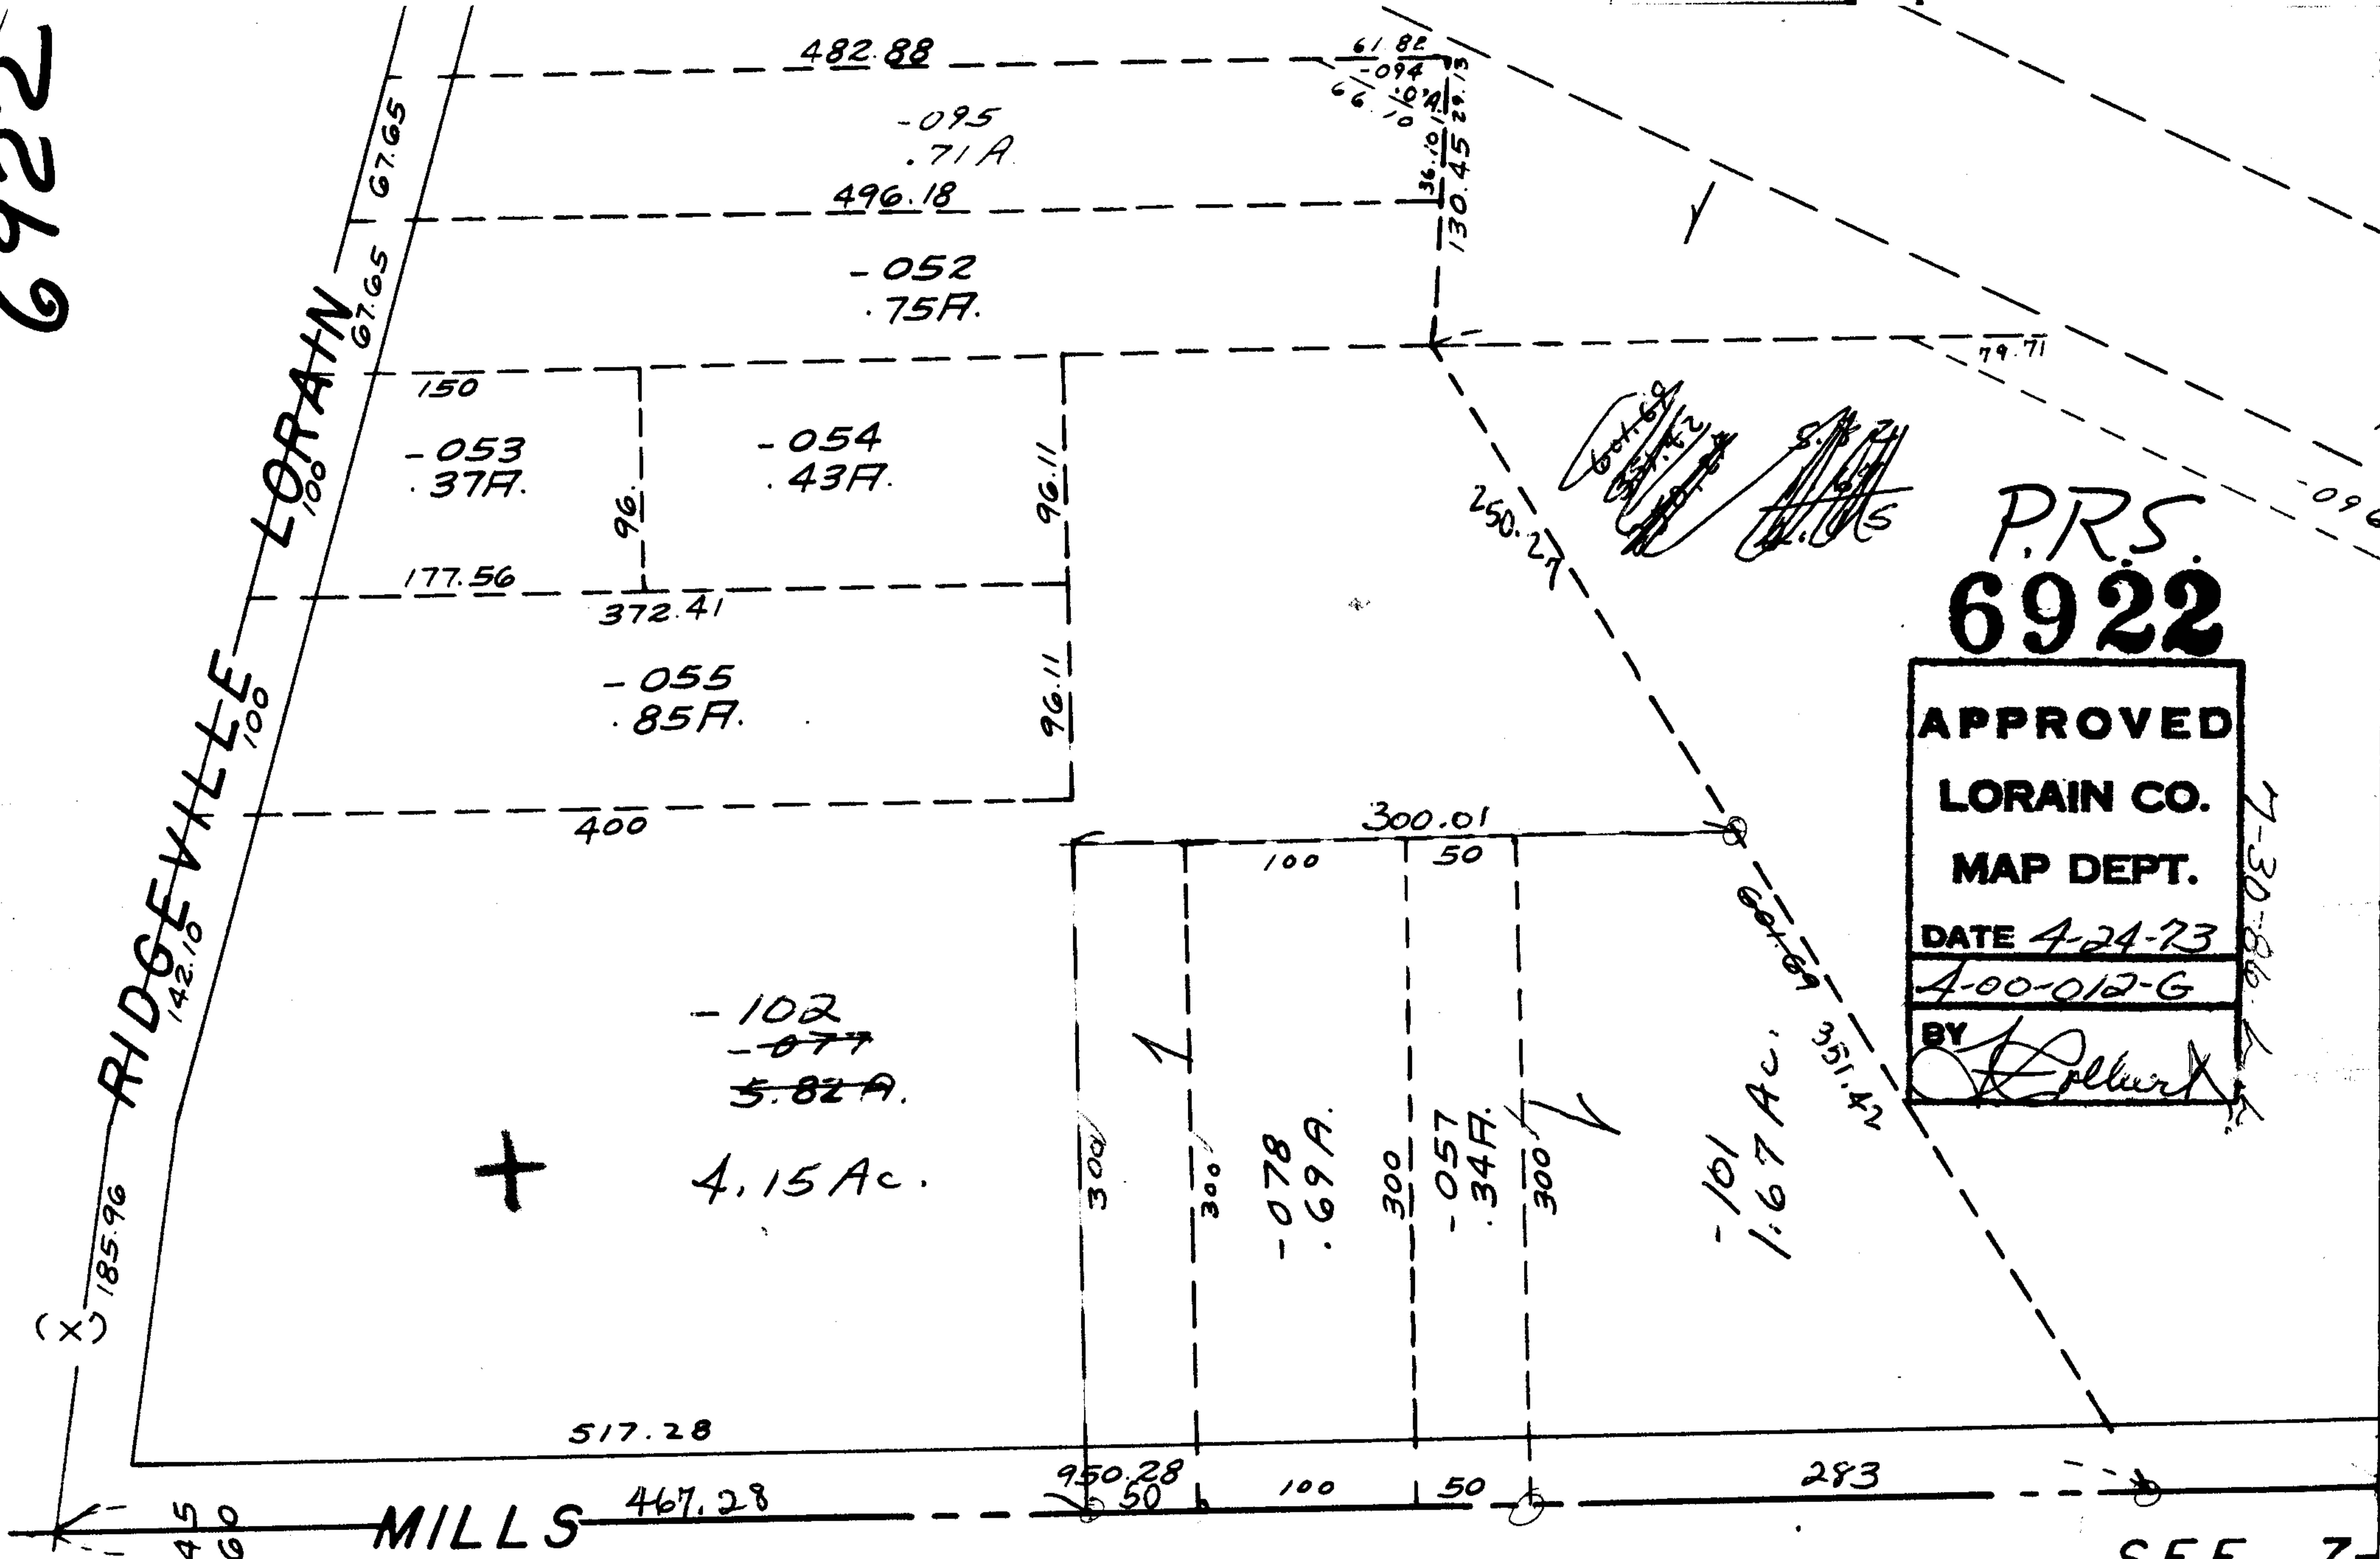

P.R.S.
6922
 APPROVED
 LORAIN CO.
 MAP DEPT.
 DATE 4-24-73
 4-00-012-G
 BY *[Signature]*

7-30-86

C-M-OR

AVON VILLAGE

SEE 7-