


SEE PLAN 075-A

BLVD. 73

P.R.S.

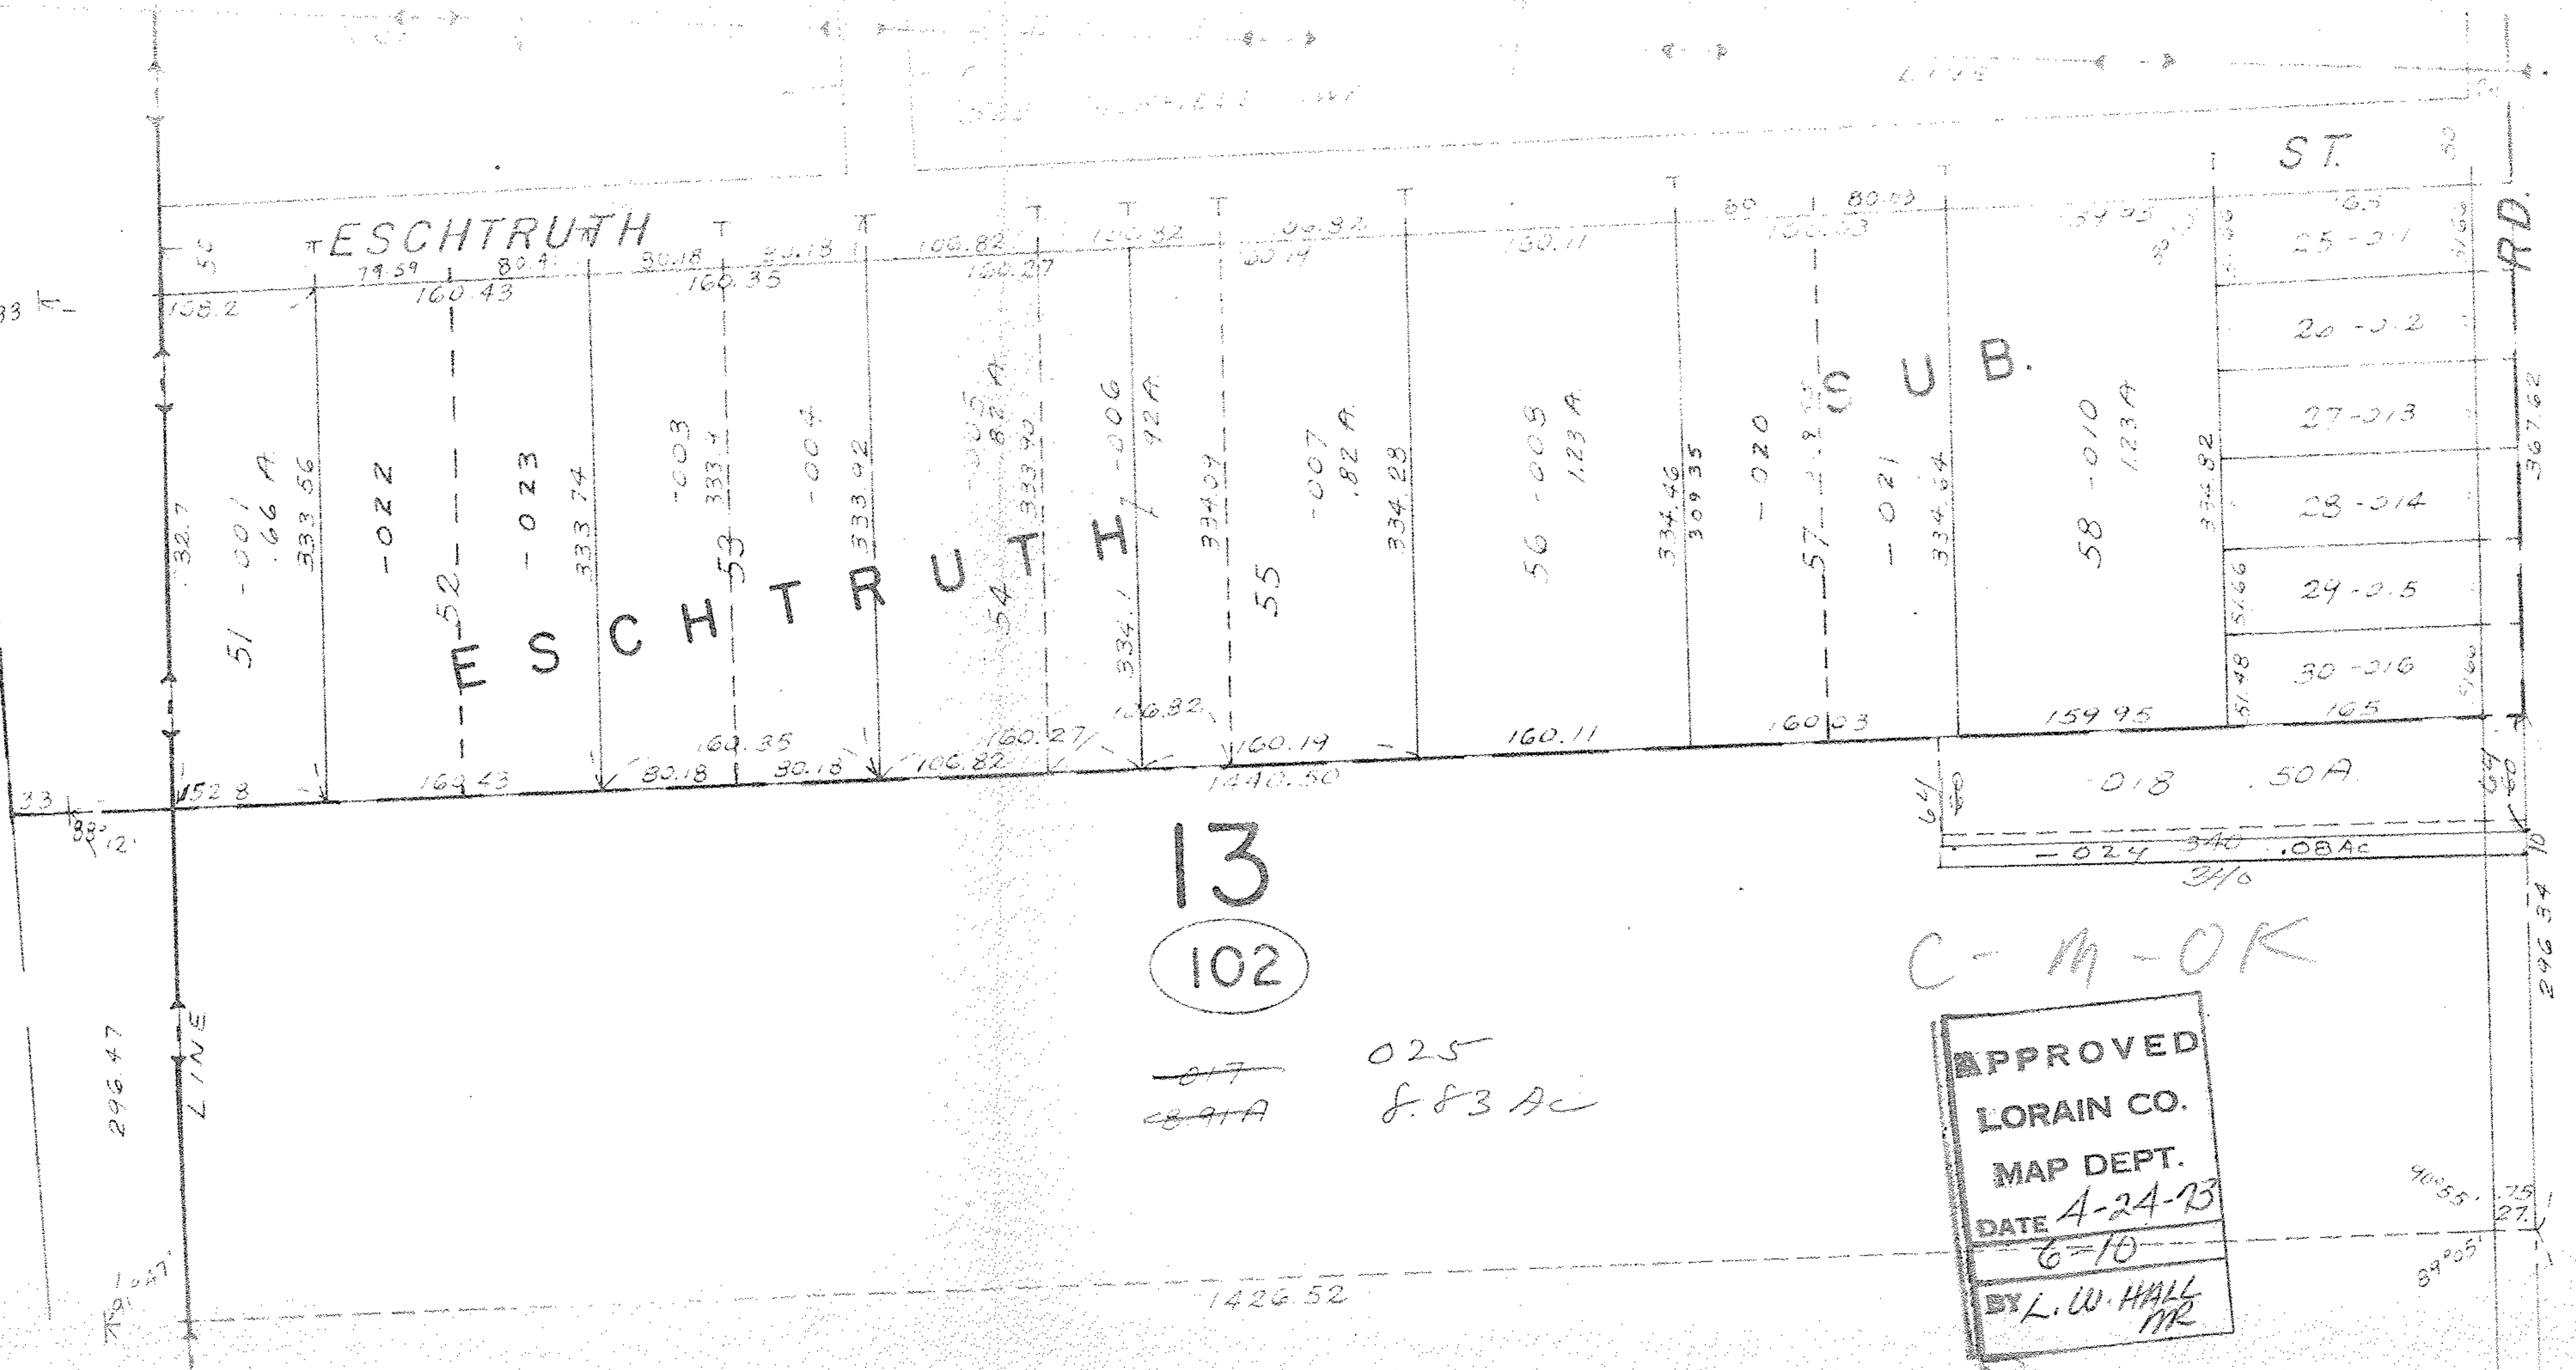

13
102

~~017~~ 025
~~89A~~ f. 83 Ac

C-M-OK

APPROVED
LORAIN CO.
MAP DEPT.
DATE 4-24-73
6-10
BY L.W. HALL
MR

6921