


6927
2/2

106

6927

APPROVED
LORAIN CO.
MAR DEPT.
DATE 4-25-73
BY *[Signature]*

River

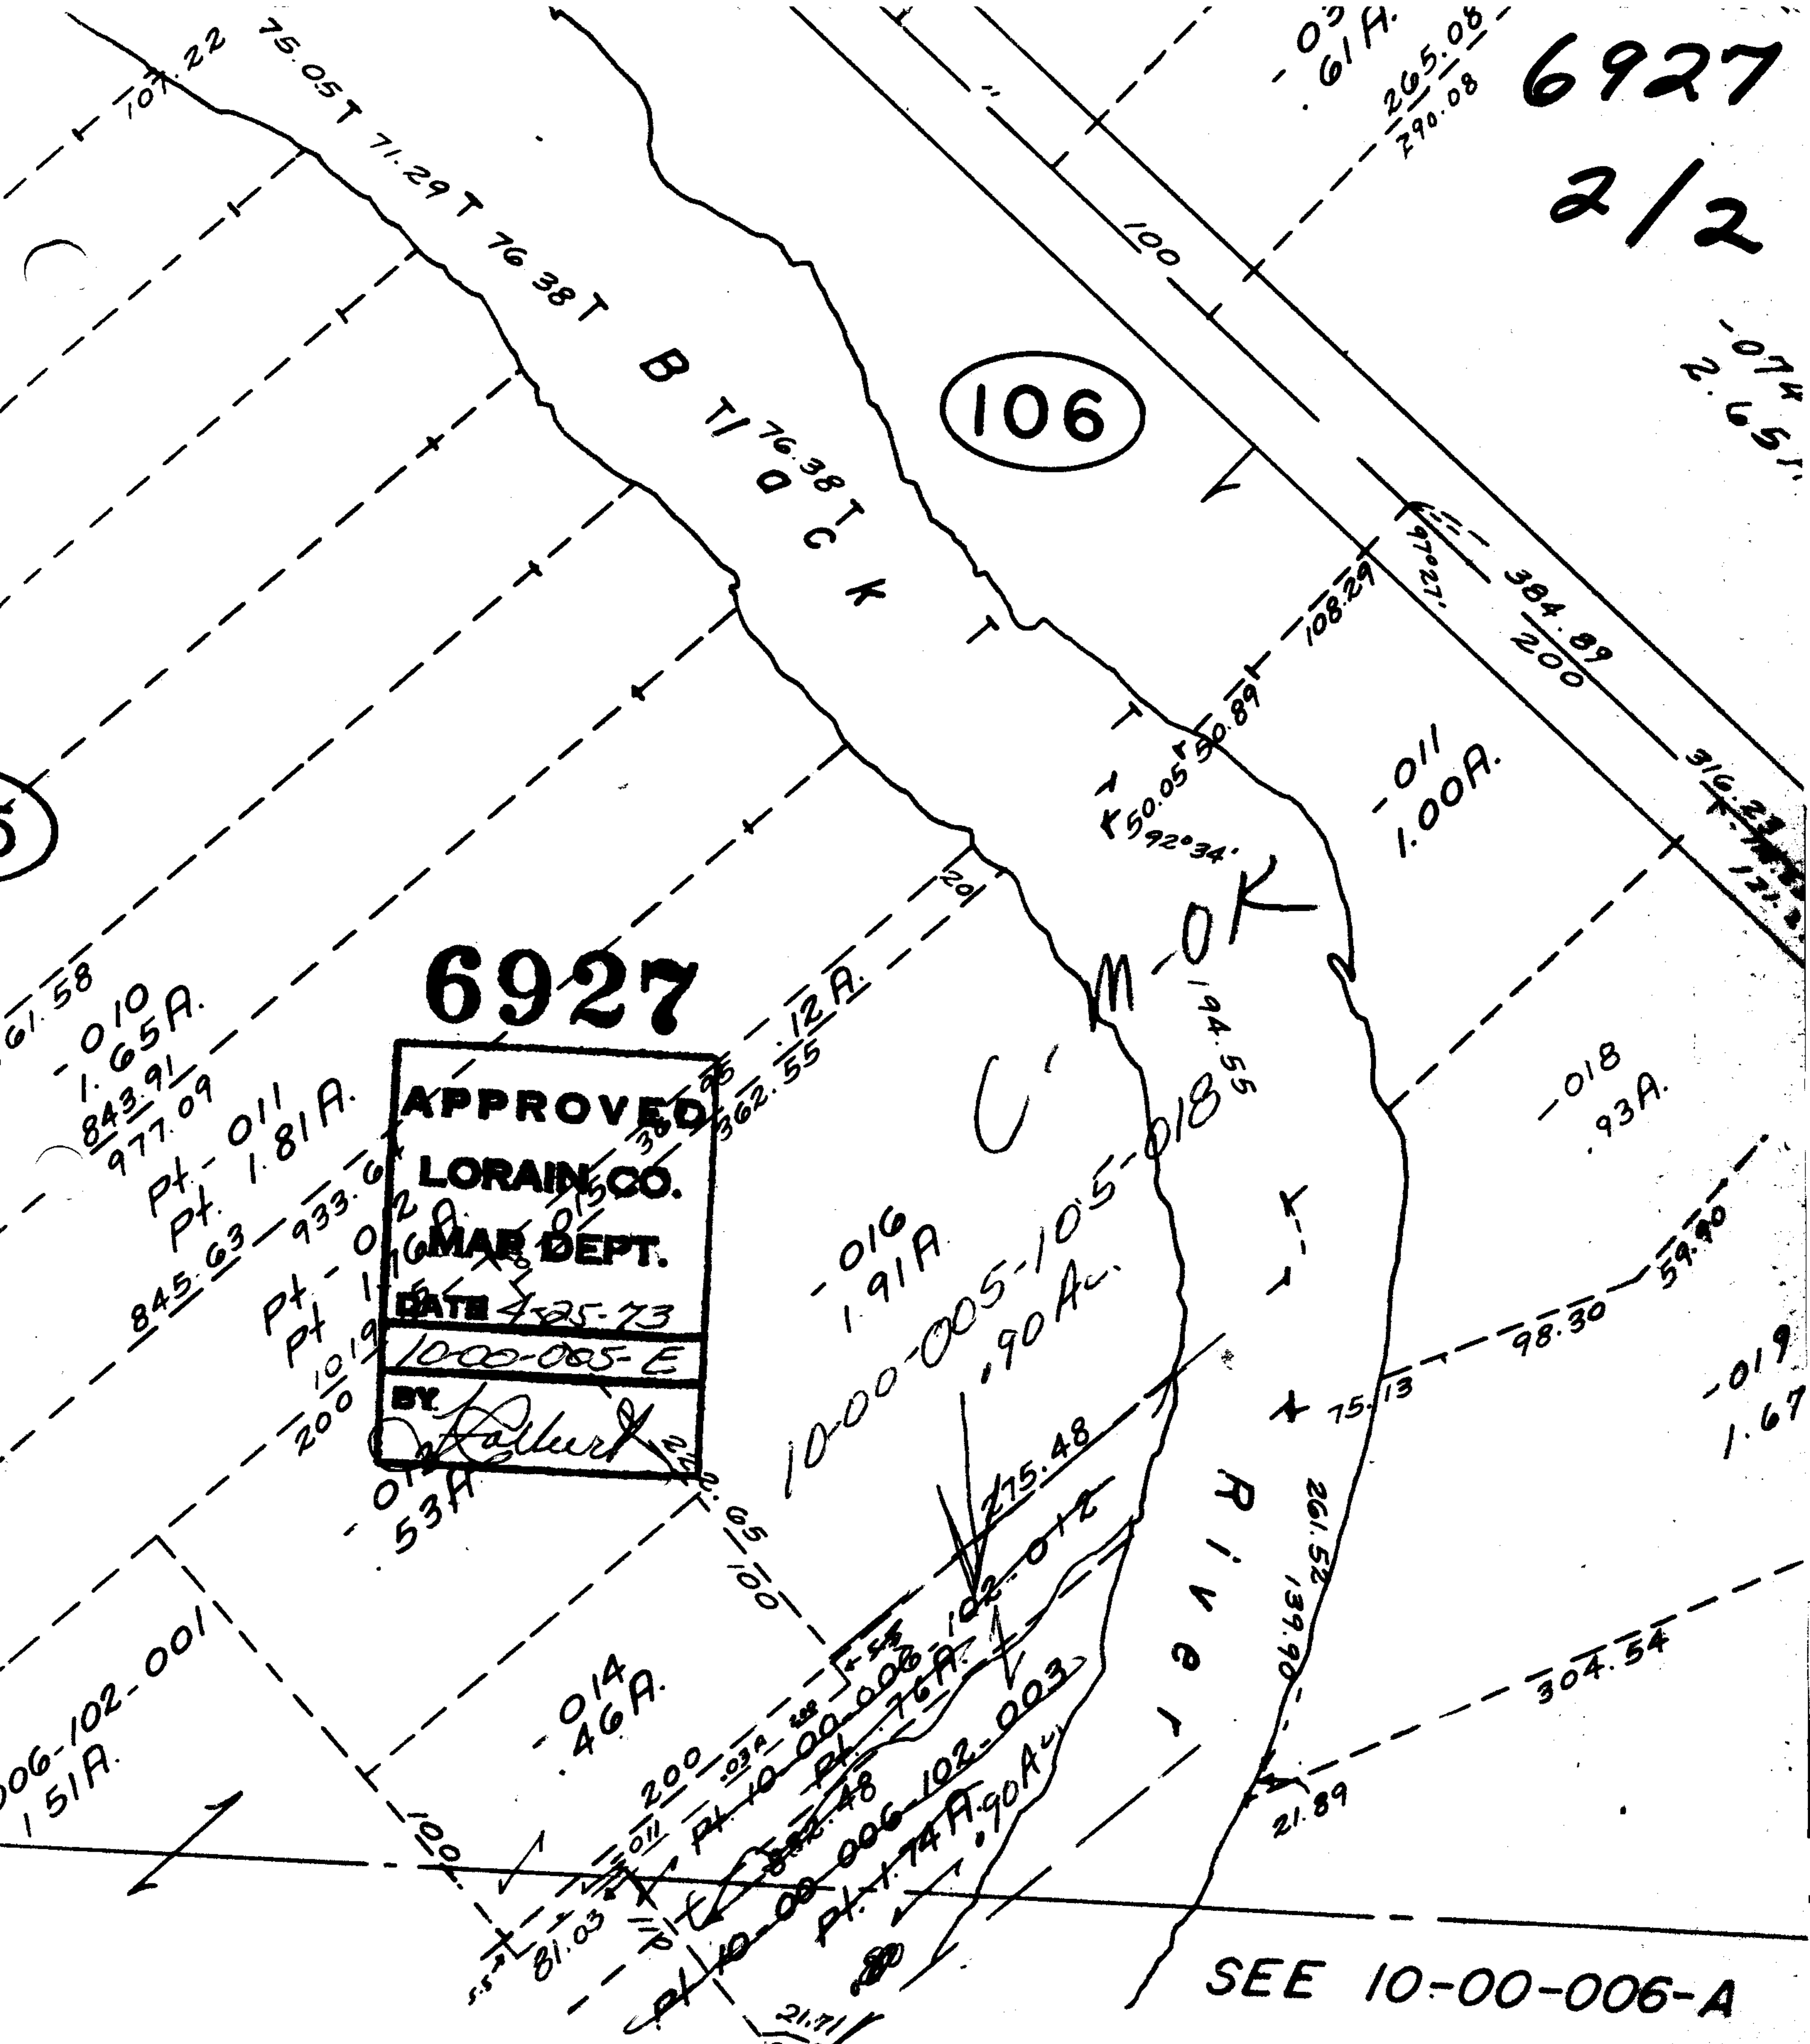

SEE 10-00-006-A

P.R.S.

TWP

174
76
2.50
2.50
1.60
90

W.V. S.W.