


C.M.A. P.D.

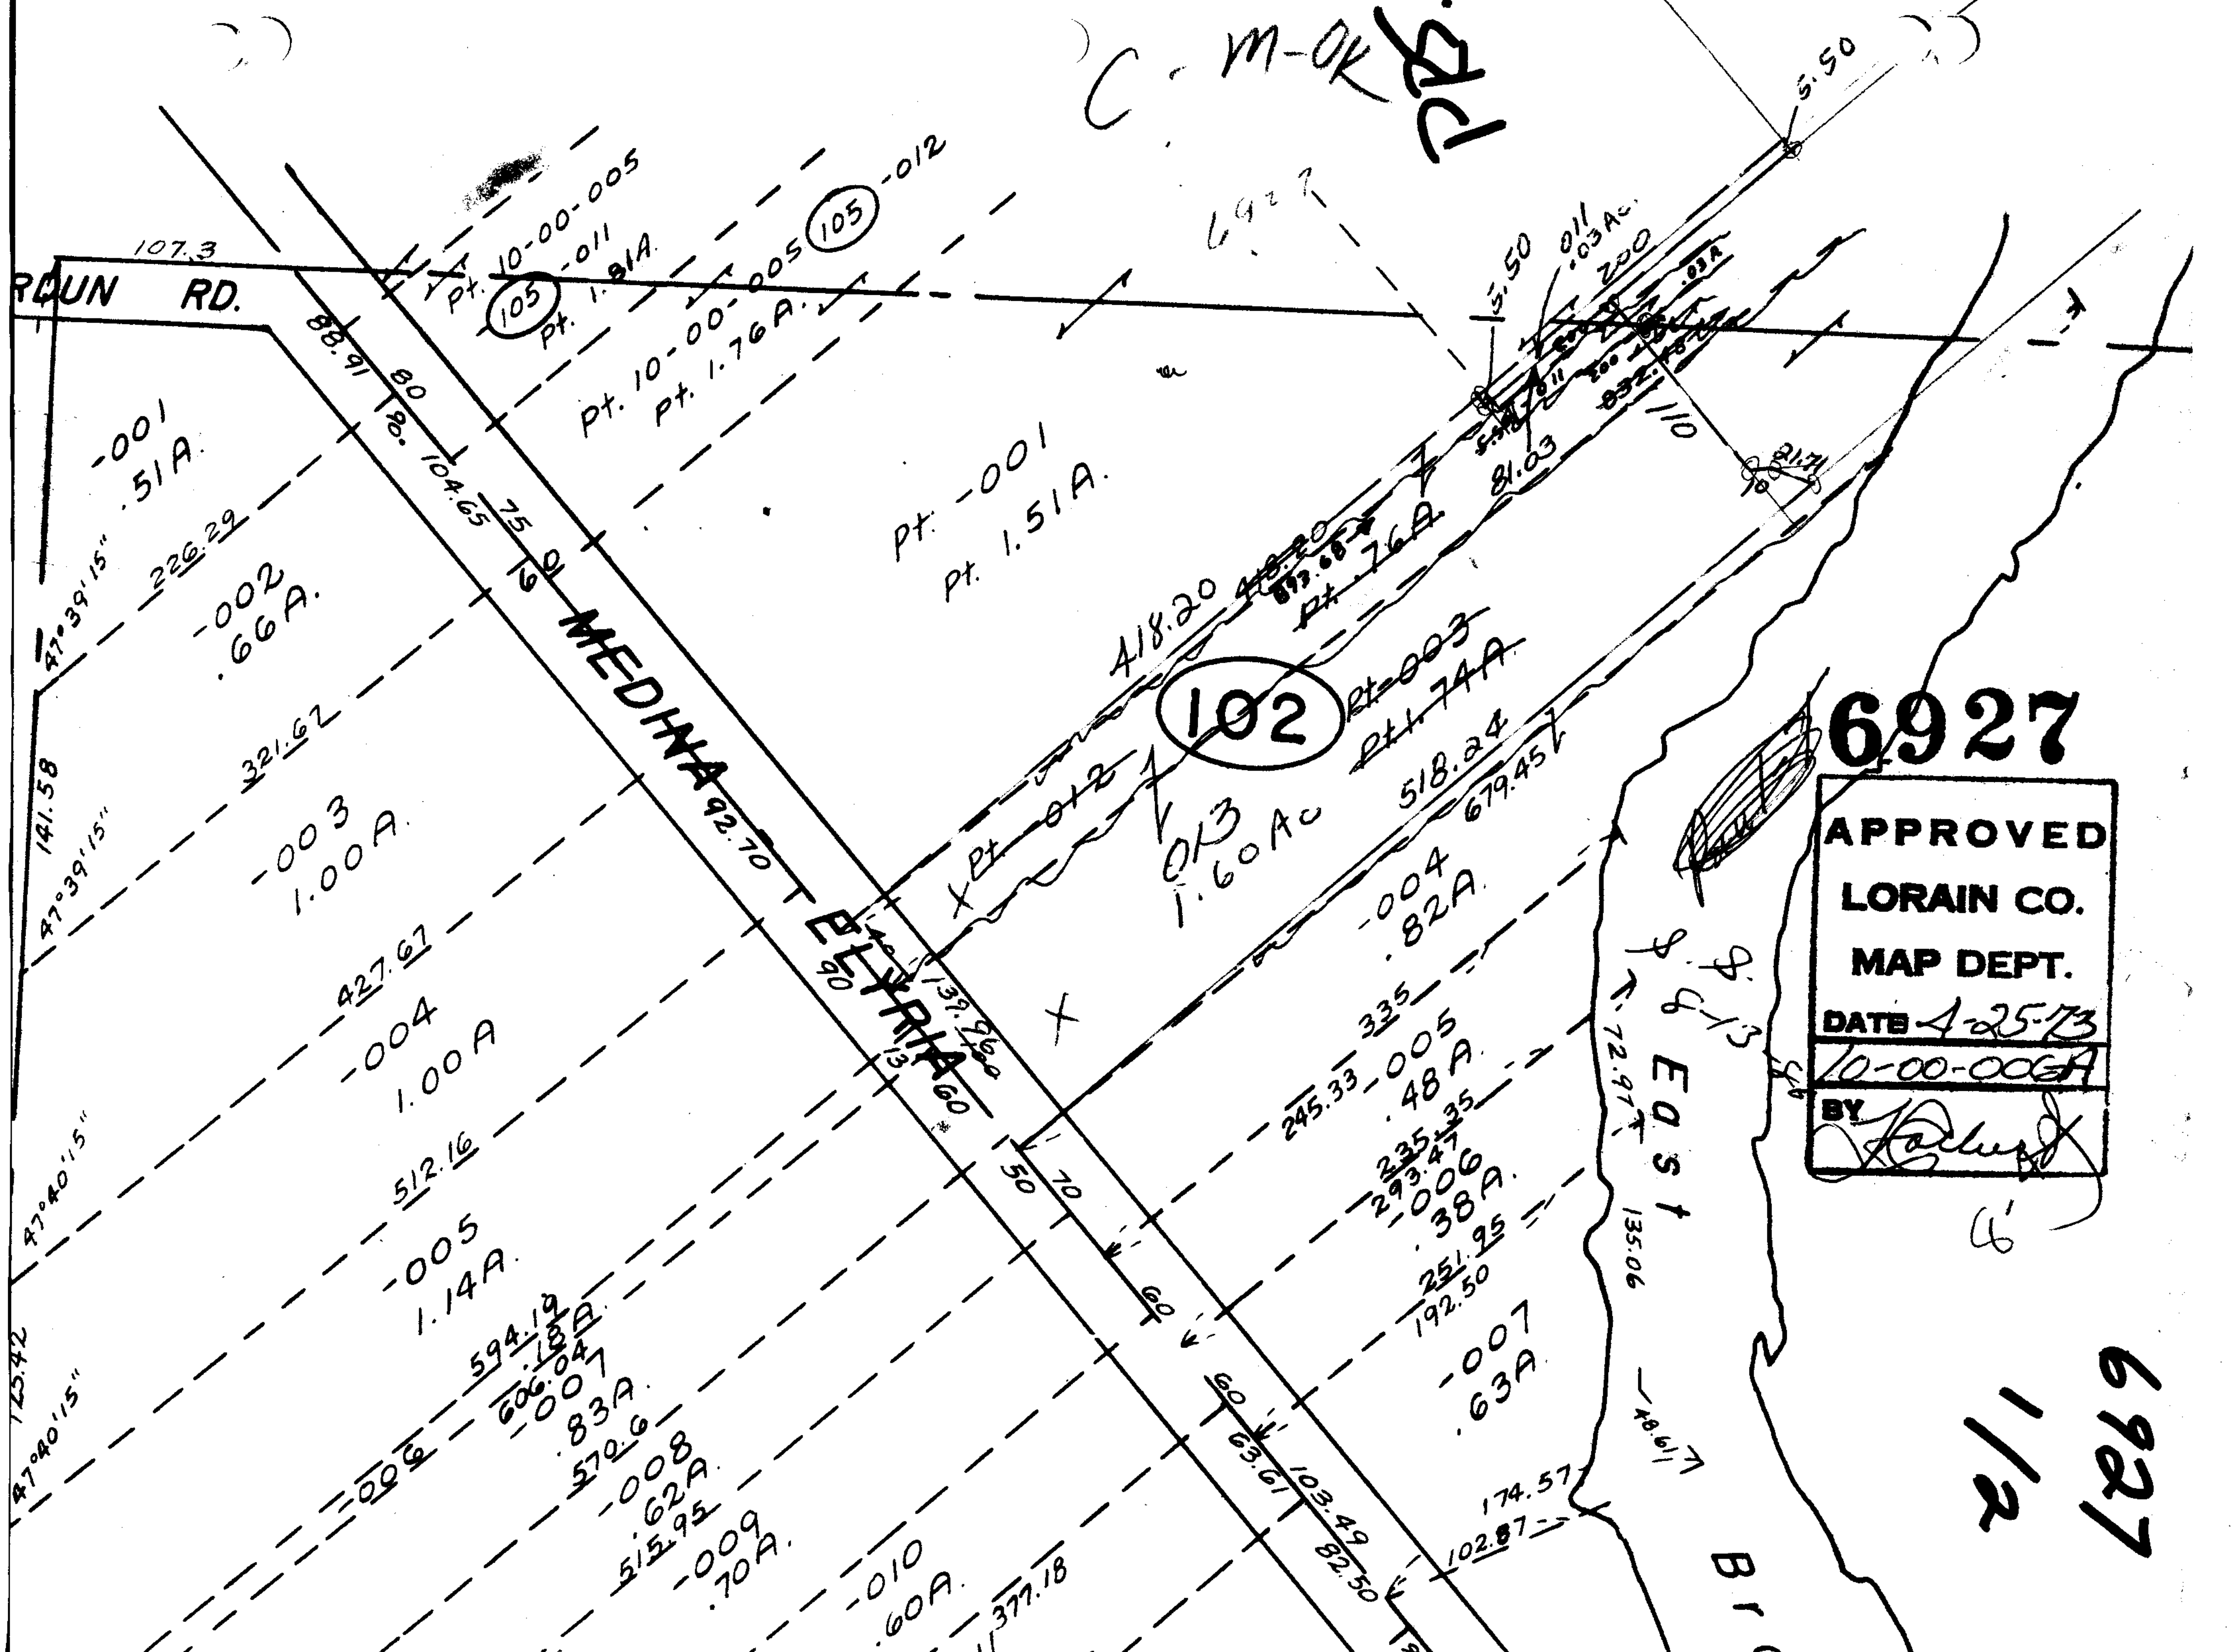

6927

APPROVED
LORAIN CO.
MAP DEPT.
DATE 4-25-73
10-00-006A
BY [Signature]

6927
1/2