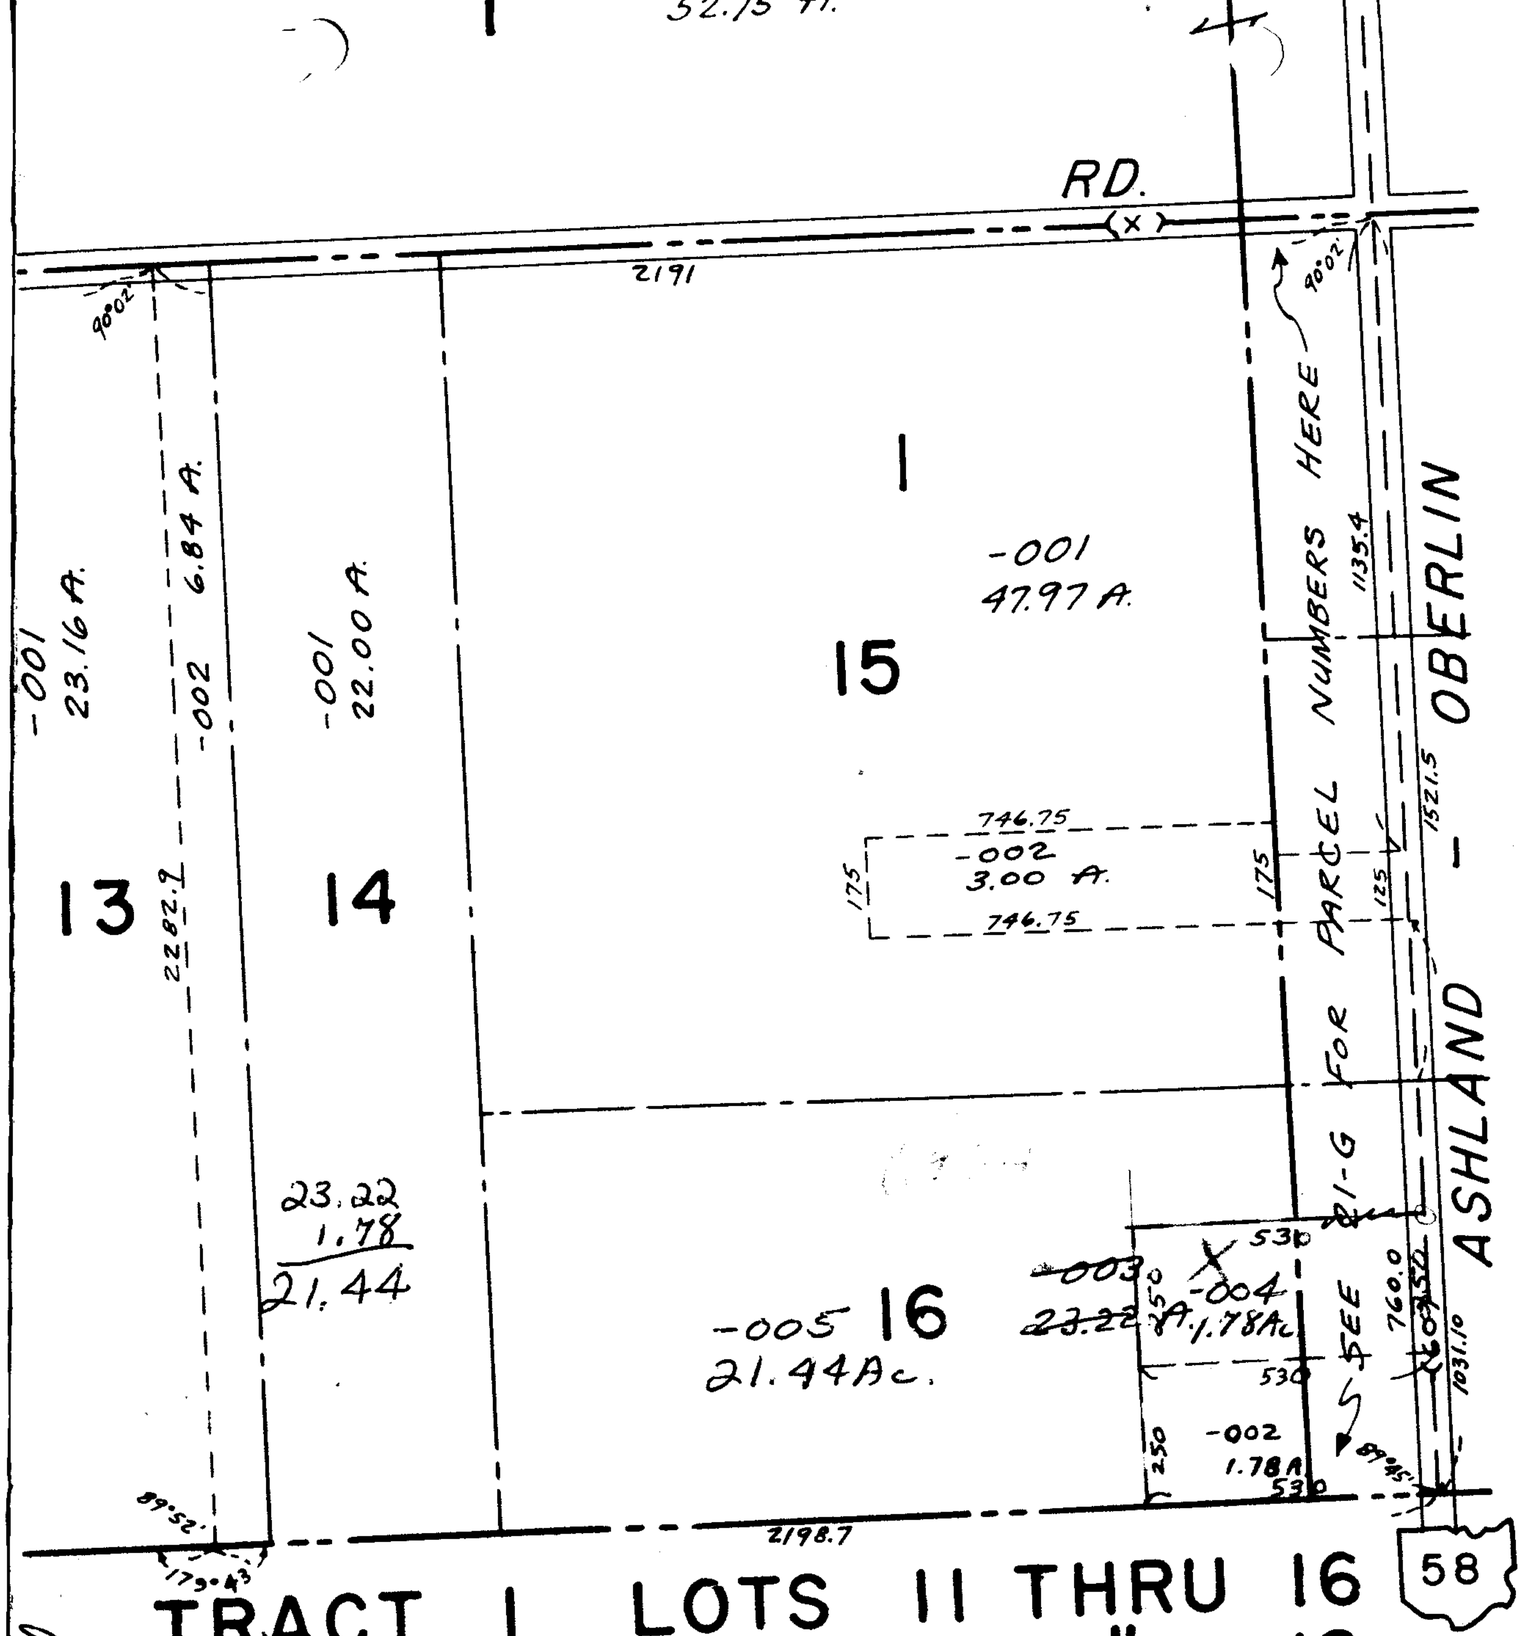

TRACT 1 LOTS 11 THRU 16
" 2 " 1 " 12
ELY. PT. TRACTS 3 & 4

C-M-OK

6934

APPROVED
LORAIN CO.
MAP DEPT.
DATE 4-25-73
21-F
BY [signature]

S.S.
8-13-86

APPROVED
LORAIN CO.

PRS

6934
21-F

Copyright 196

P. 21-F