


6940

P. 6-126

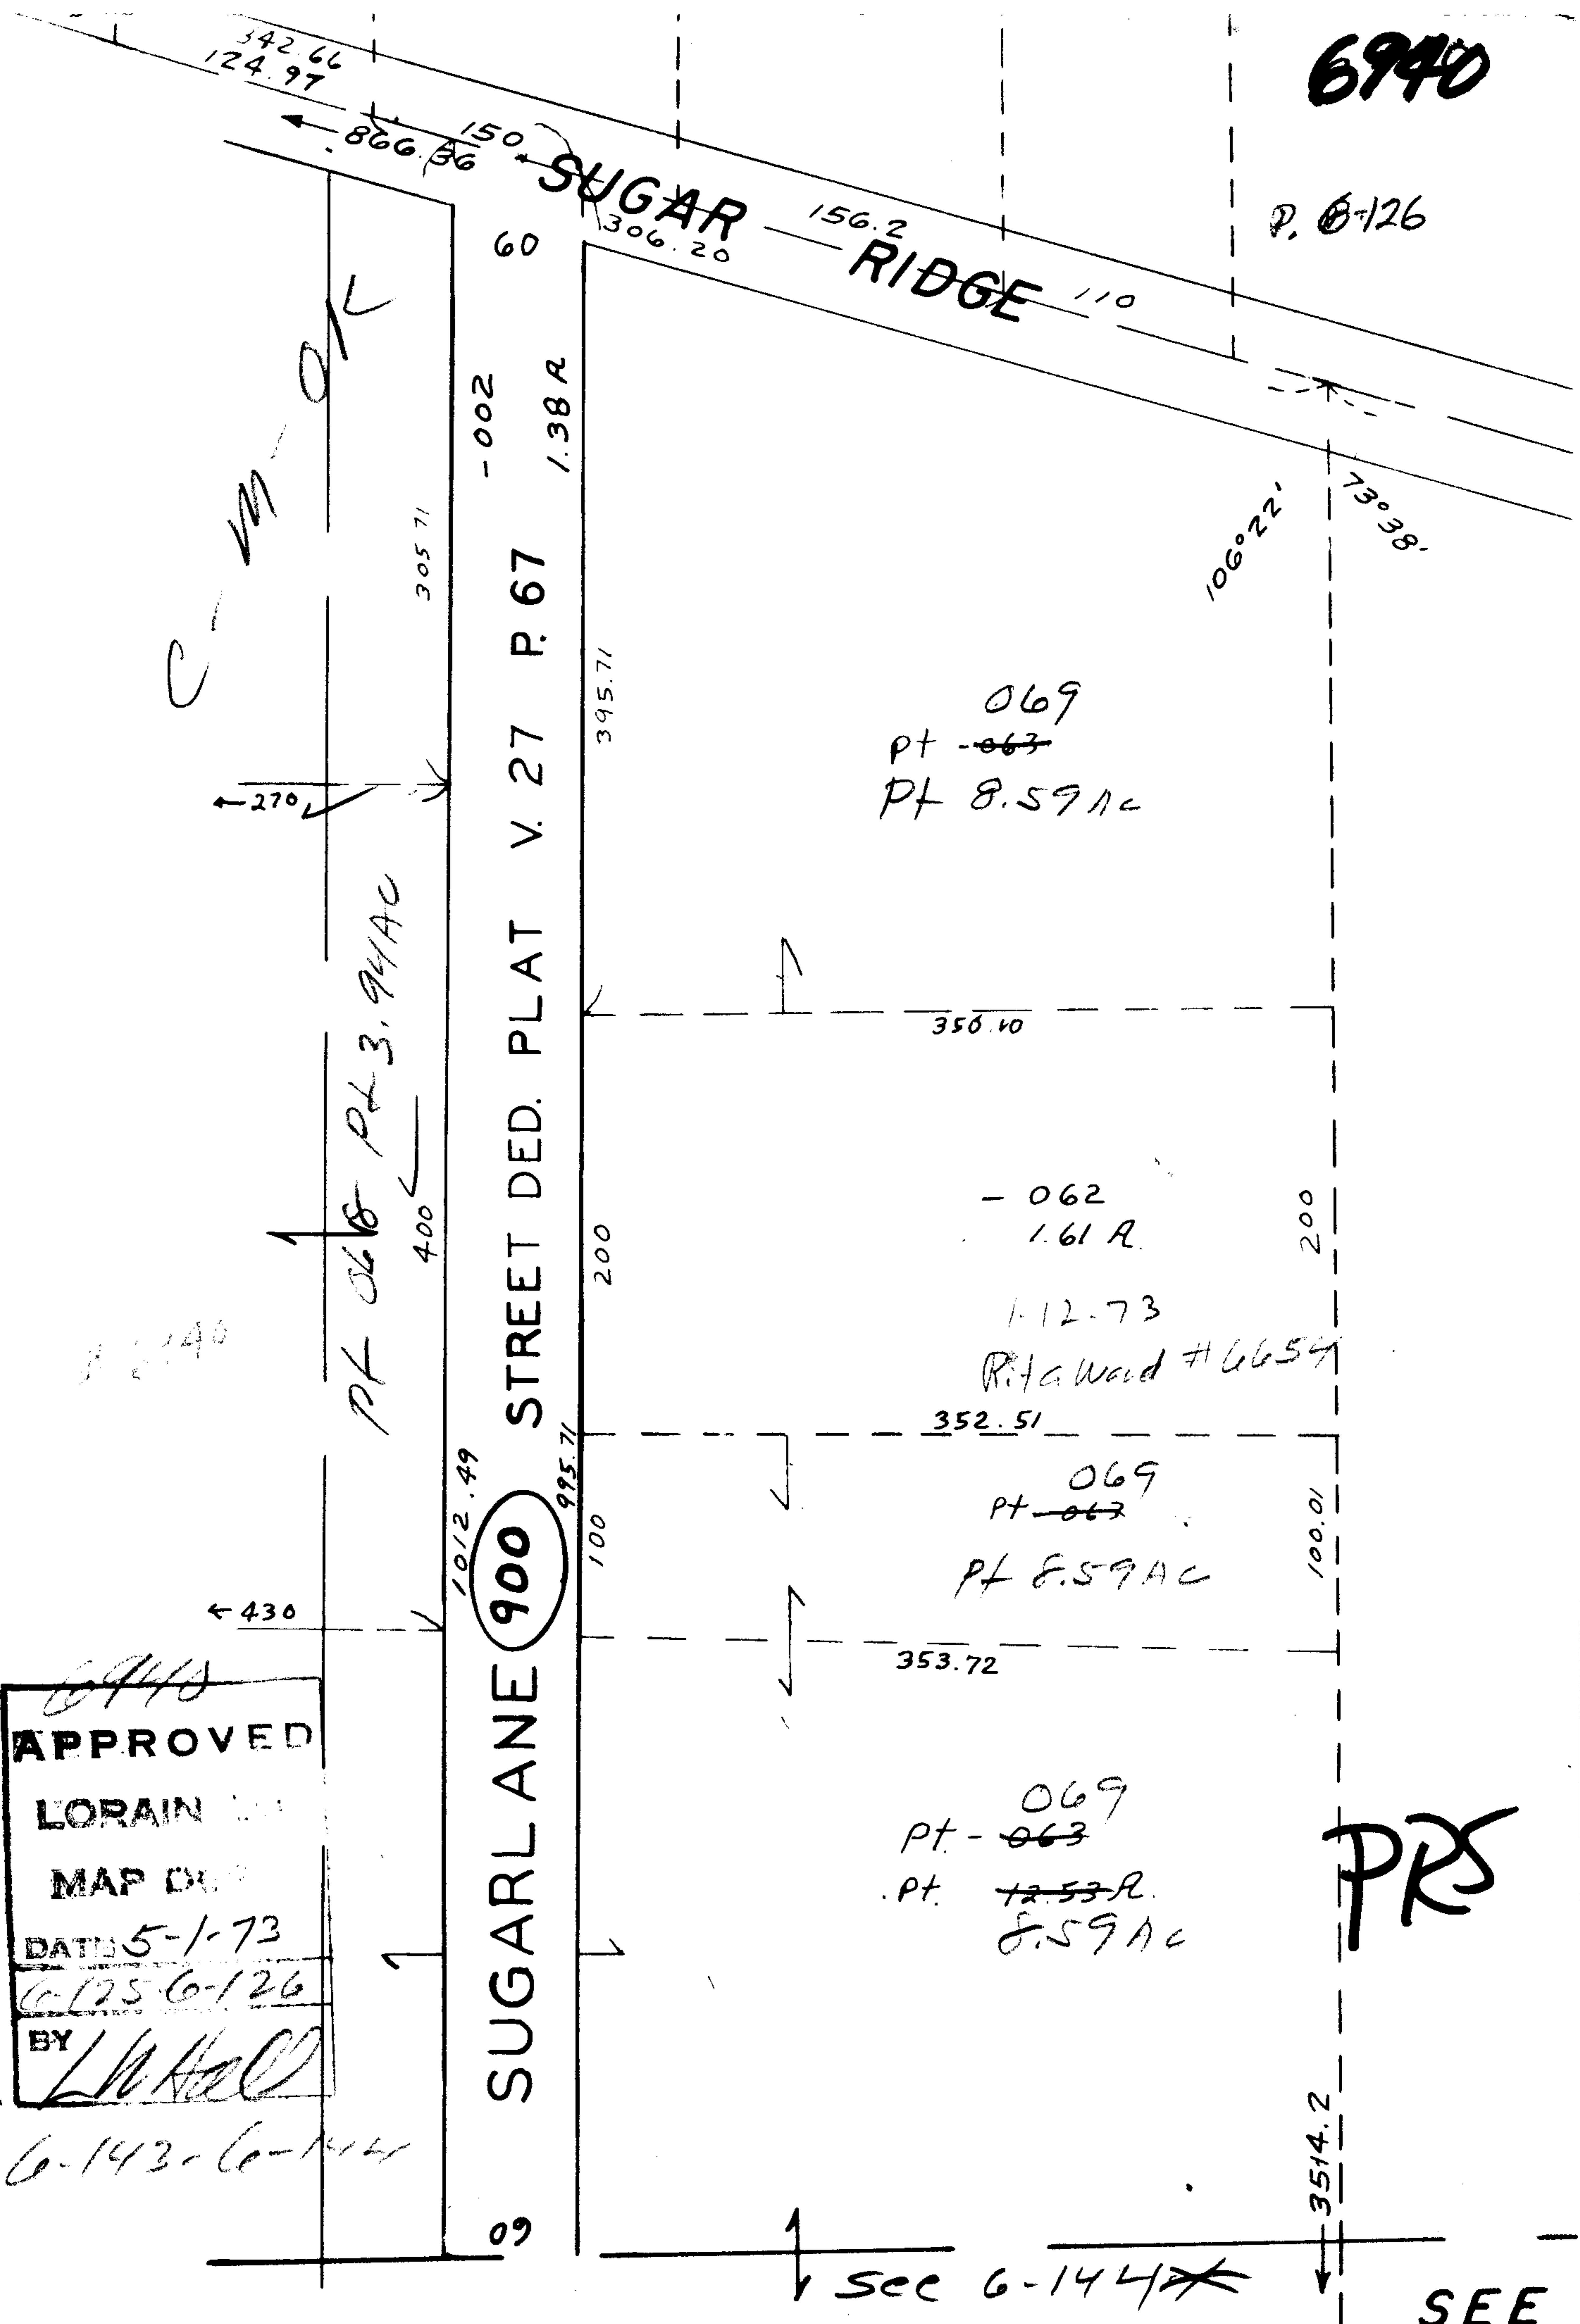

APPROVED
 LORAIN
 MAP DEP
 DATE 5-1-73
 6-125-6-126
 BY
 L. Hall

6-143-6-144

see 6-144

SEE

PRS