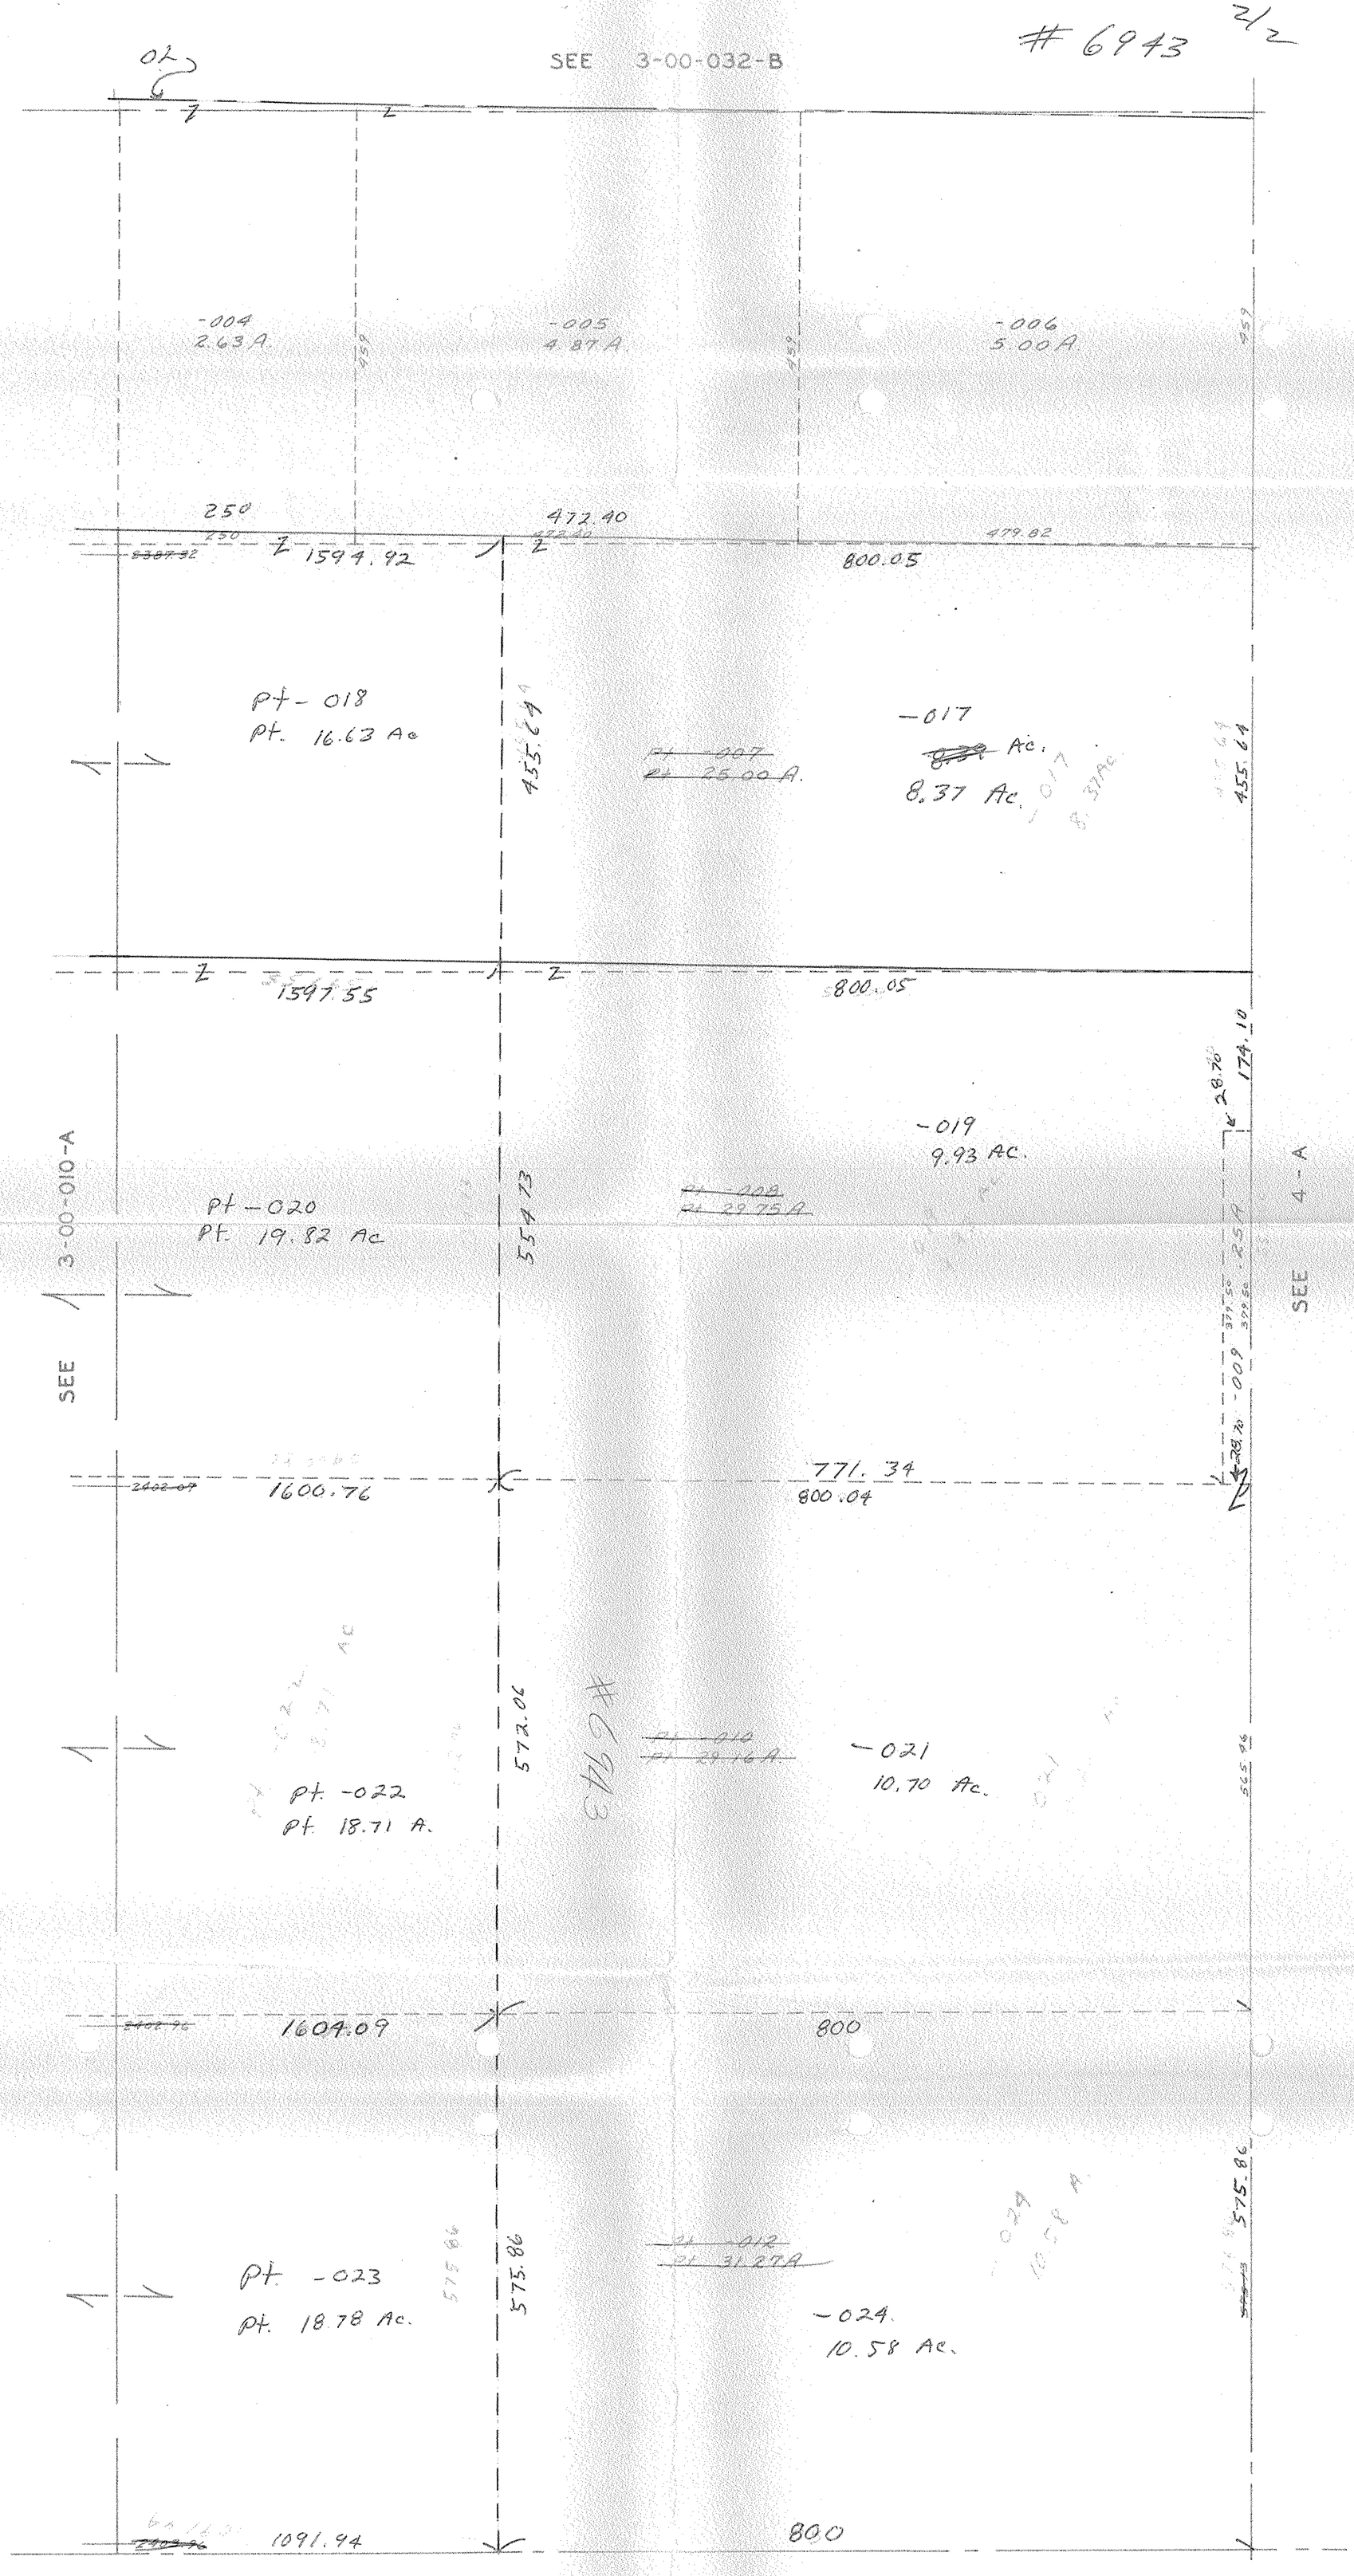
#6943
2/2
SEE 3-00-032-B
-004
2.63 A.
-005
4.87 A
-006
5.00 A
250
472.40
479.02
1594.92
800.05
Pt-018
Pt. 16.63 Ac
455.64
-017
8.37 Ac.
1597.55
800.05
174.10
-019
9.93 Ac.
3-00-010-A
Pt-020
Pt. 19.82 Ac
554.13
SEE
4-A
SEE
771.34
1600.76
800.04
572.06
-021
10.70 Ac.
Pt. -022
Pt. 18.71 A.
1604.09
800
575.86
Pt. -023
Pt. 18.78 Ac.
-024
10.58 Ac.
1091.94
800
SEE 3-00-009-B