#6943 1/2

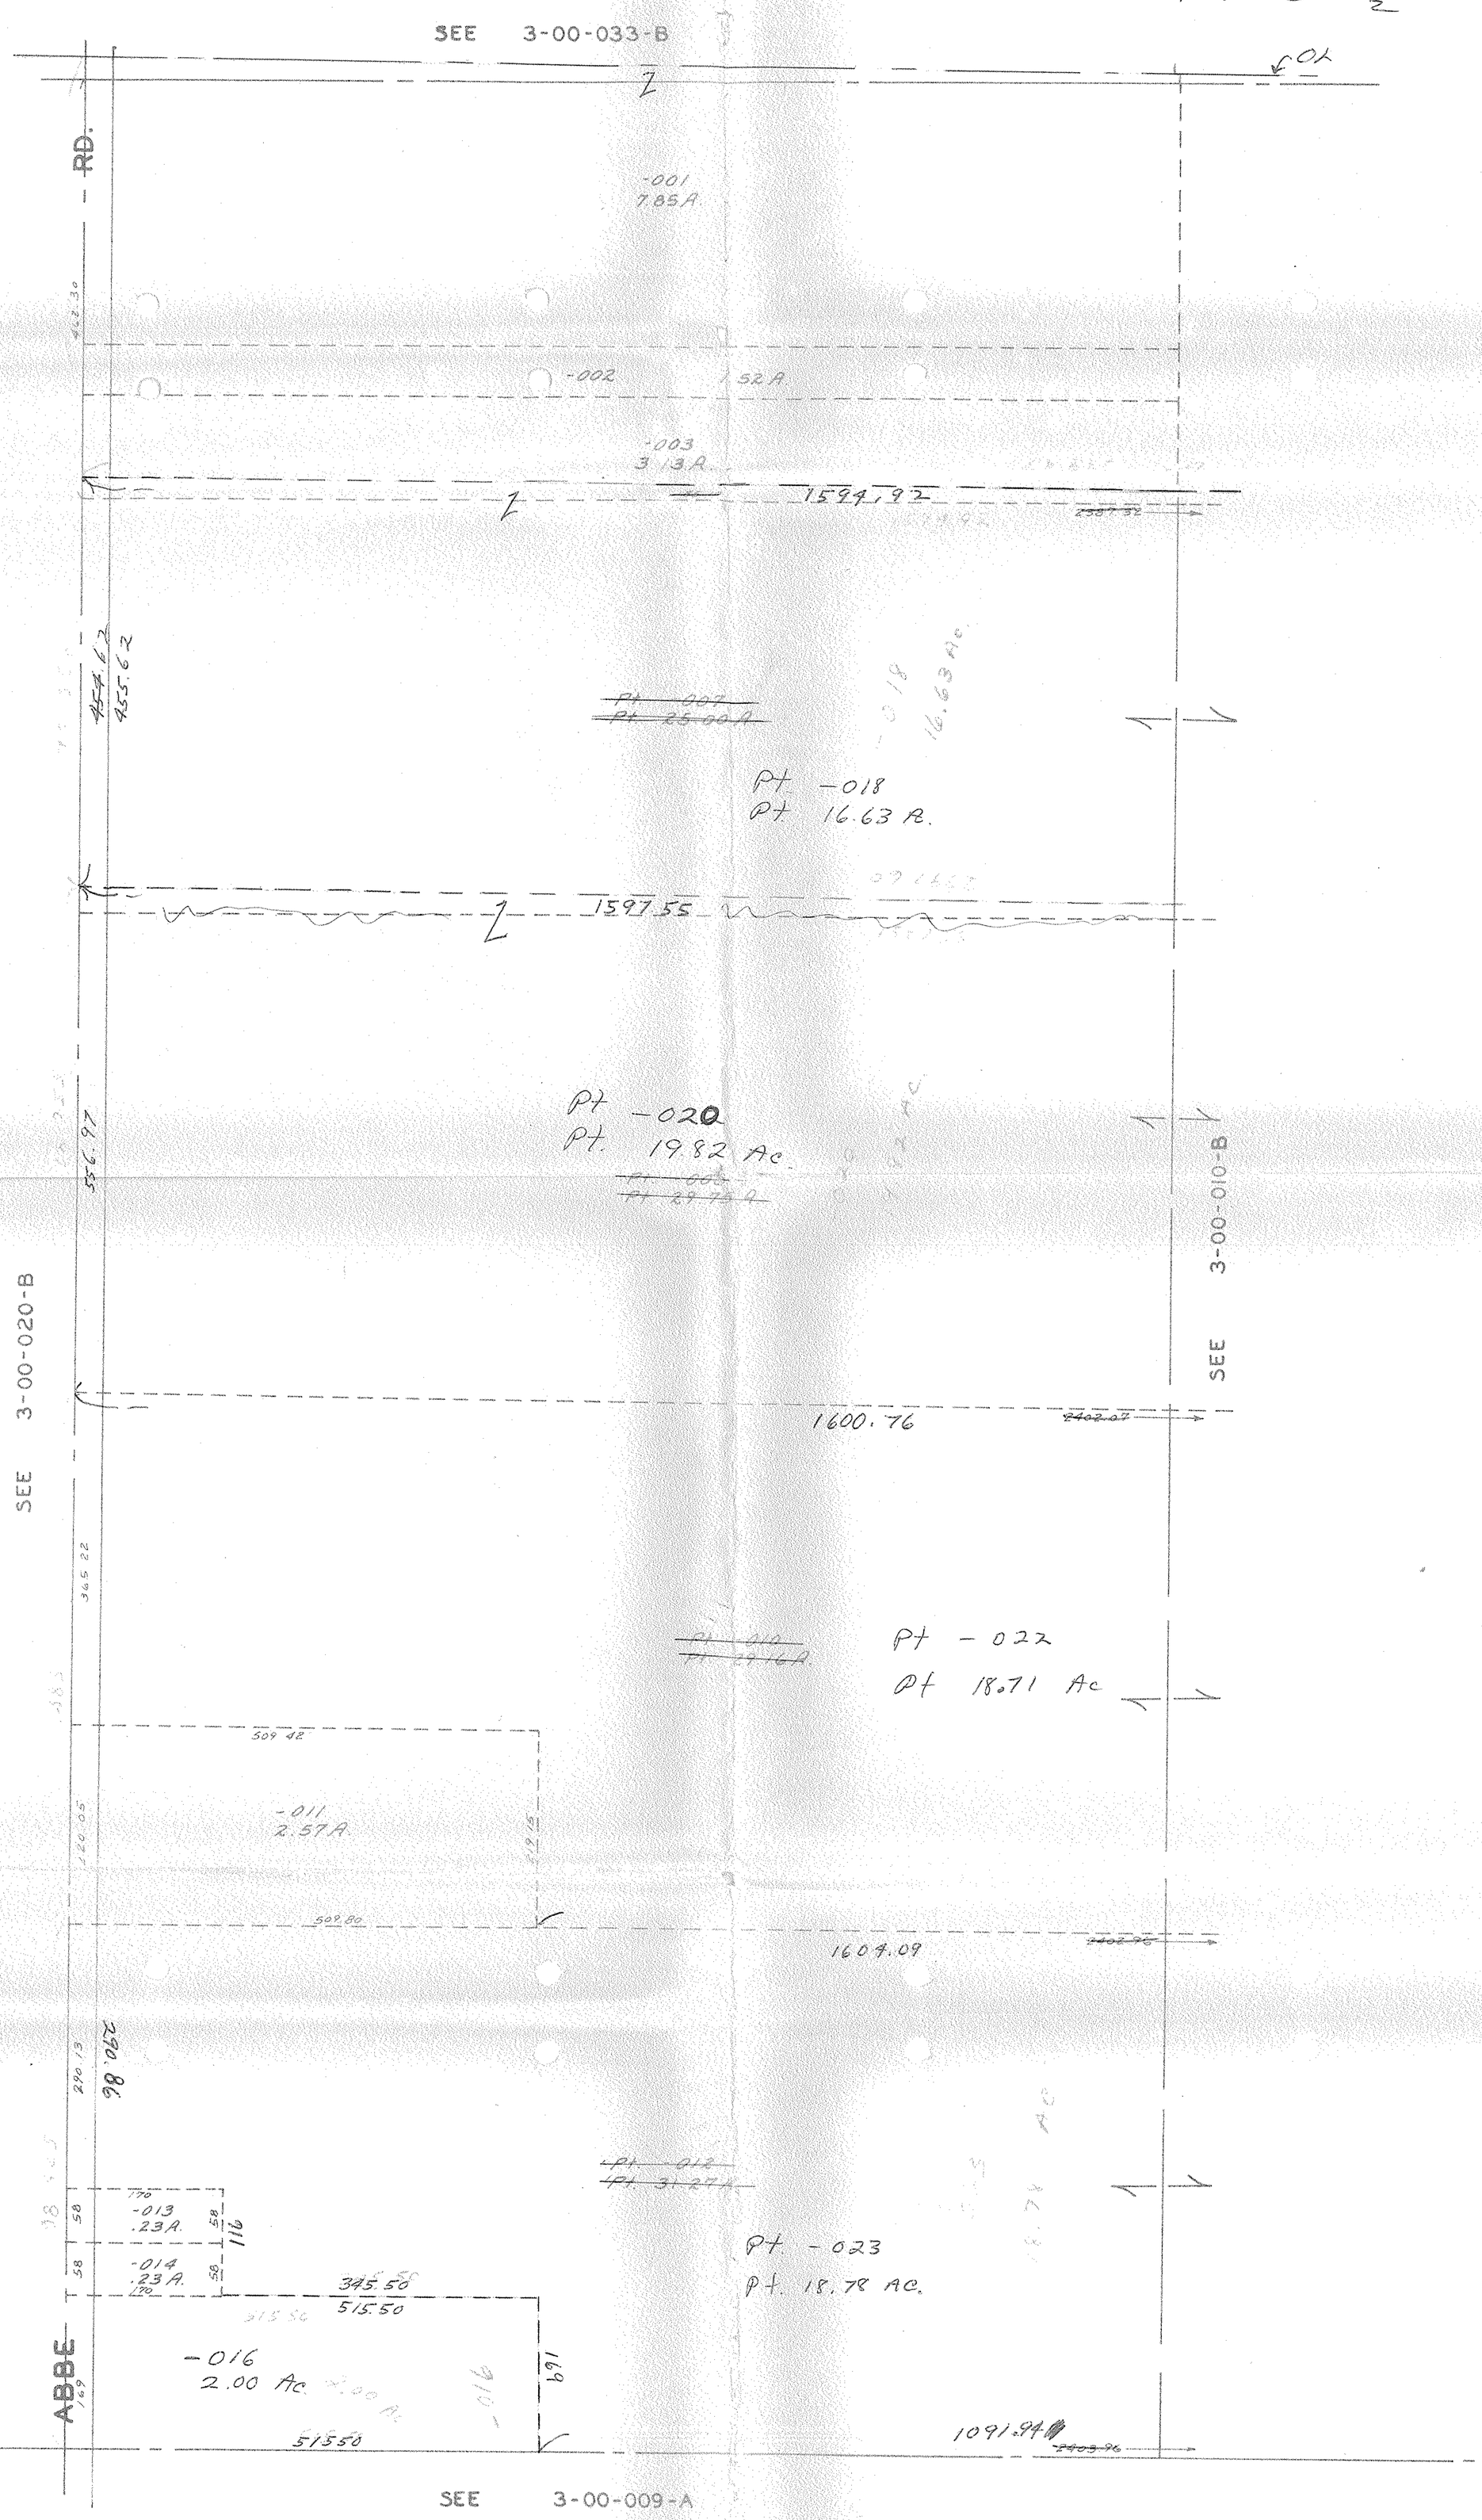
SEE 3-00-033-B
RD.
-001
7.85 A.
-002
1.52 A
-003
3.13 A.
1594.92
Pt -018
Pt 16.63 Ac.
1597.55
Pt -020
Pt 19.82 Ac.
SEE 3-00-020-B
SEE 3-00-010-B
1600.76
Pt -022
Pt 18.71 Ac
-011
2.57 A
509.80
1609.09
-013
.23 A.
-014
.23 A.
-016
2.00 Ac
ABBE
Pt -023
Pt. 18.78 Ac.
1091.94
SEE 3-00-009-A