

6569

5' 8" 1/2

85  
25  
90

APPROVED  
 LORAIN CO.  
 MAP DEPT.  
 DATE 5-7-73  
 09-00-083 B  
 L.H. HALL

6959

P. 25

CLARKWOOD VOL.

900 - 003 SYCAMORE PLACE SUB. .66A.


105

104

900 - 002 BEECH SUB.

101

CLARKWOOD VOL.

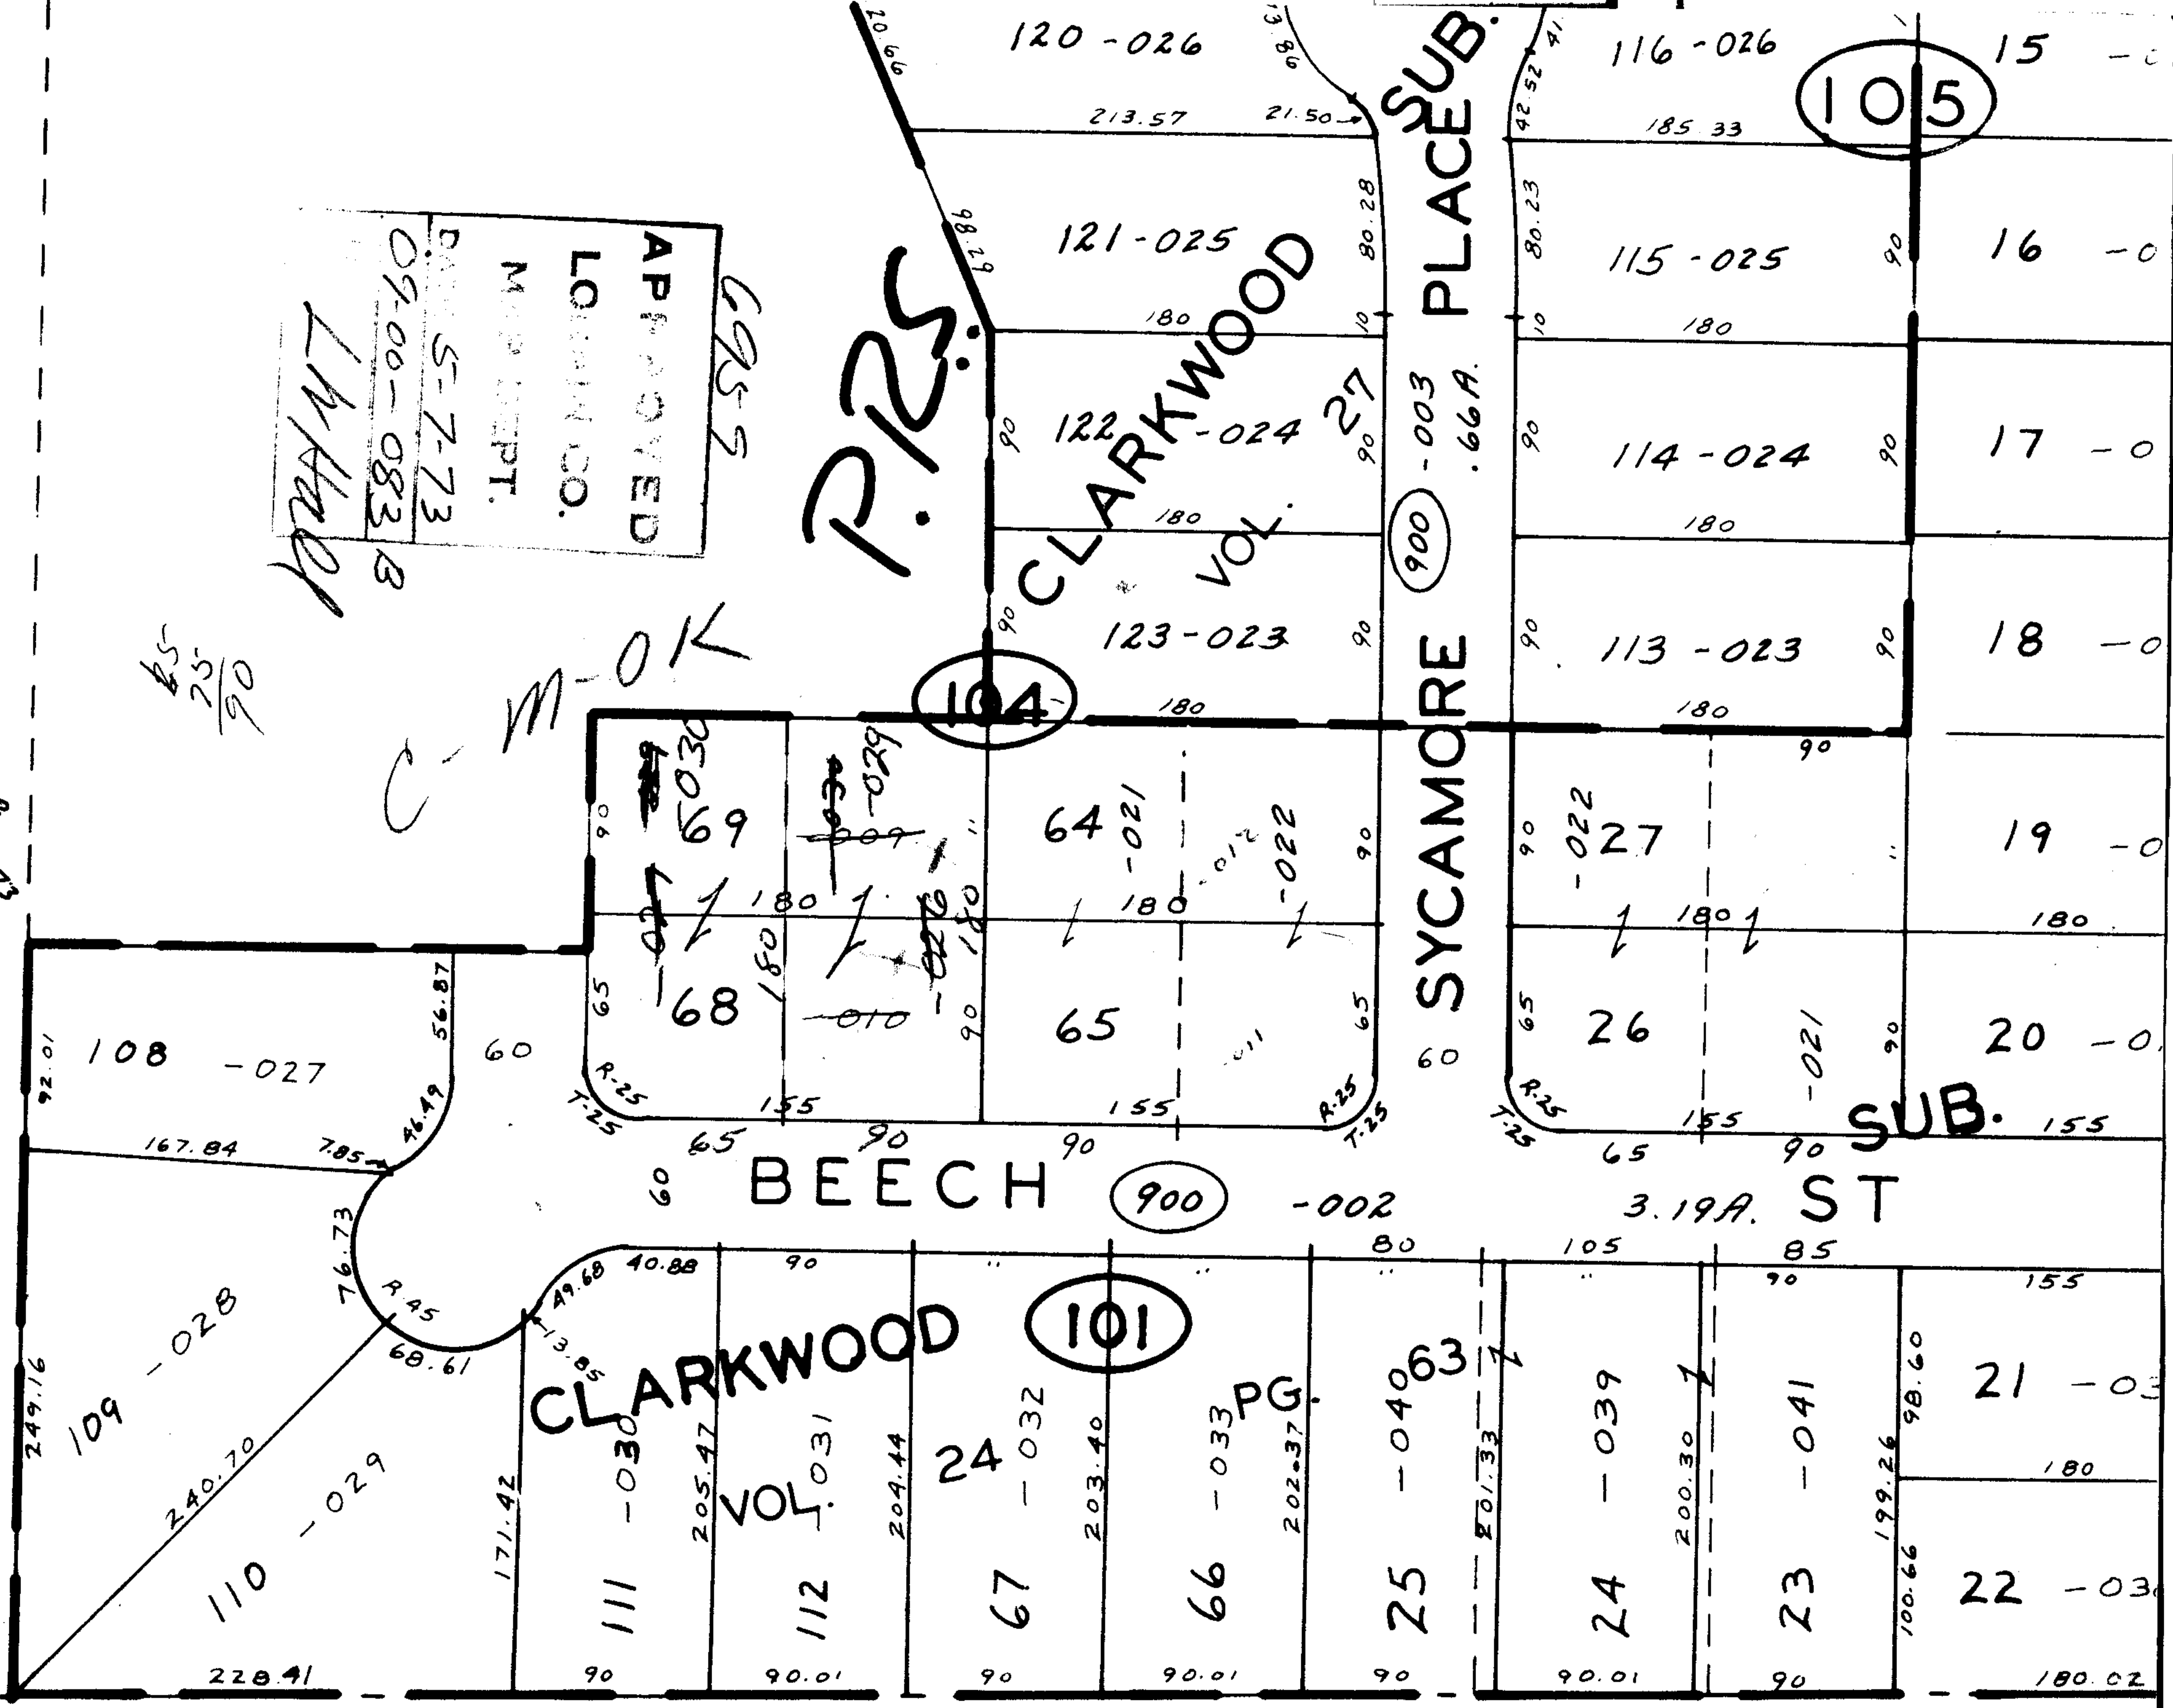

SEE 9-00-093-B