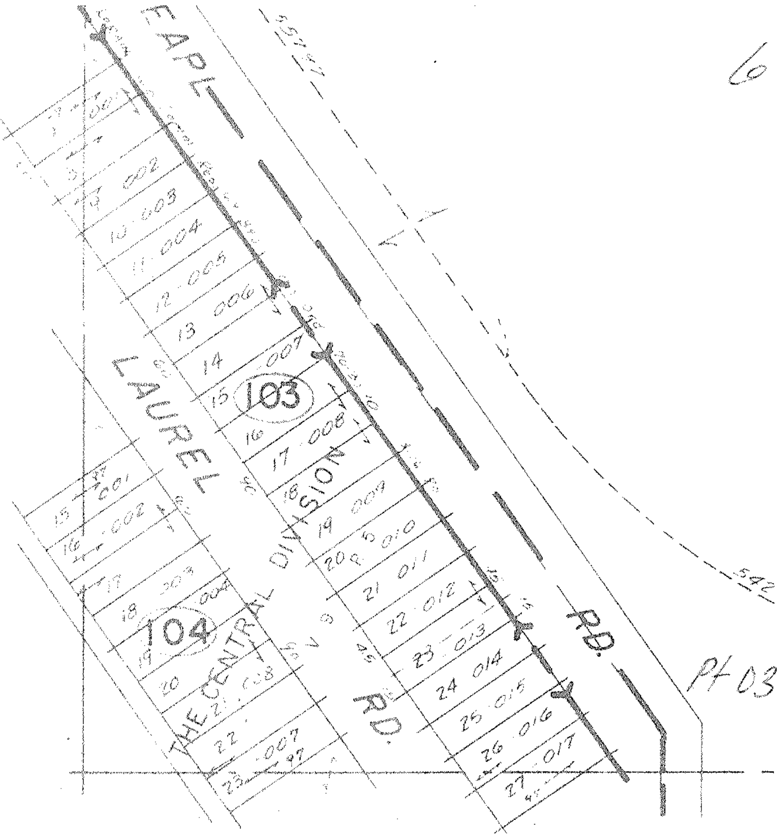
6
EARL RD.
LAUREL RD.
THE CENTRAL DIVISION
103
104
Pt 03
542
9 .002
10 .003
11 .004
12 .005
13 .006
14 .007
15
16
17 .008
18
19 .009
20 .010
21 .011
22 .012
23 .013
24 .014
25 .015
26 .016
27 .017
15 .001
16 .002
17
18 .003
.004
19
20
21 .008
22
23 .007

964

PR5

Pg. 3-00-105-A

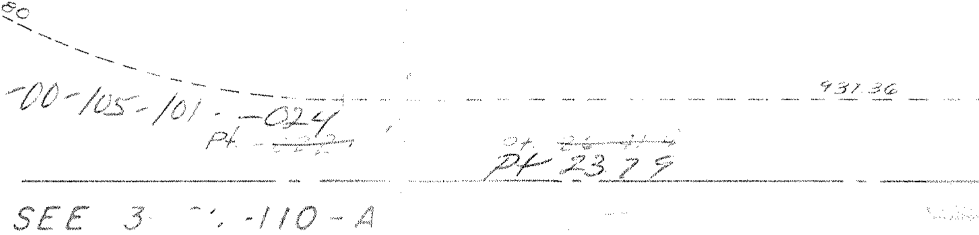
80
00-105-101-024
Pt.
931.36
Pt 23.79
SEE 3- -110-A

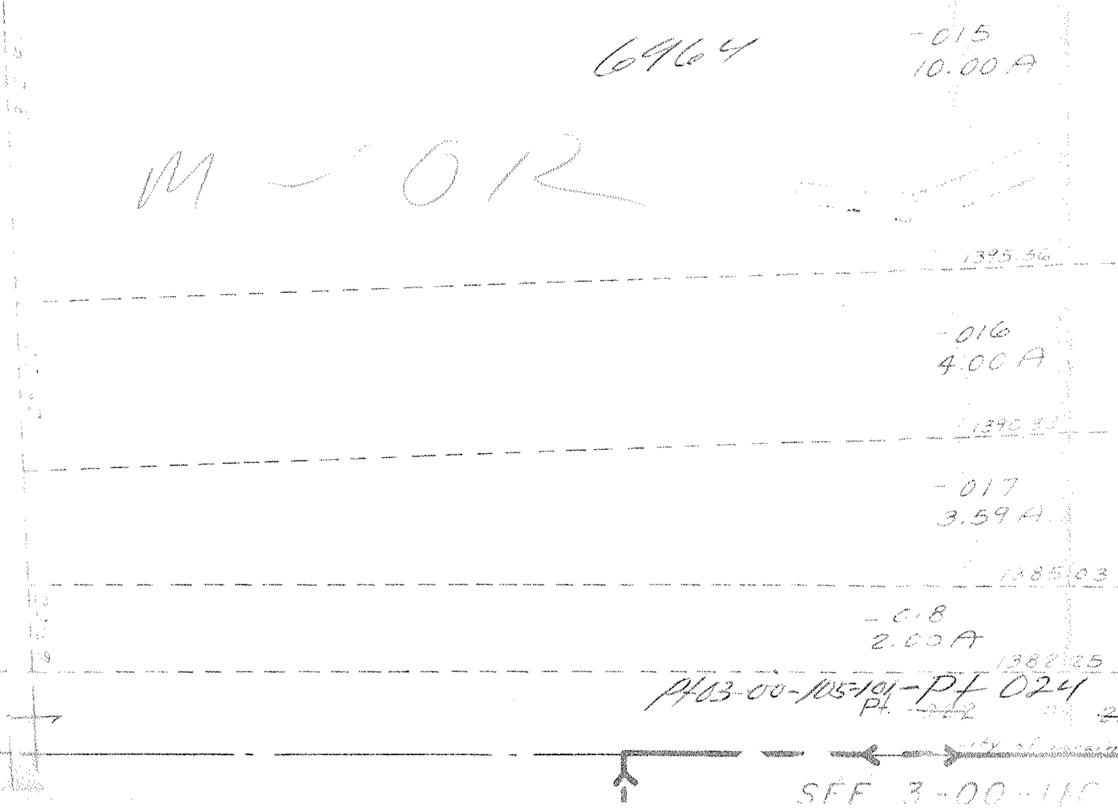
6464
-015
10.00 A
M-OR
1395.56
-016
4.00 A
-017
3.59 A
1385.03
-018
2.00 A
1382.25
P03-00-105-101-PF 024
Pl.
SFF 3-00-11C

PRS

Pg 3-00-105-B

P/23.79 Ac

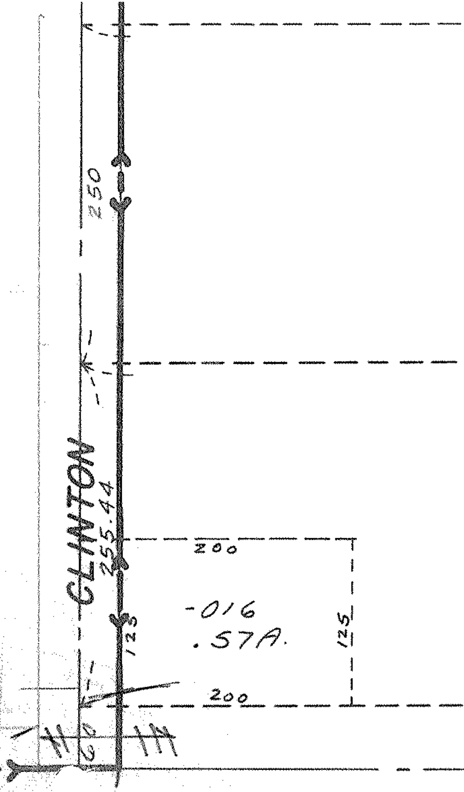
250
CLINTON
255.44
200
-016
.57A.
125
125
200
60

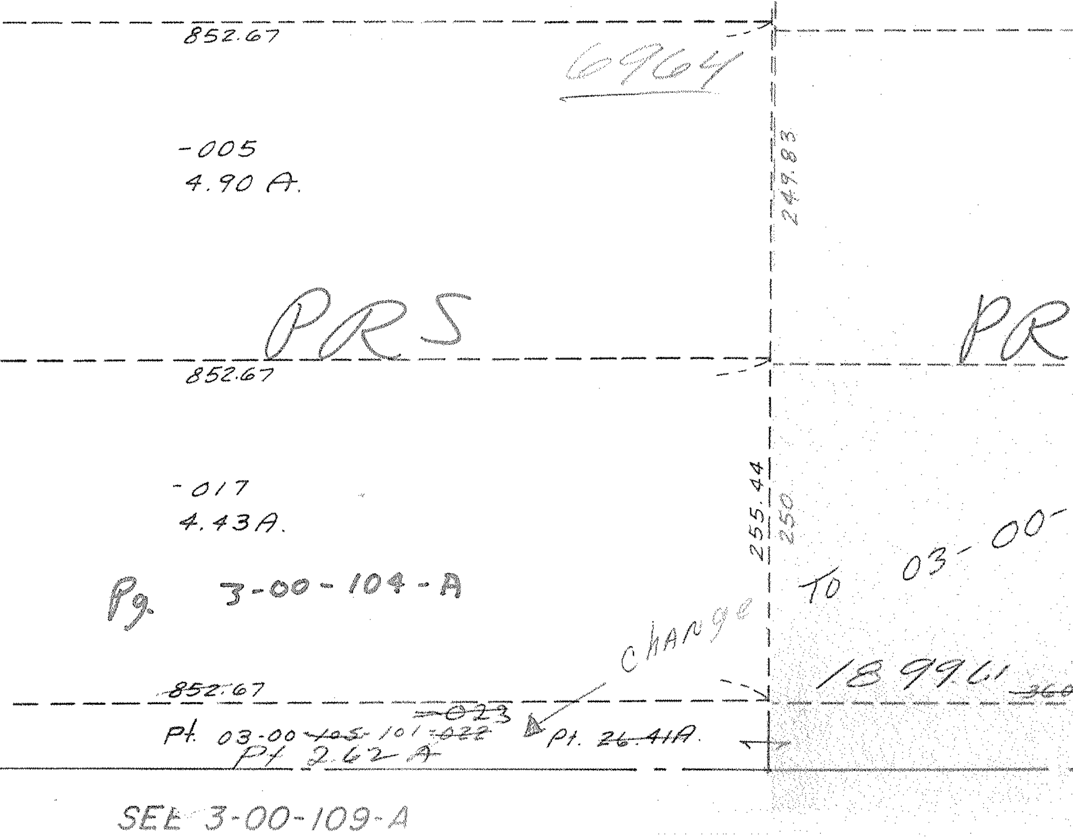
852.67
6964
-005
4.90 A.
249.83
PRS
PR
852.67
-017
4.43A.
255.44
250
Pg. 3-00-104-A
change TO 03-00-
18996
~~852.67~~
~~-023~~
Pt. 03-00 ~~105~~ 101 ~~-022~~
~~Pt 2.62 A~~
Pt. ~~26.41A.~~
SEE 3-00-109-A

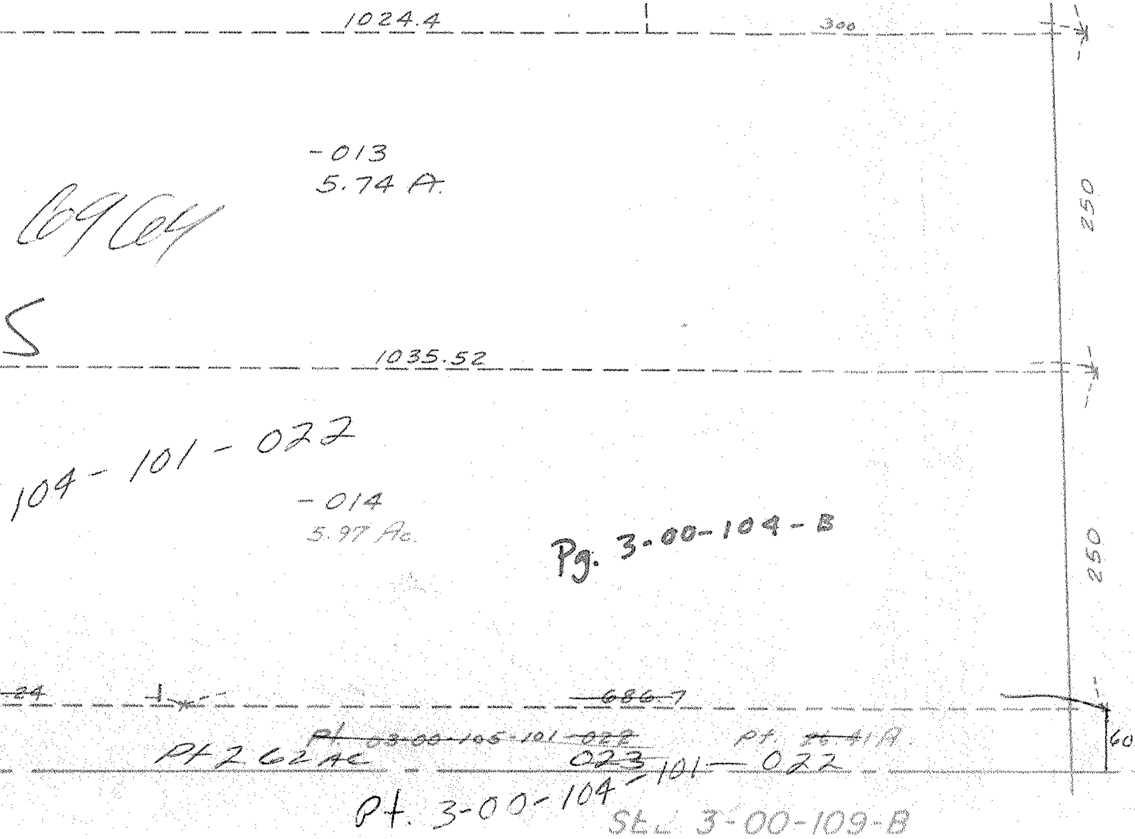

1024.4
300
-013
5.74 A.
250
1035.52
104-101-022
-014
5.97 Ac.
Pg. 3-00-104-B
250
~~686.7~~
~~Pt 03-00-105-101-022~~
Pt. ~~21-41A.~~
Pt 2.62 Ac
023
-101-022
60
Pt. 3-00-104
SEE 3-00-109-B

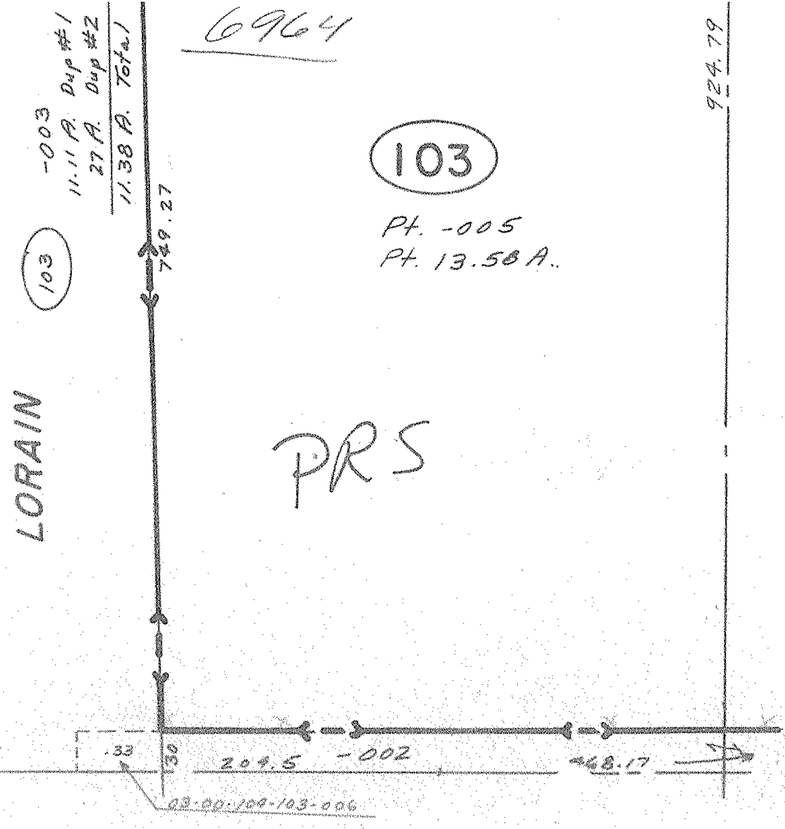
6964
-003
11.11 A. Dup #1
.27 A. Dup #2
11.38 A. Total
103
749.27
103
Pt. -005
Pt. 13.58 A..
924.79
LORAIN
PRS
.33
30
204.5
-002
468.17
03-00-109-105-006