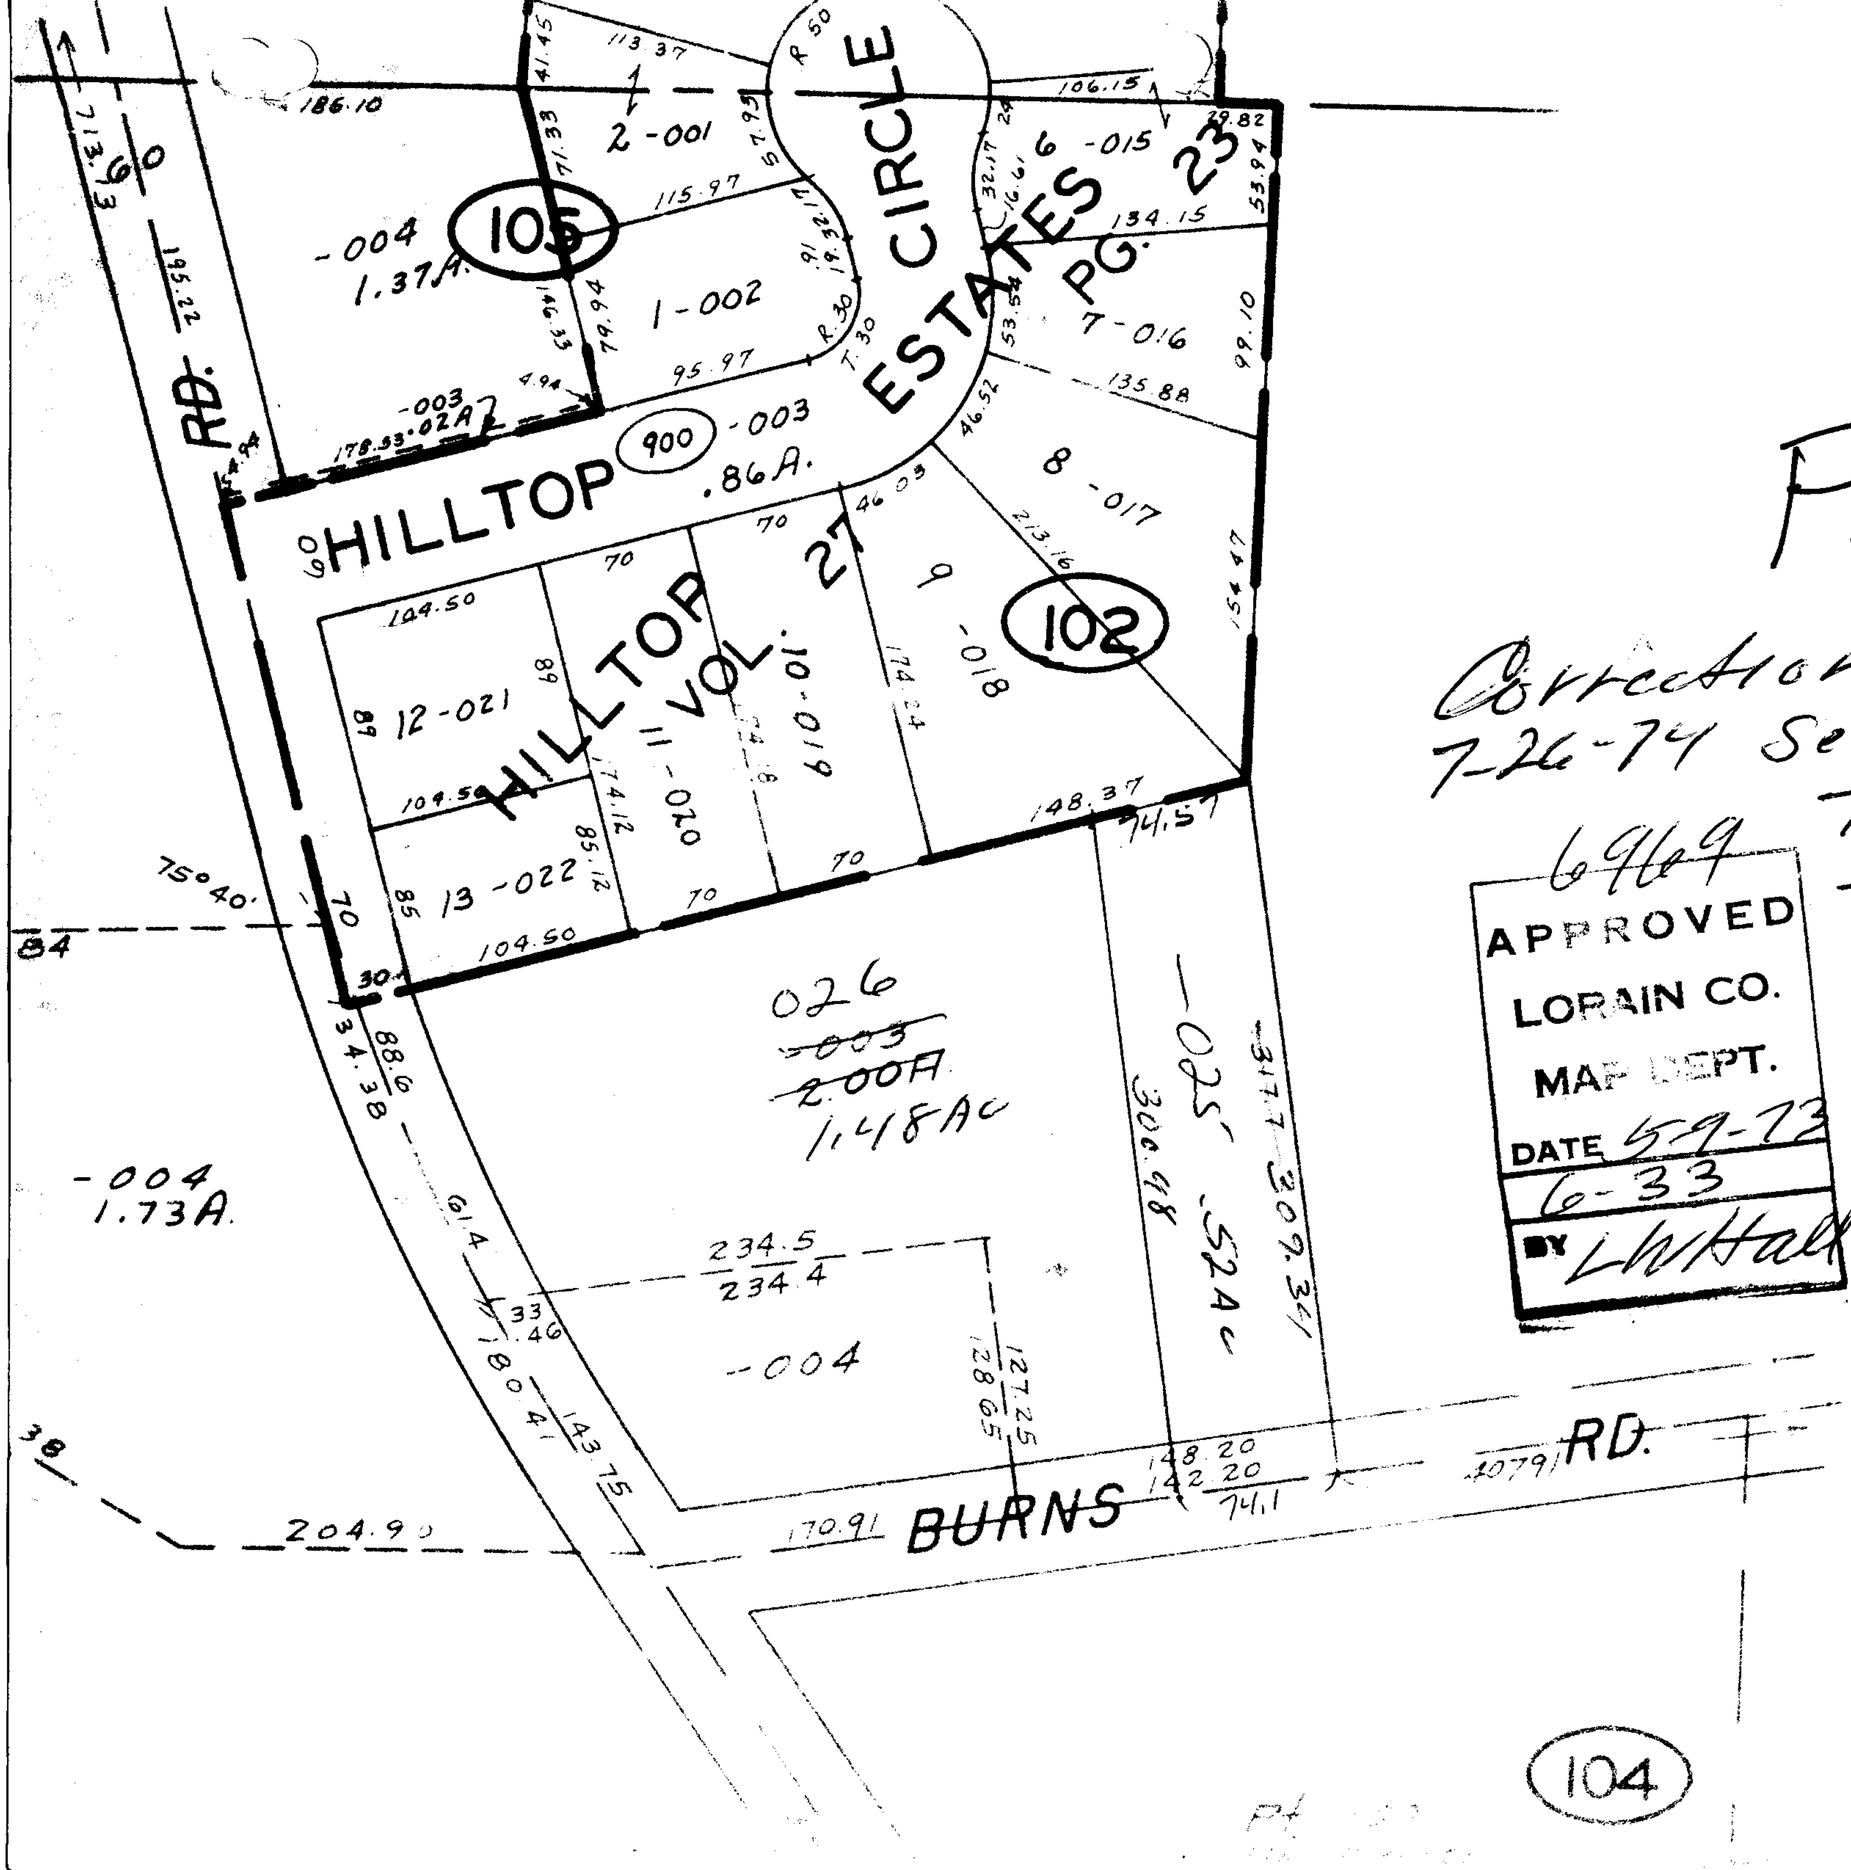

P.R.S.

Correction
7-26-74 See #8163
To Relocate
This Parcel
On Map
LW Hall
+ 8122
C Mok

6969

APPROVED
LORAIN CO.
MAP DEPT.
DATE 5-9-73
6-33
BY LW Hall

6969