


6973

103

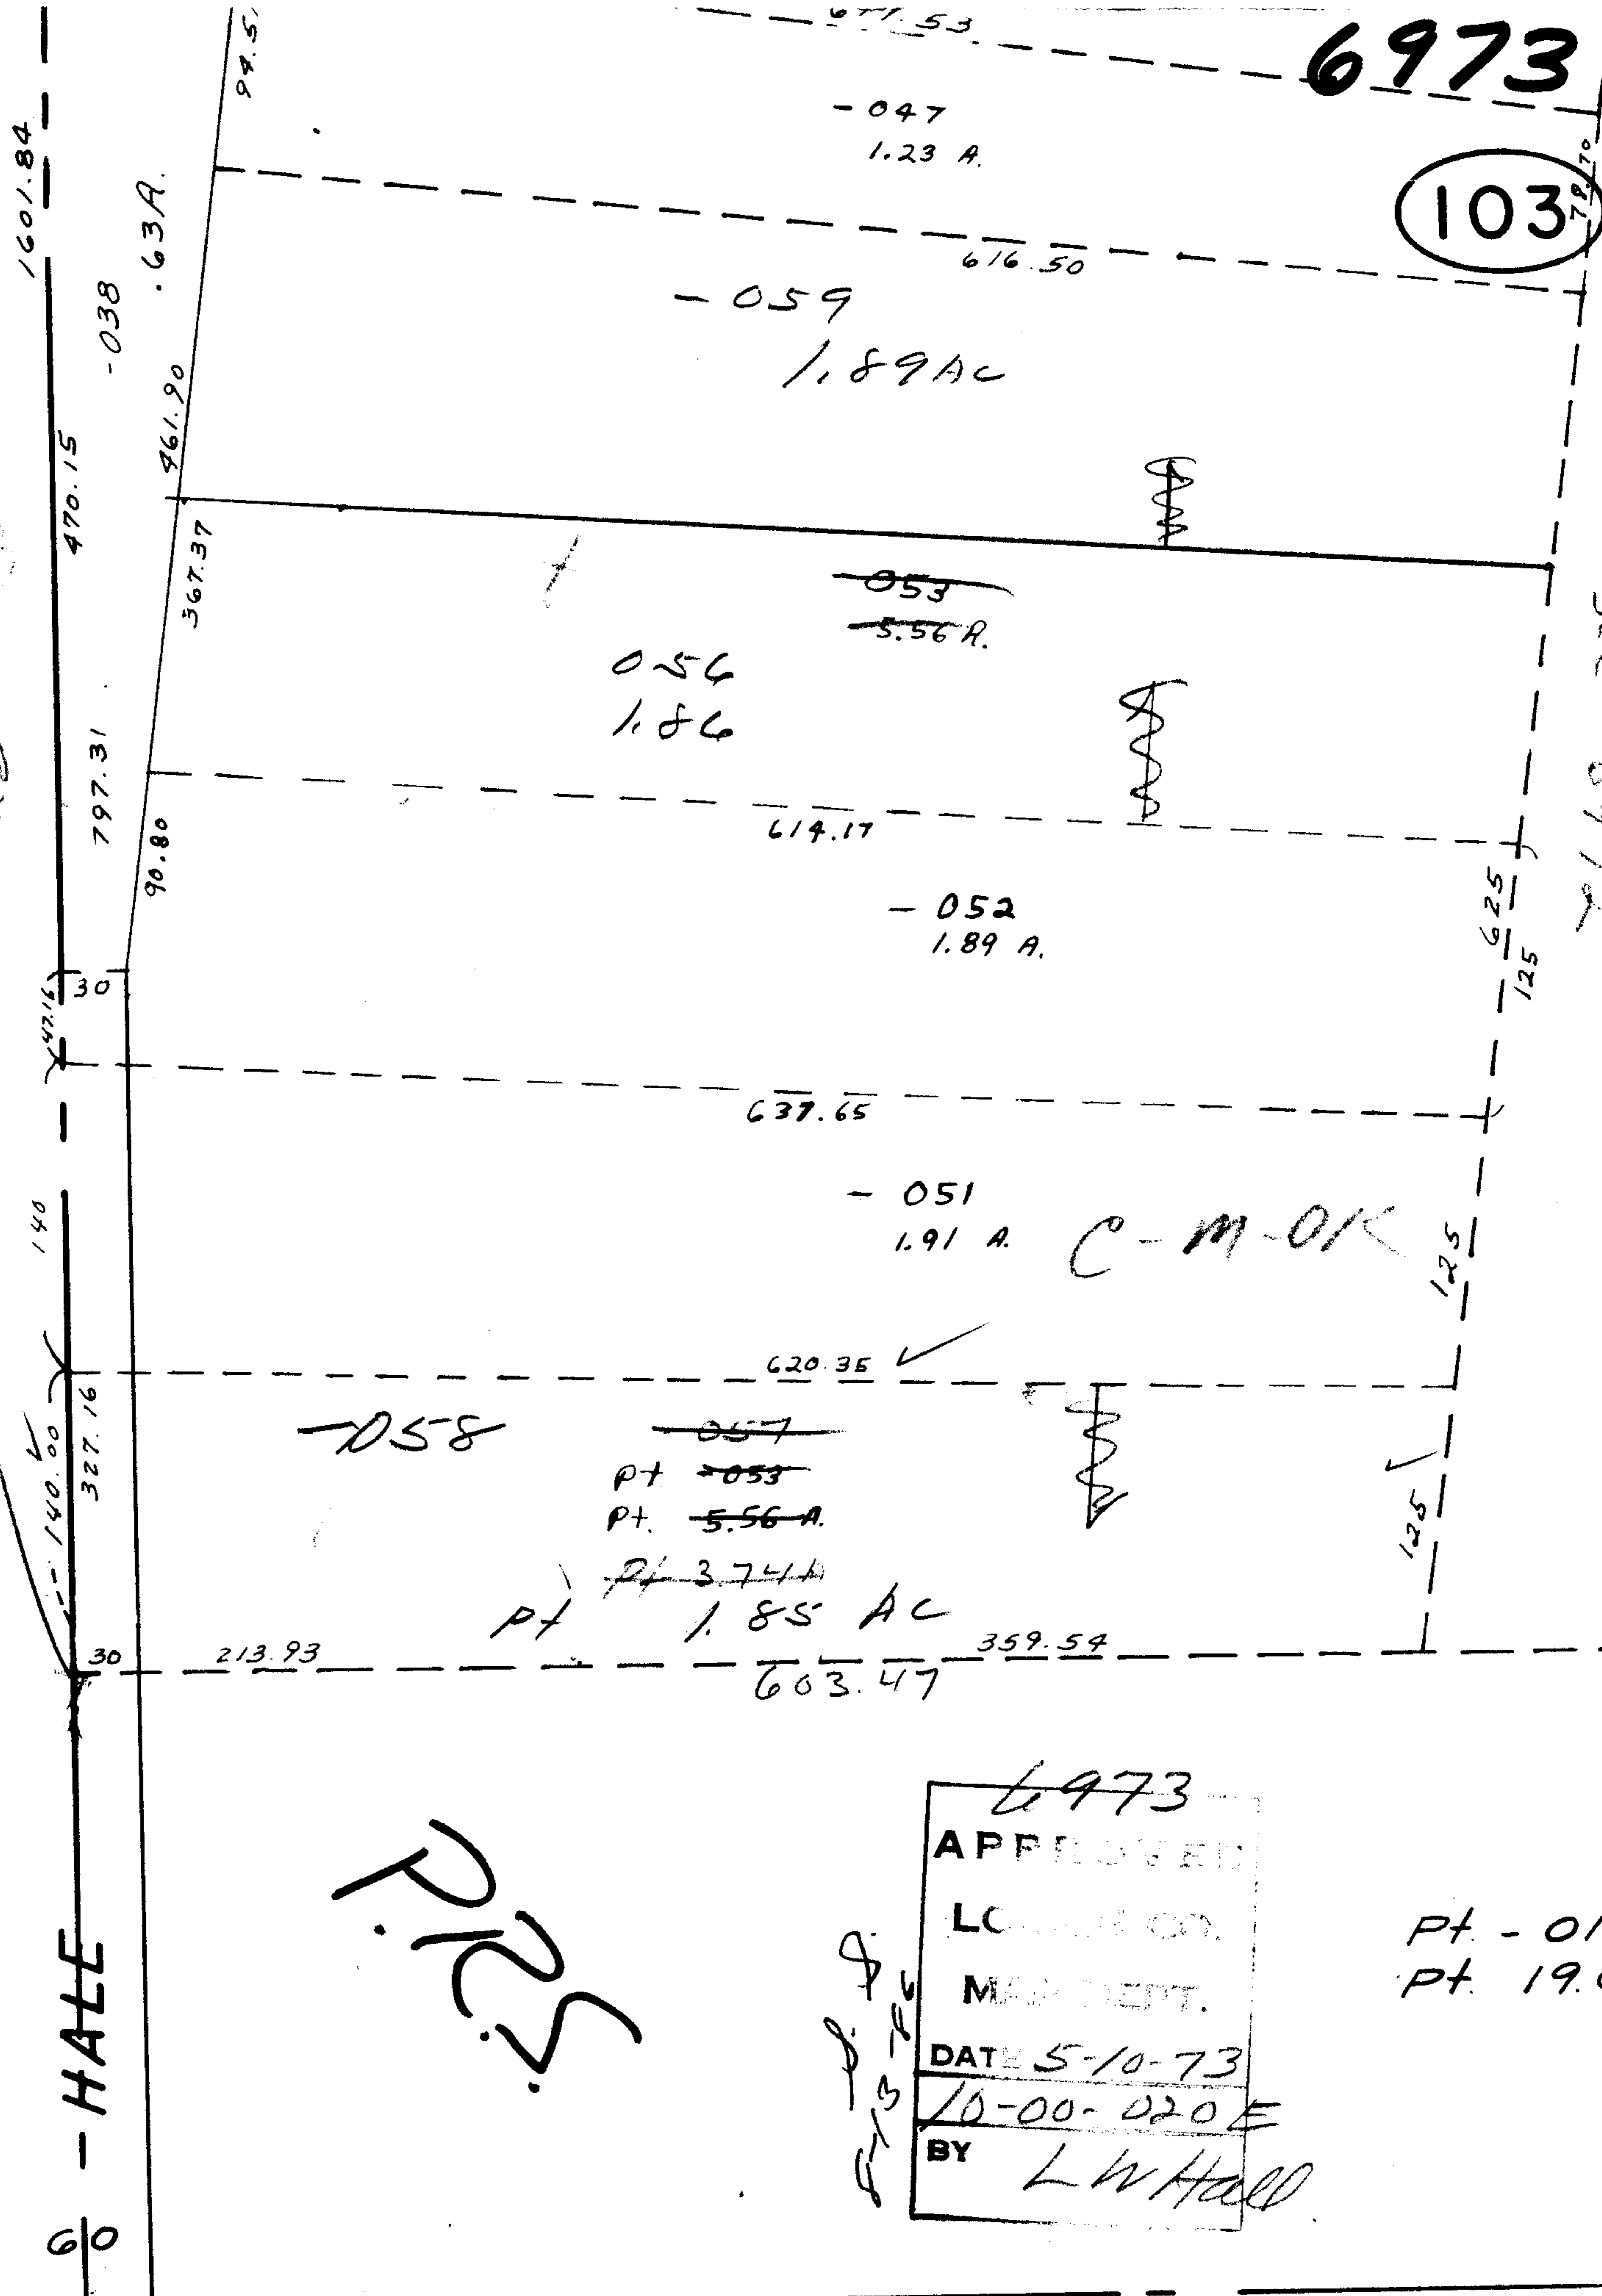

1601.84
470.15
797.31
140
140.00
327.16
30

See 6972
2660

P.S.

6973

APPROVED

LC. CO.

MAN. DEPT.

DATE 5-10-73

10-00-020E

BY LWHall

PT - 016
PT - 19.0

SEI