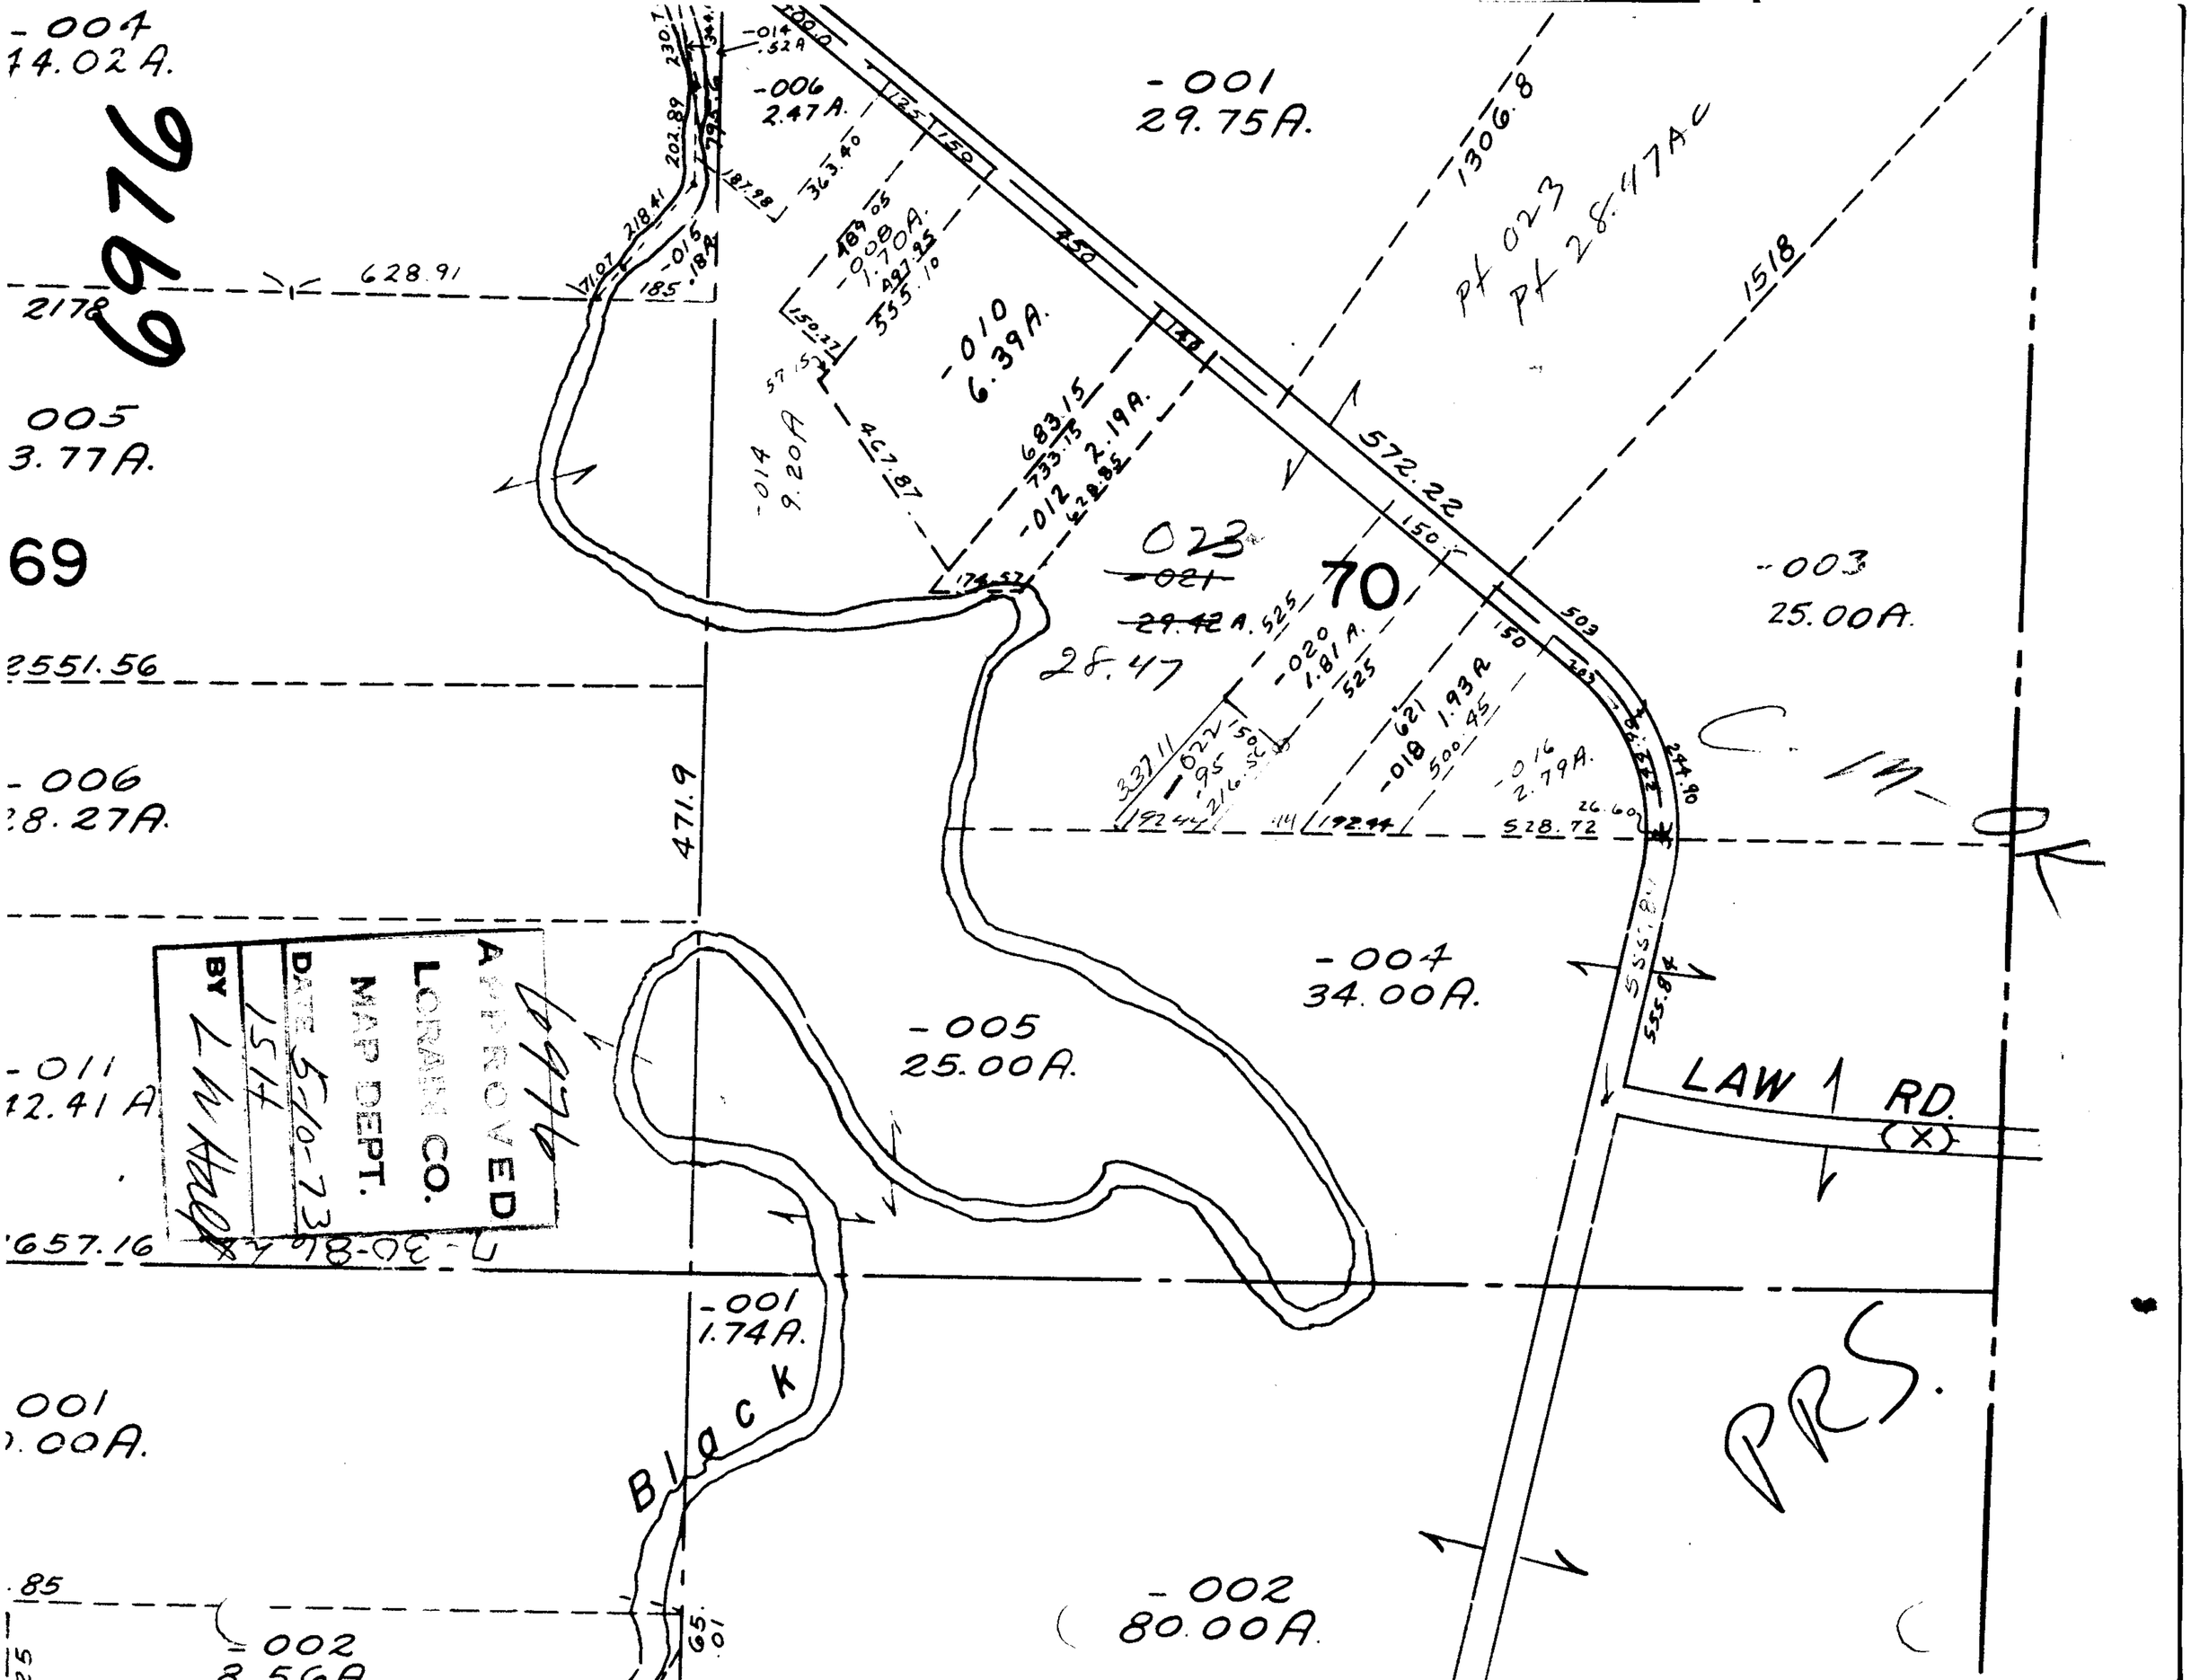

-004
14.02A.
6976
-006
2.47A.
-001
29.75A.
1306.8
pt 023
pt 28.47Ac
1518
628.91
2178
-010
6.39A.
-014
9.20A
-012
2.19A.
572.22
-003
25.00A.
005
3.77A.
69
023
-021
29.42A.
70
28.47
-020
1.81A.
-018
1.93A
-016
2.79A.
528.72
2551.56
-006
28.27A.
471.9
-004
34.00A.
-005
25.00A.
-011
12.41A
LAW RD.
(X)
657.16
-001
1.74A.
Black
001
.00A.
PRS.
-002
80.00A.
-002
APPROVED
LORAIN CO.
MAP DEPT.
DATE 5-10-73
BY