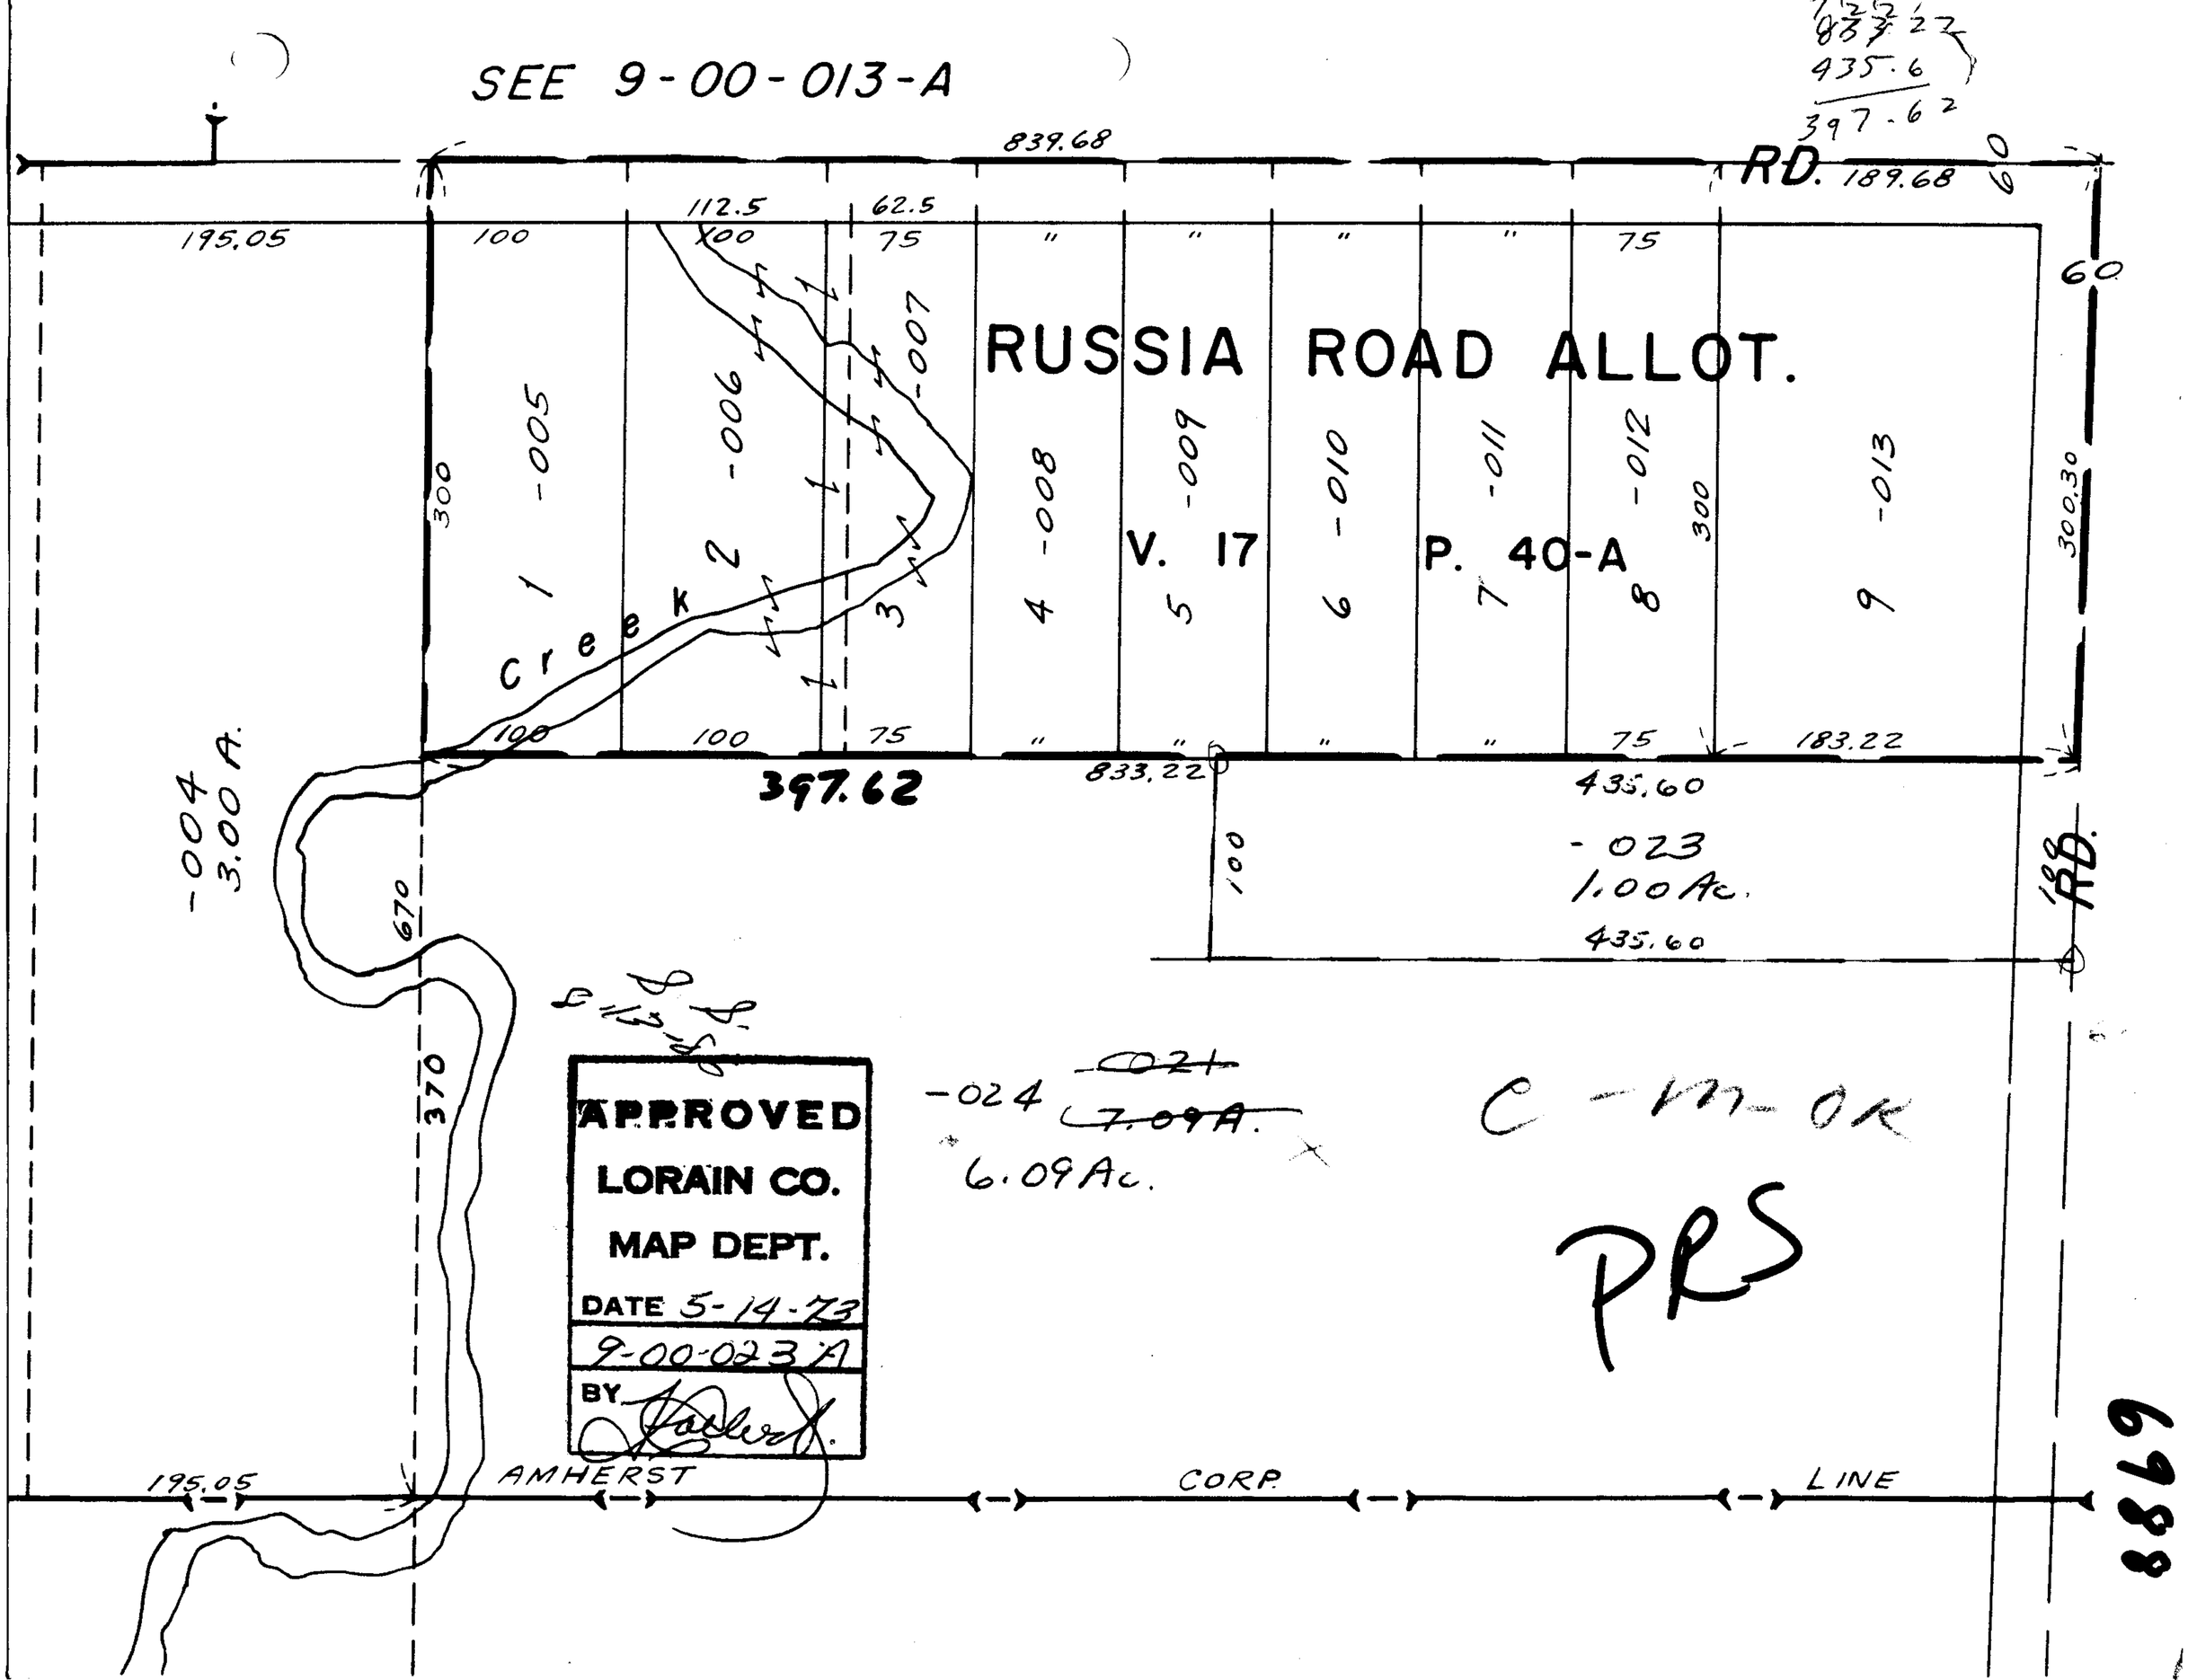
SEE 9-00-013-A
839.68
RD. 189.68
60
195.05
100
112.5
100
62.5
75
75
60
RUSSIA ROAD ALLOT.
V. 17
P. 40-A
1 -005
2 -006
3 -007
4 -008
5 -009
6 -010
7 -011
8 -012
9 -013
300
300
300.30
Creek
100
100
75
75
183.22
397.62
833.22
435.60
-023
1.00 Ac.
435.60
100
RD.
-004
3.00 A.
670
370
-024
~~-021~~
~~7.09 A.~~
6.09 Ac.
C-M-OK
PRS
APPROVED
LORAIN CO.
MAP DEPT.
DATE 5-14-73
9-00-023 A
BY
195.05
AMHERST
CORP.
LINE
6988