


461.13
501.17
962.30

C-M-O-K

Pg. 9D

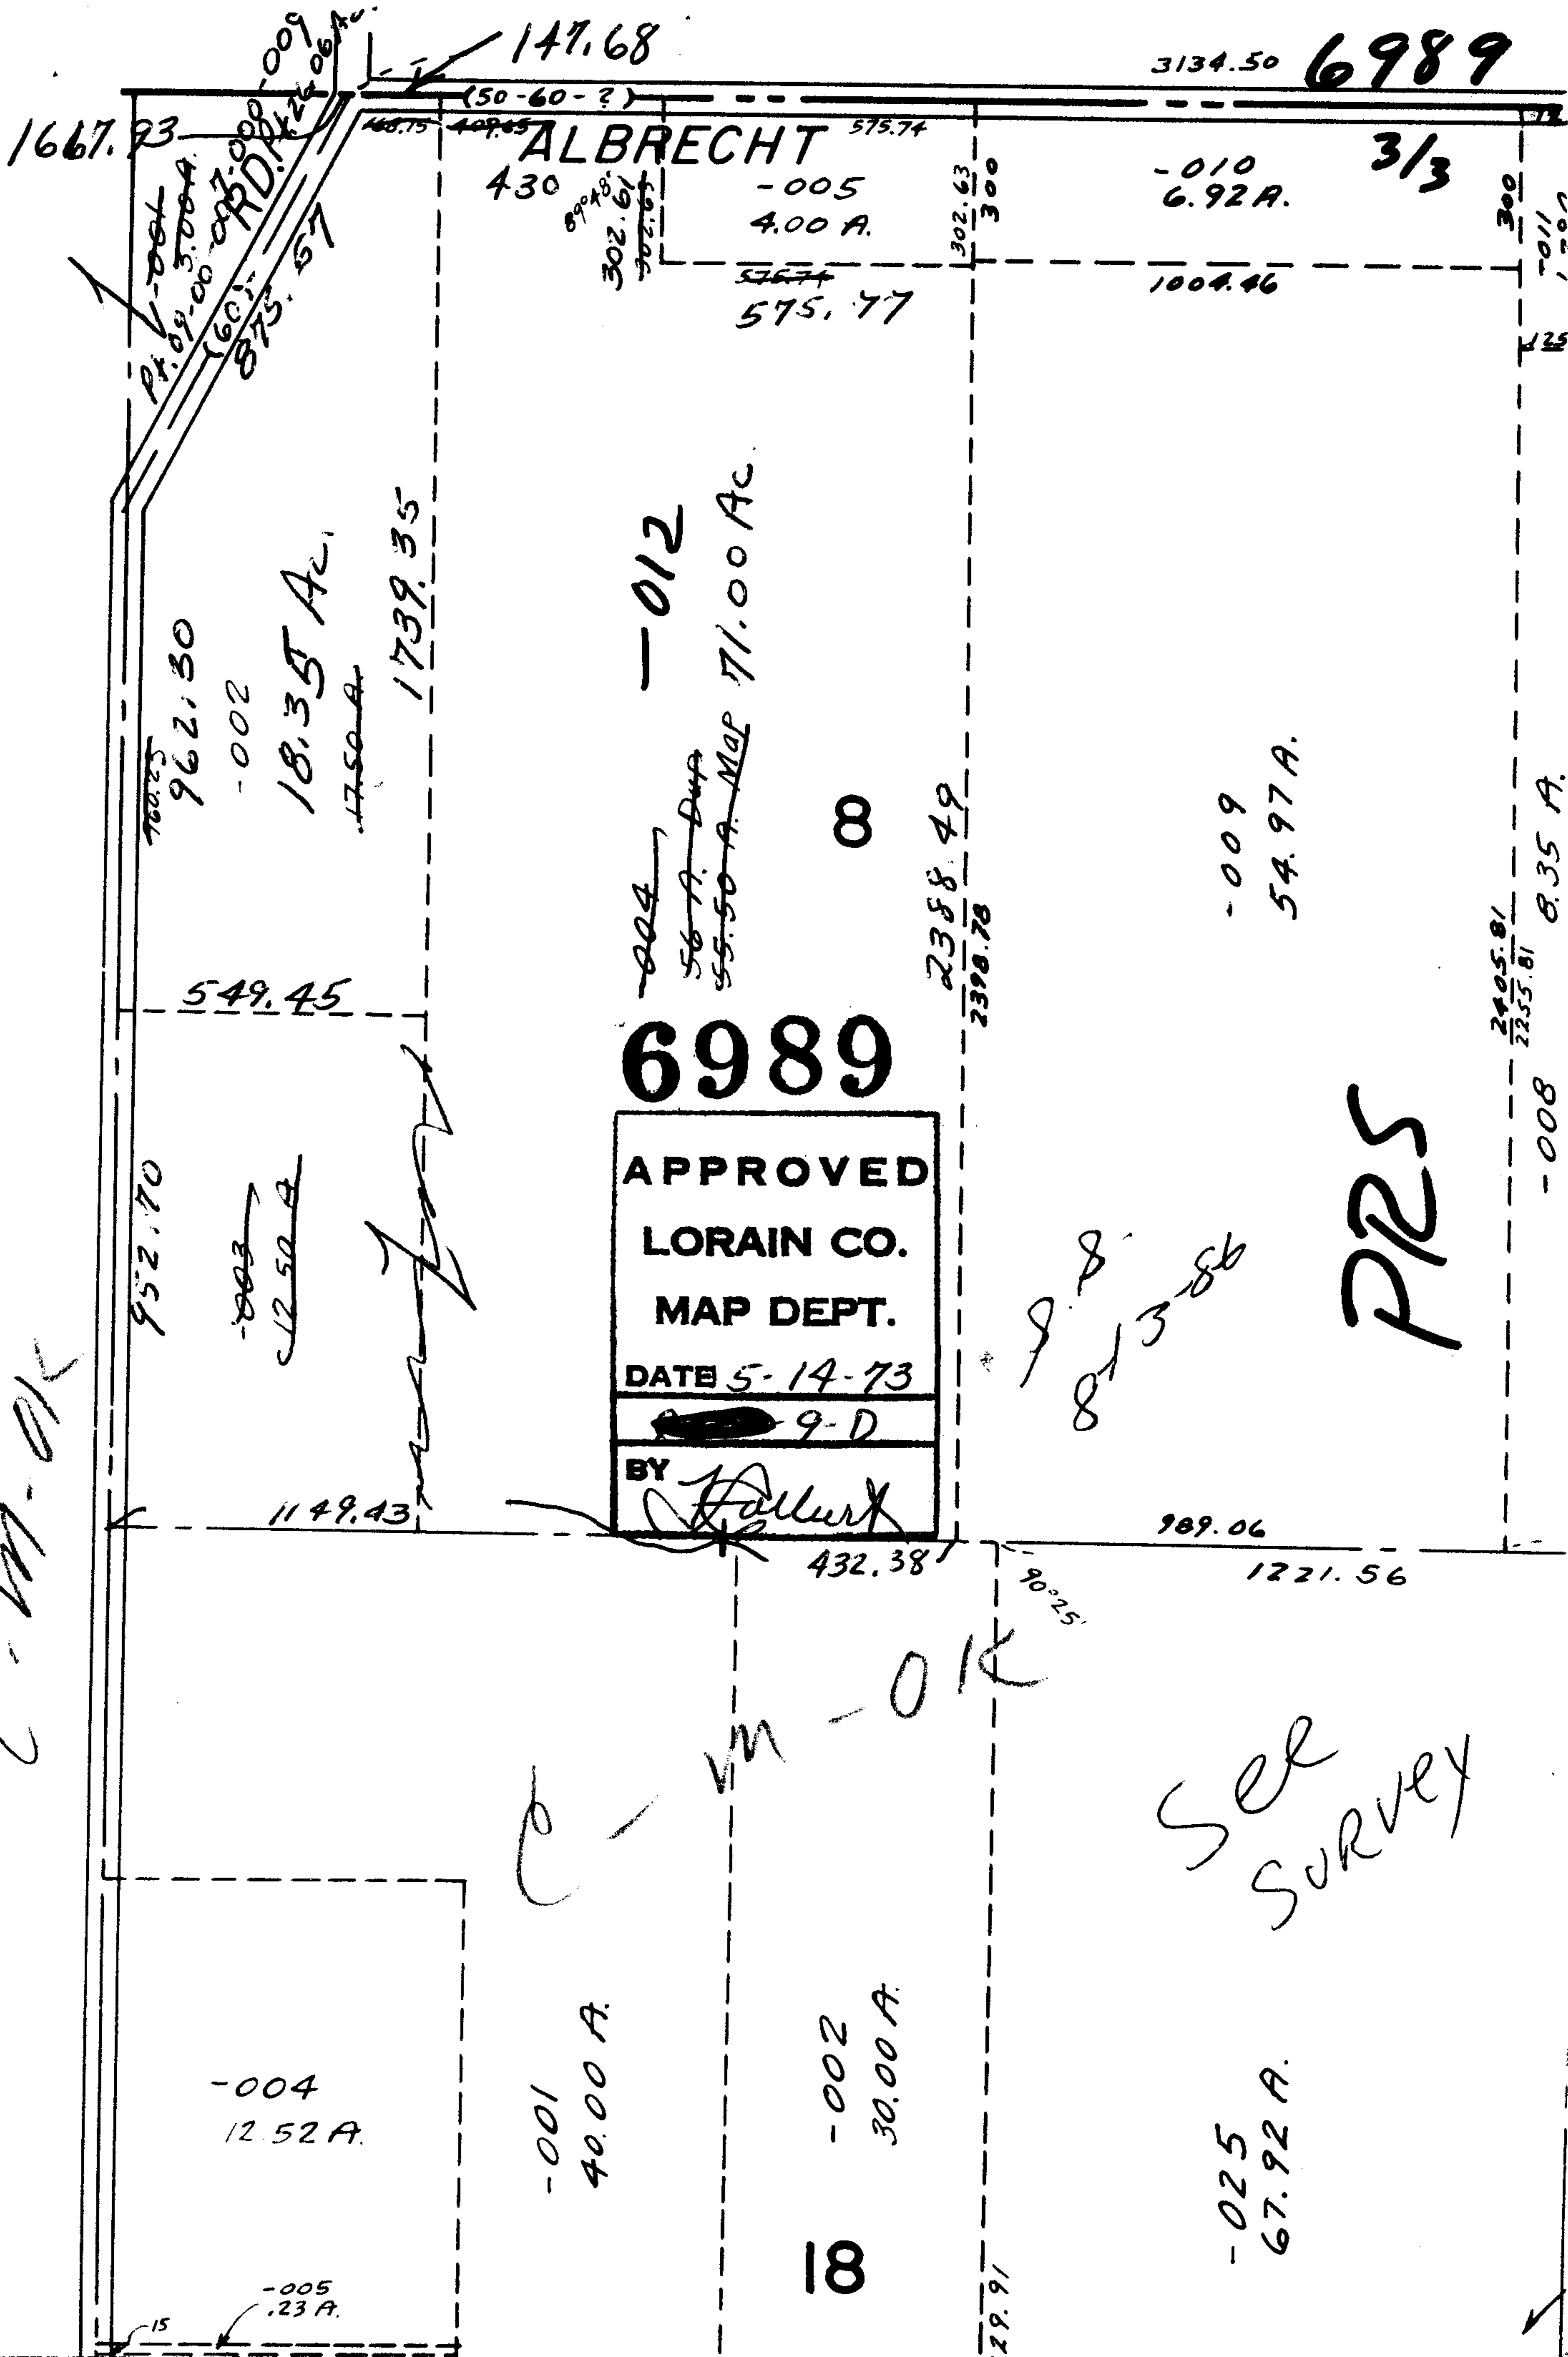

PR25

See Survey