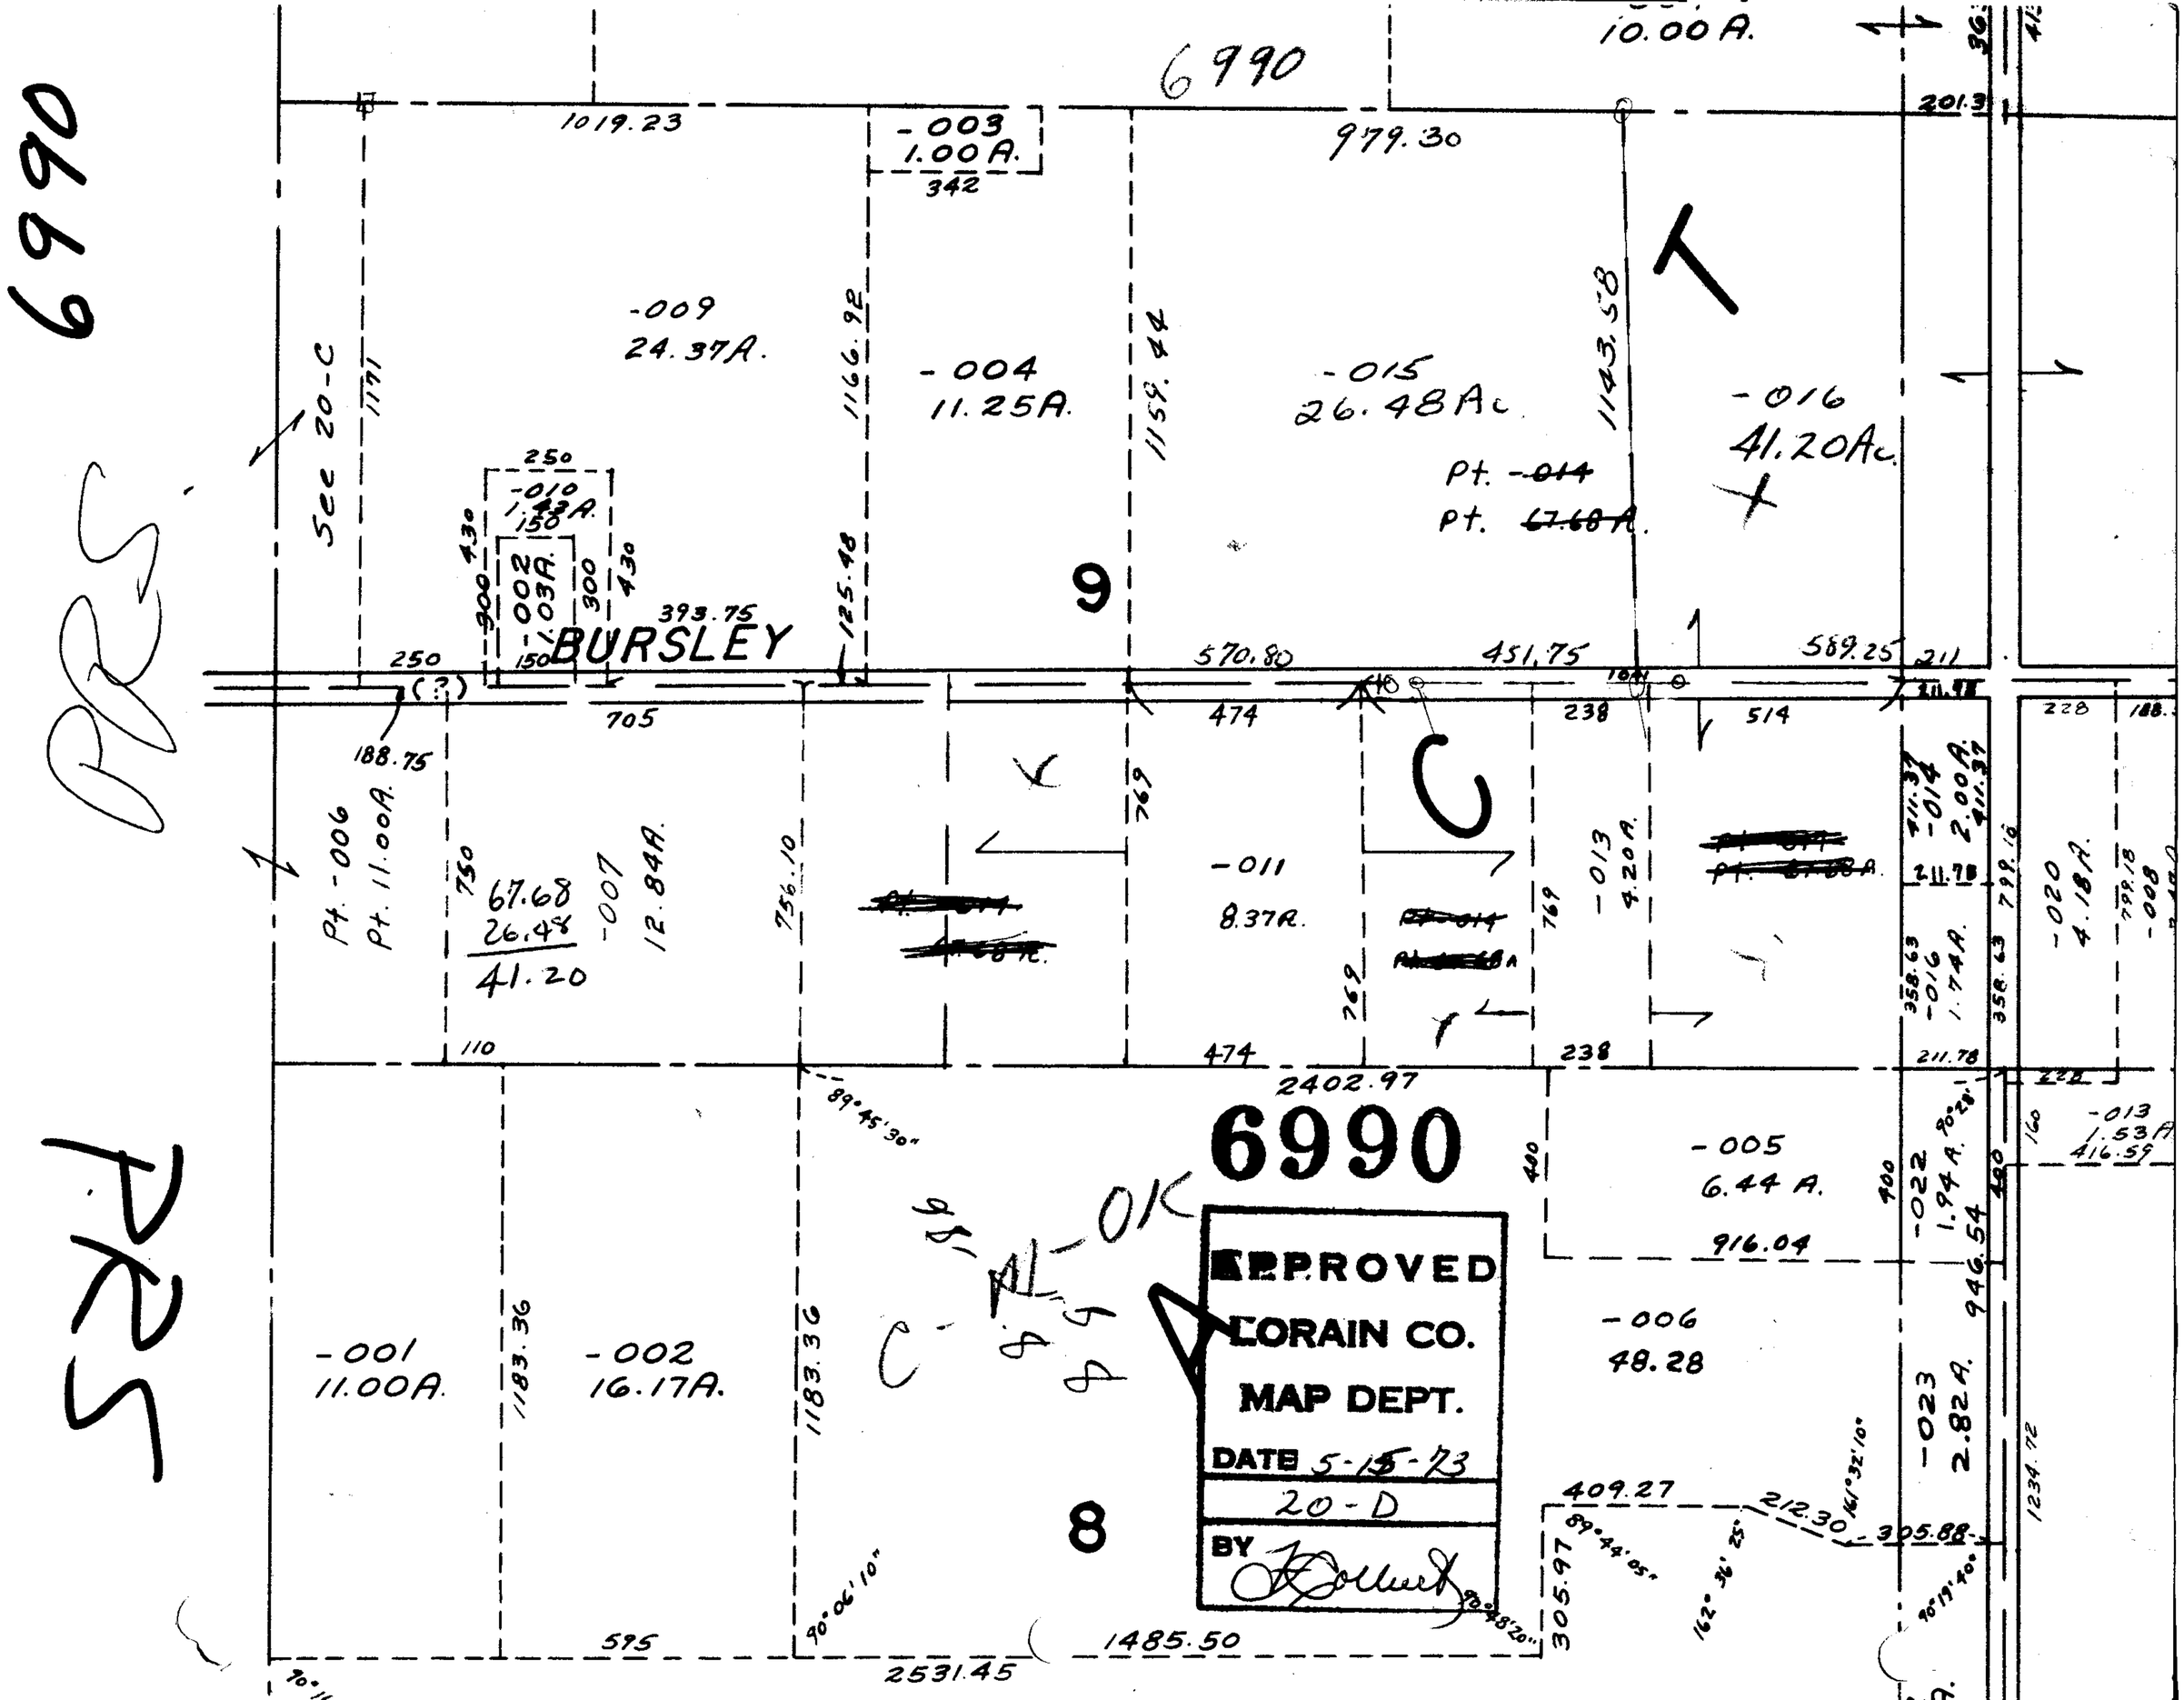
6990
10.00 A.
1019.23
-003
1.00 A.
342
979.30
201.3
-009
24.37A.
1166.92
-004
11.25A.
1159.44
-015
26.48Ac
1143.58
-016
41.20Ac.
Pt. -014
Pt. 67.68 A.
See 20-C
1171
250
-010
1.43A.
150
430
300
-002
1.03A.
150
300
430
393.75
125.48
9
BURSLEY
250
570.80
451.75
589.25
211
705
474
238
514
228
188.75
Pt. -006
Pt. 11.00A.
750
67.68
26.48
41.20
-007
12.84A.
756.10
769
-011
8.37A.
769
-013
4.20A.
769
-014
2.00A.
211.78
799.18
-020
4.18A.
-008
358.63
-016
1.74A.
358.63
110
474
238
211.78
228
2402.97
89°45'30"
6990
-005
6.44 A.
916.04
400
-022
1.94 A.
90°28'
-013
1.53A
416.59
160
400
946.54
-001
11.00A.
1183.36
-002
16.17A.
1183.36
-006
48.28
-023
2.82A.
1234.72
409.27
212.30
305.88
89°44'05"
305.97
162°36'25"
161°32'10"
90°19'40"
90°48'20"
90°06'10"
8
595
1485.50
2531.45
APPROVED
LORAIN CO.
MAP DEPT.
DATE 5-15-73
20-D
BY
PRS
PRS