


6993
SEE SURVEY

6993
APPROVED
LORAIN CO.
MAP DEPT.
DATE 5-15-73
14-F
BY [Signature]

C-M-OK

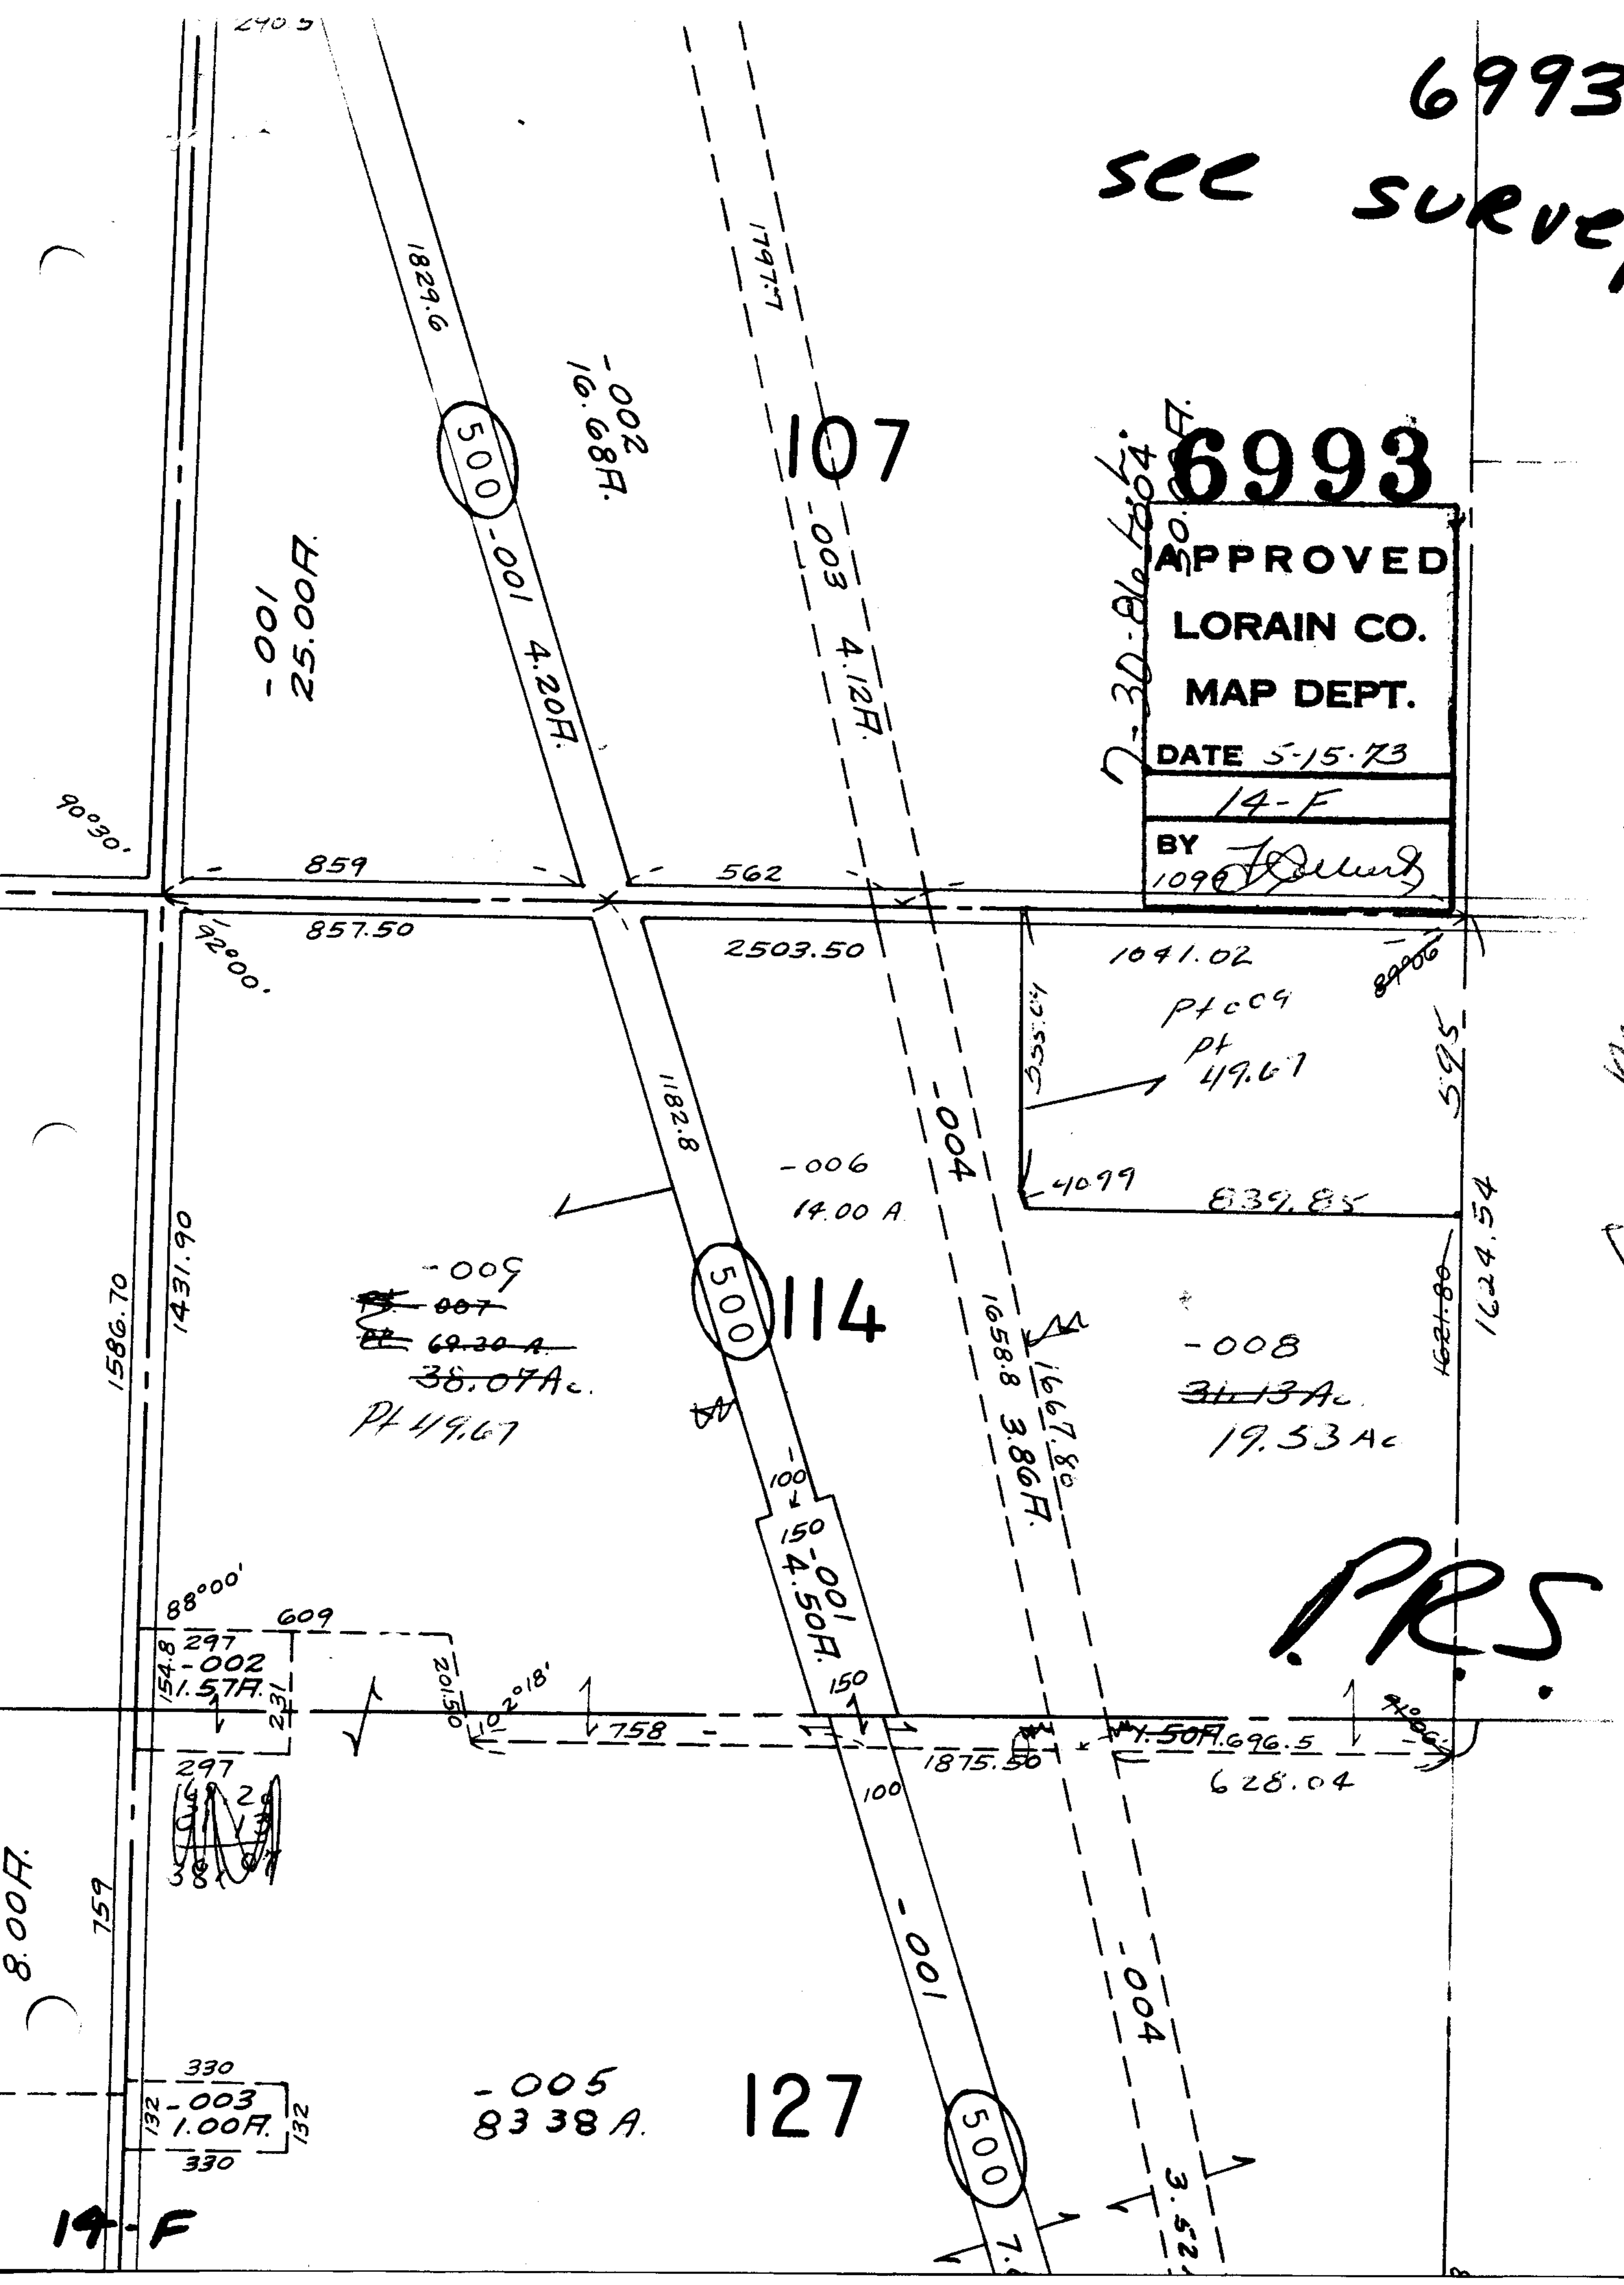

P.R.S.

14-F