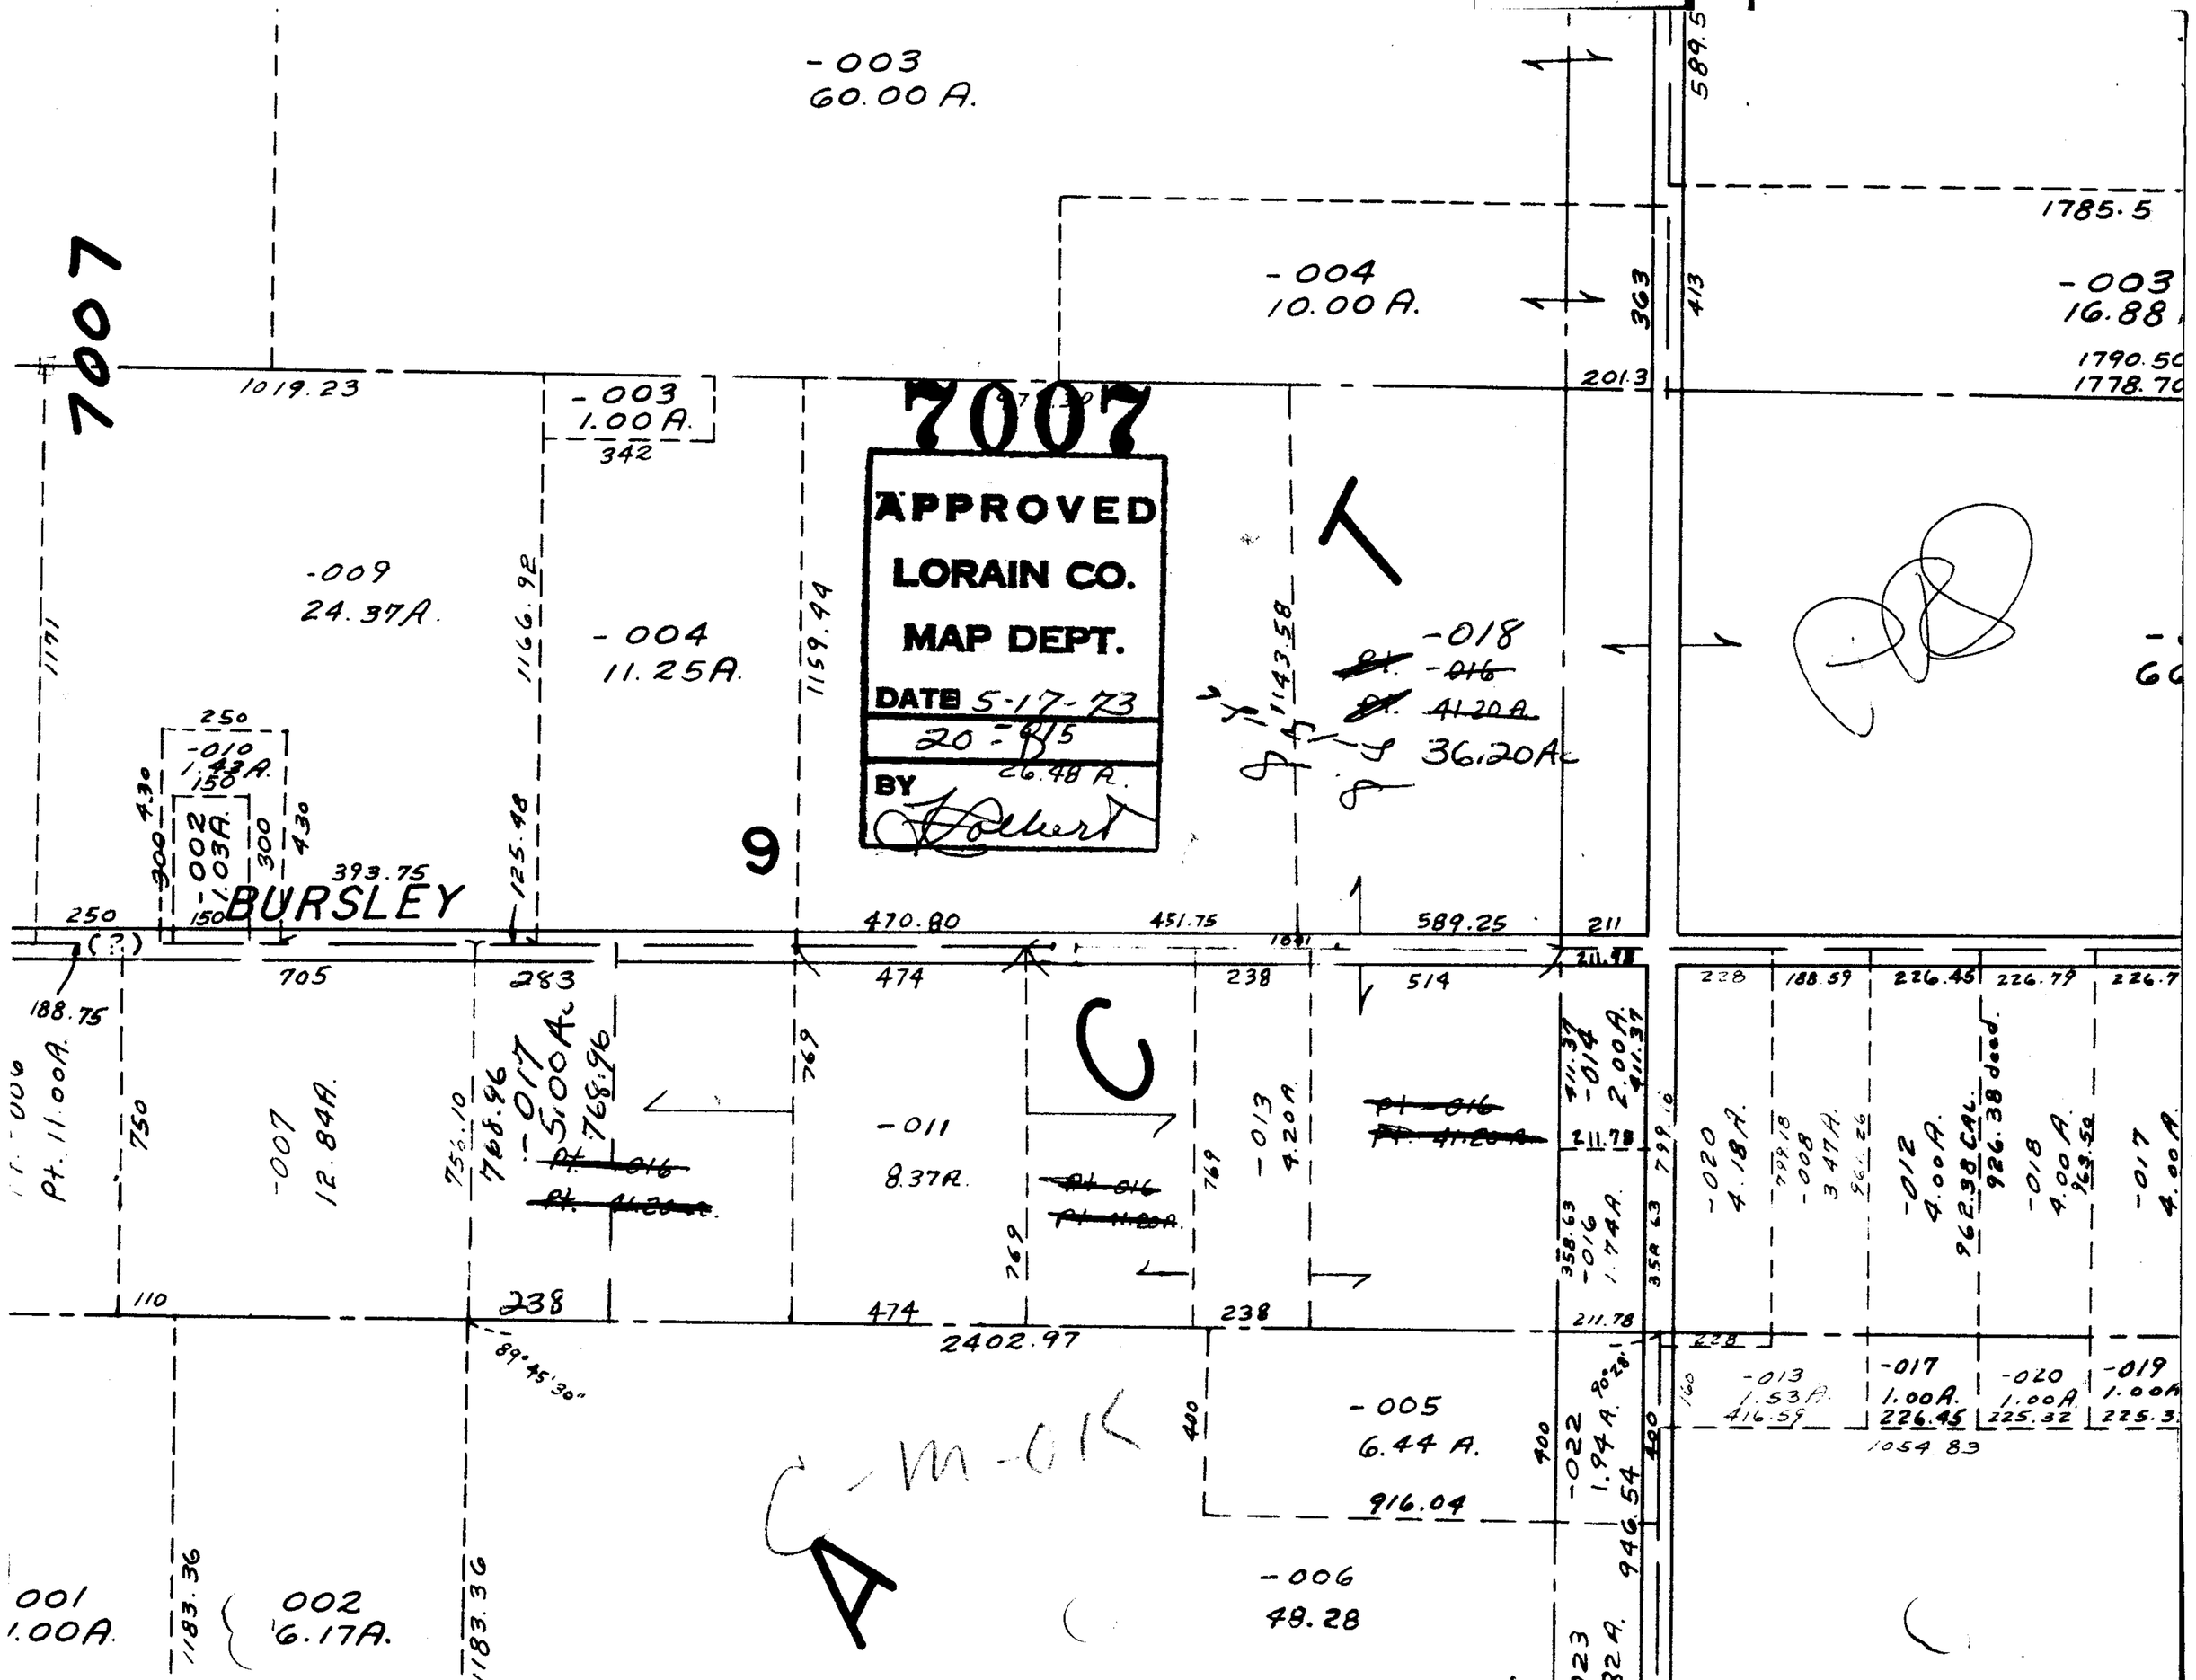

7007
APPROVED
LORAIN CO.
MAP DEPT.
DATE 5-17-73
20-015
26.48 A.
BY
-003
60.00 A.
-004
10.00 A.
-003
16.88
1785.5
1790.50
1778.70
1019.23
-003
1.00 A.
342
-009
24.37A.
-004
11.25A.
1166.92
1159.44
1143.58
-018
-016
41.20 A.
36.20Ac
-010
1.43A.
-002
1.03A.
393.75
BURSLEY
125.48
9
470.80
451.75
589.25
211
705
283
474
238
514
188.75
Pt. 11.00A.
-007
12.84A.
-017
5.00Ac
768.96
-011
8.37A.
-013
4.20A.
-014
2.00A.
-016
1.74A.
-020
4.18A.
-008
3.47A.
-012
4.00A.
962.38 CAL.
926.38 deed
-018
4.00A.
-017
4.00A.
2402.97
89°45'30"
-005
6.44 A.
916.04
-022
1.94 A.
946.54
-013
1.53A.
416.59
-017
1.00A.
226.45
-020
1.00A.
225.32
-019
1.00A.
1054.83
-006
48.28
001
1.00A.
002
6.17A.
1183.36
C-M-OK
A