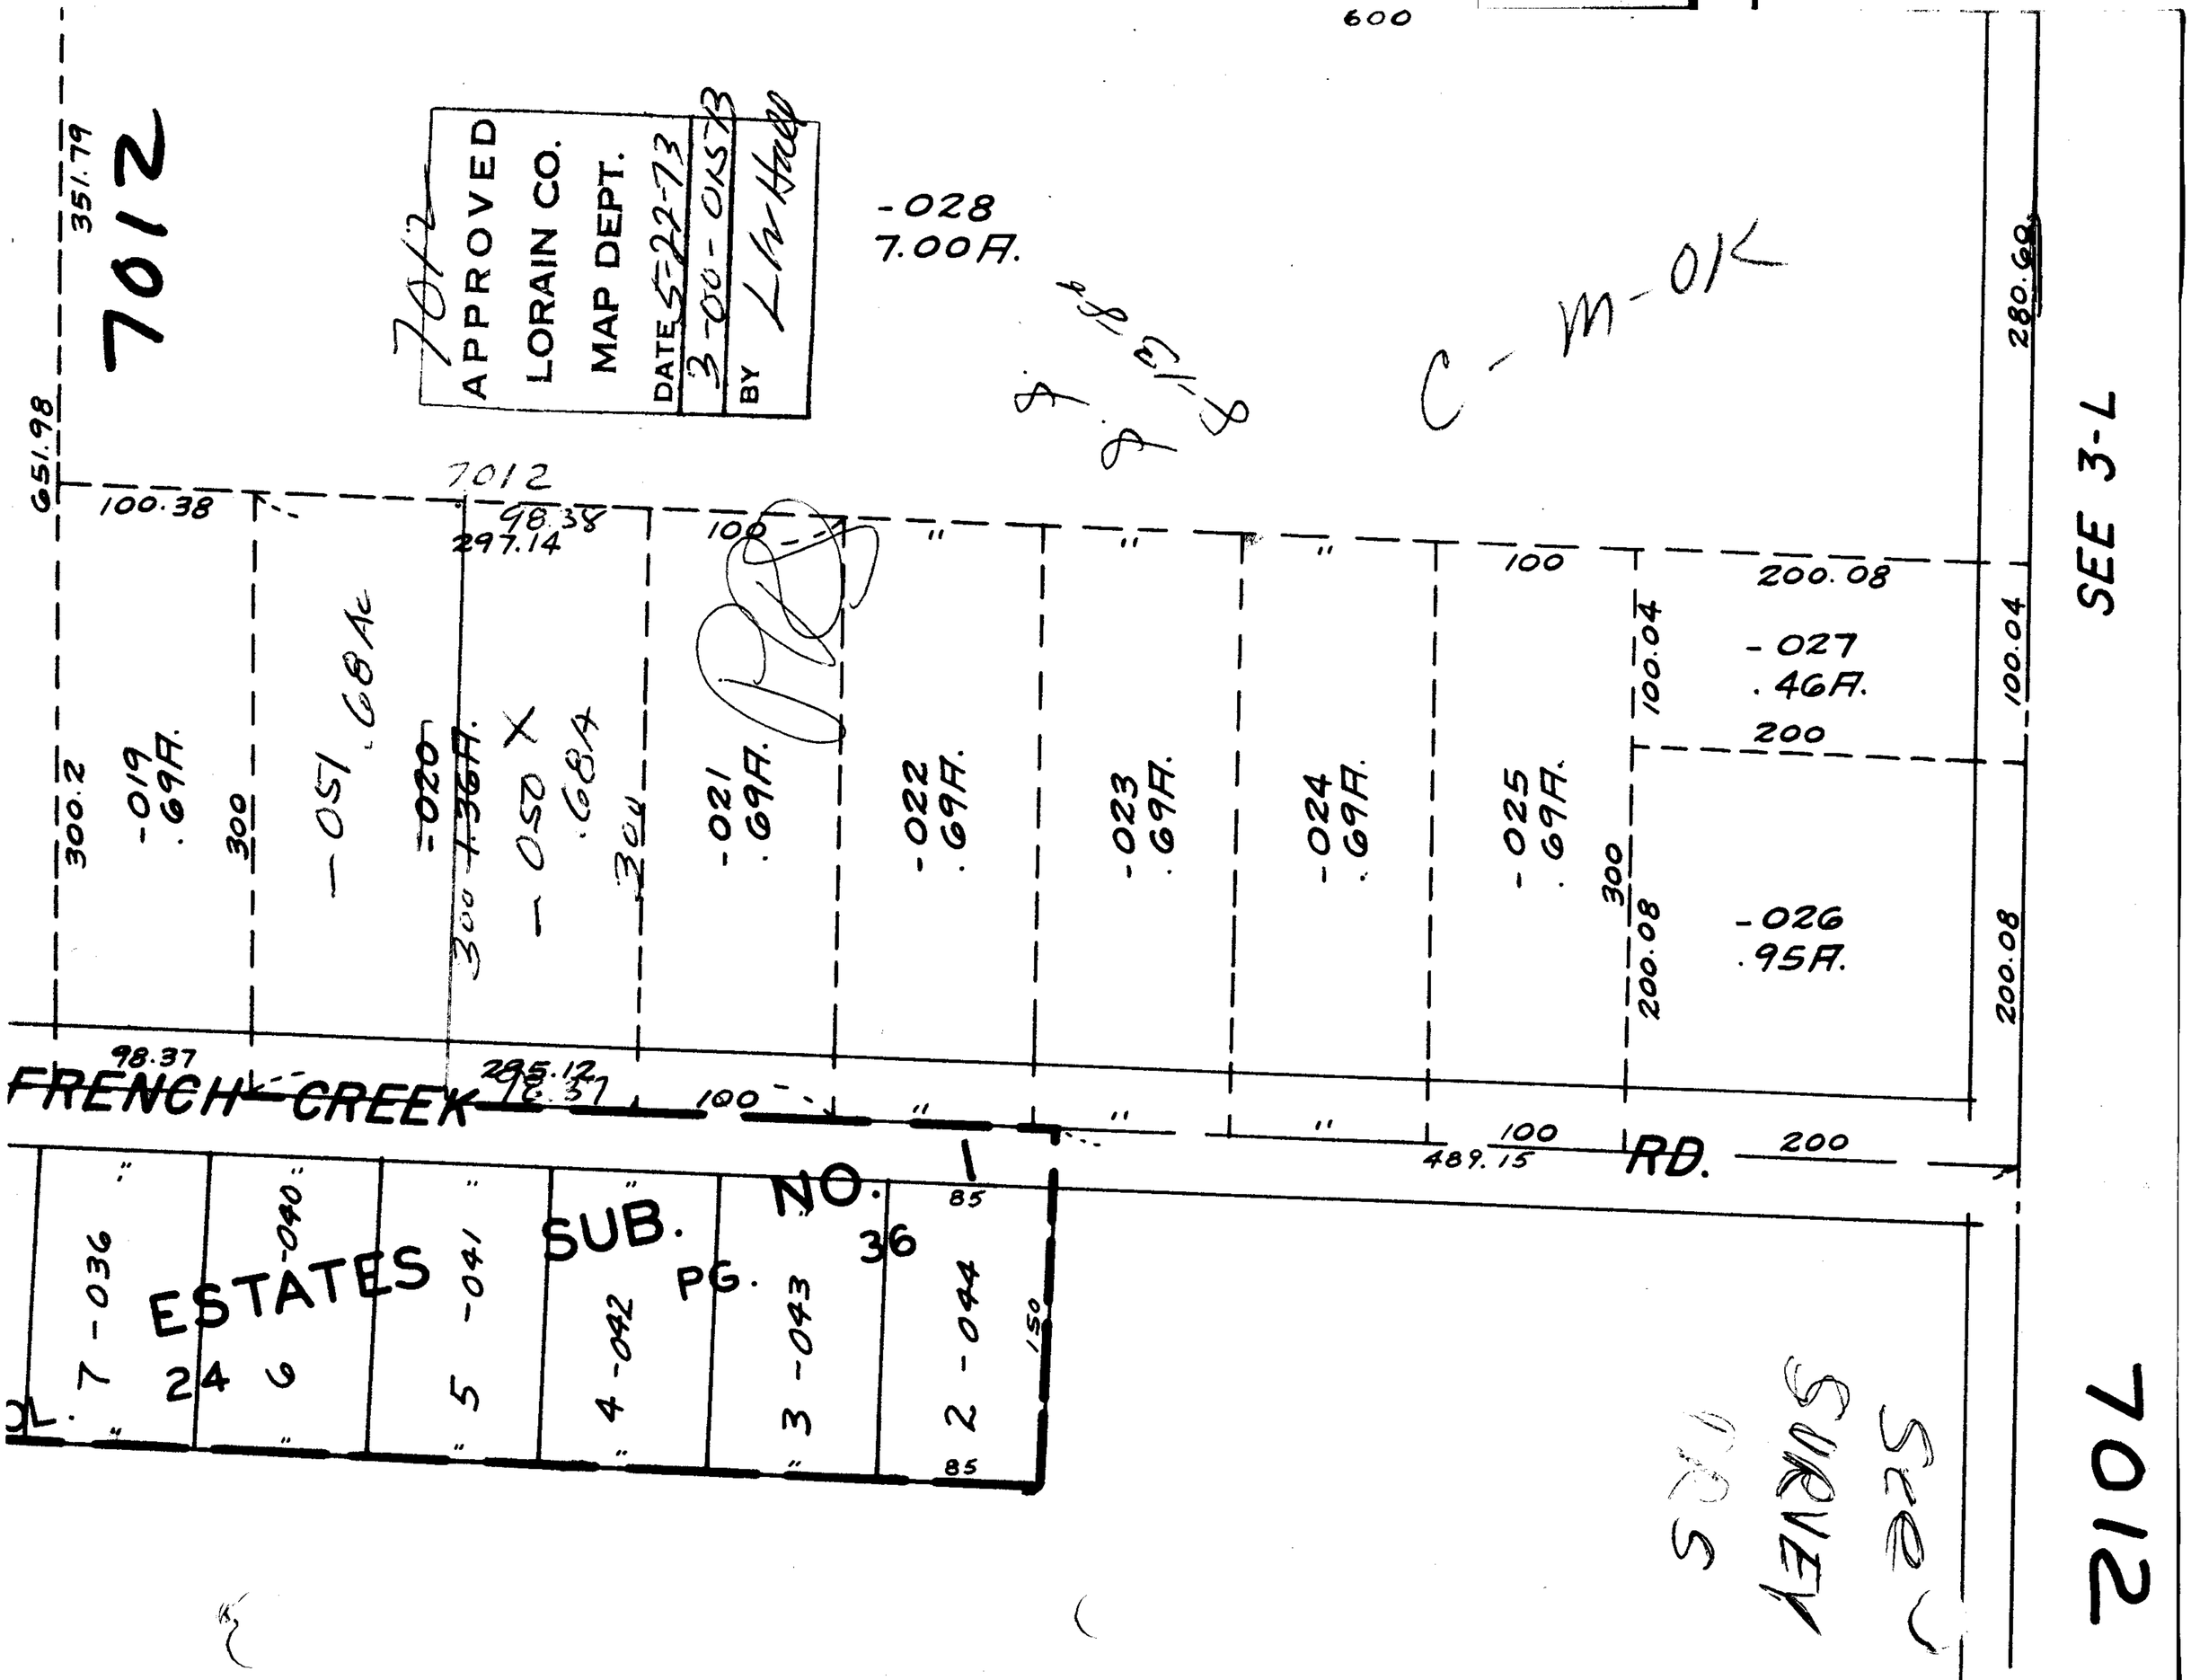

7012
APPROVED
LORAIN CO.
MAP DEPT.
DATE 5-22-73
3-00-015B
BY
-028
7.00A.
C-M-OK
600
351.79
651.98
100.38
7012
98.38
297.14
100
200.08
-027
.46A.
200
100.04
-019
.69A.
300.2
300
-051 .68Ac
-020
1.36A.
300
-050 X
.68A
300
-021
.69A.
-022
.69A.
-023
.69A.
-024
.69A.
-025
.69A.
300
200.08
-026
.95A.
200.08
280.60
SEE 3-L
98.37
295.12
FRENCH CREEK
100
100
489.15
RD.
200
ESTATES SUB. NO. 1
PG. 36
24
7-036
6-040
5-041
4-042
3-043
2-044
85
150
85
SEE SURVEY ORS
7012