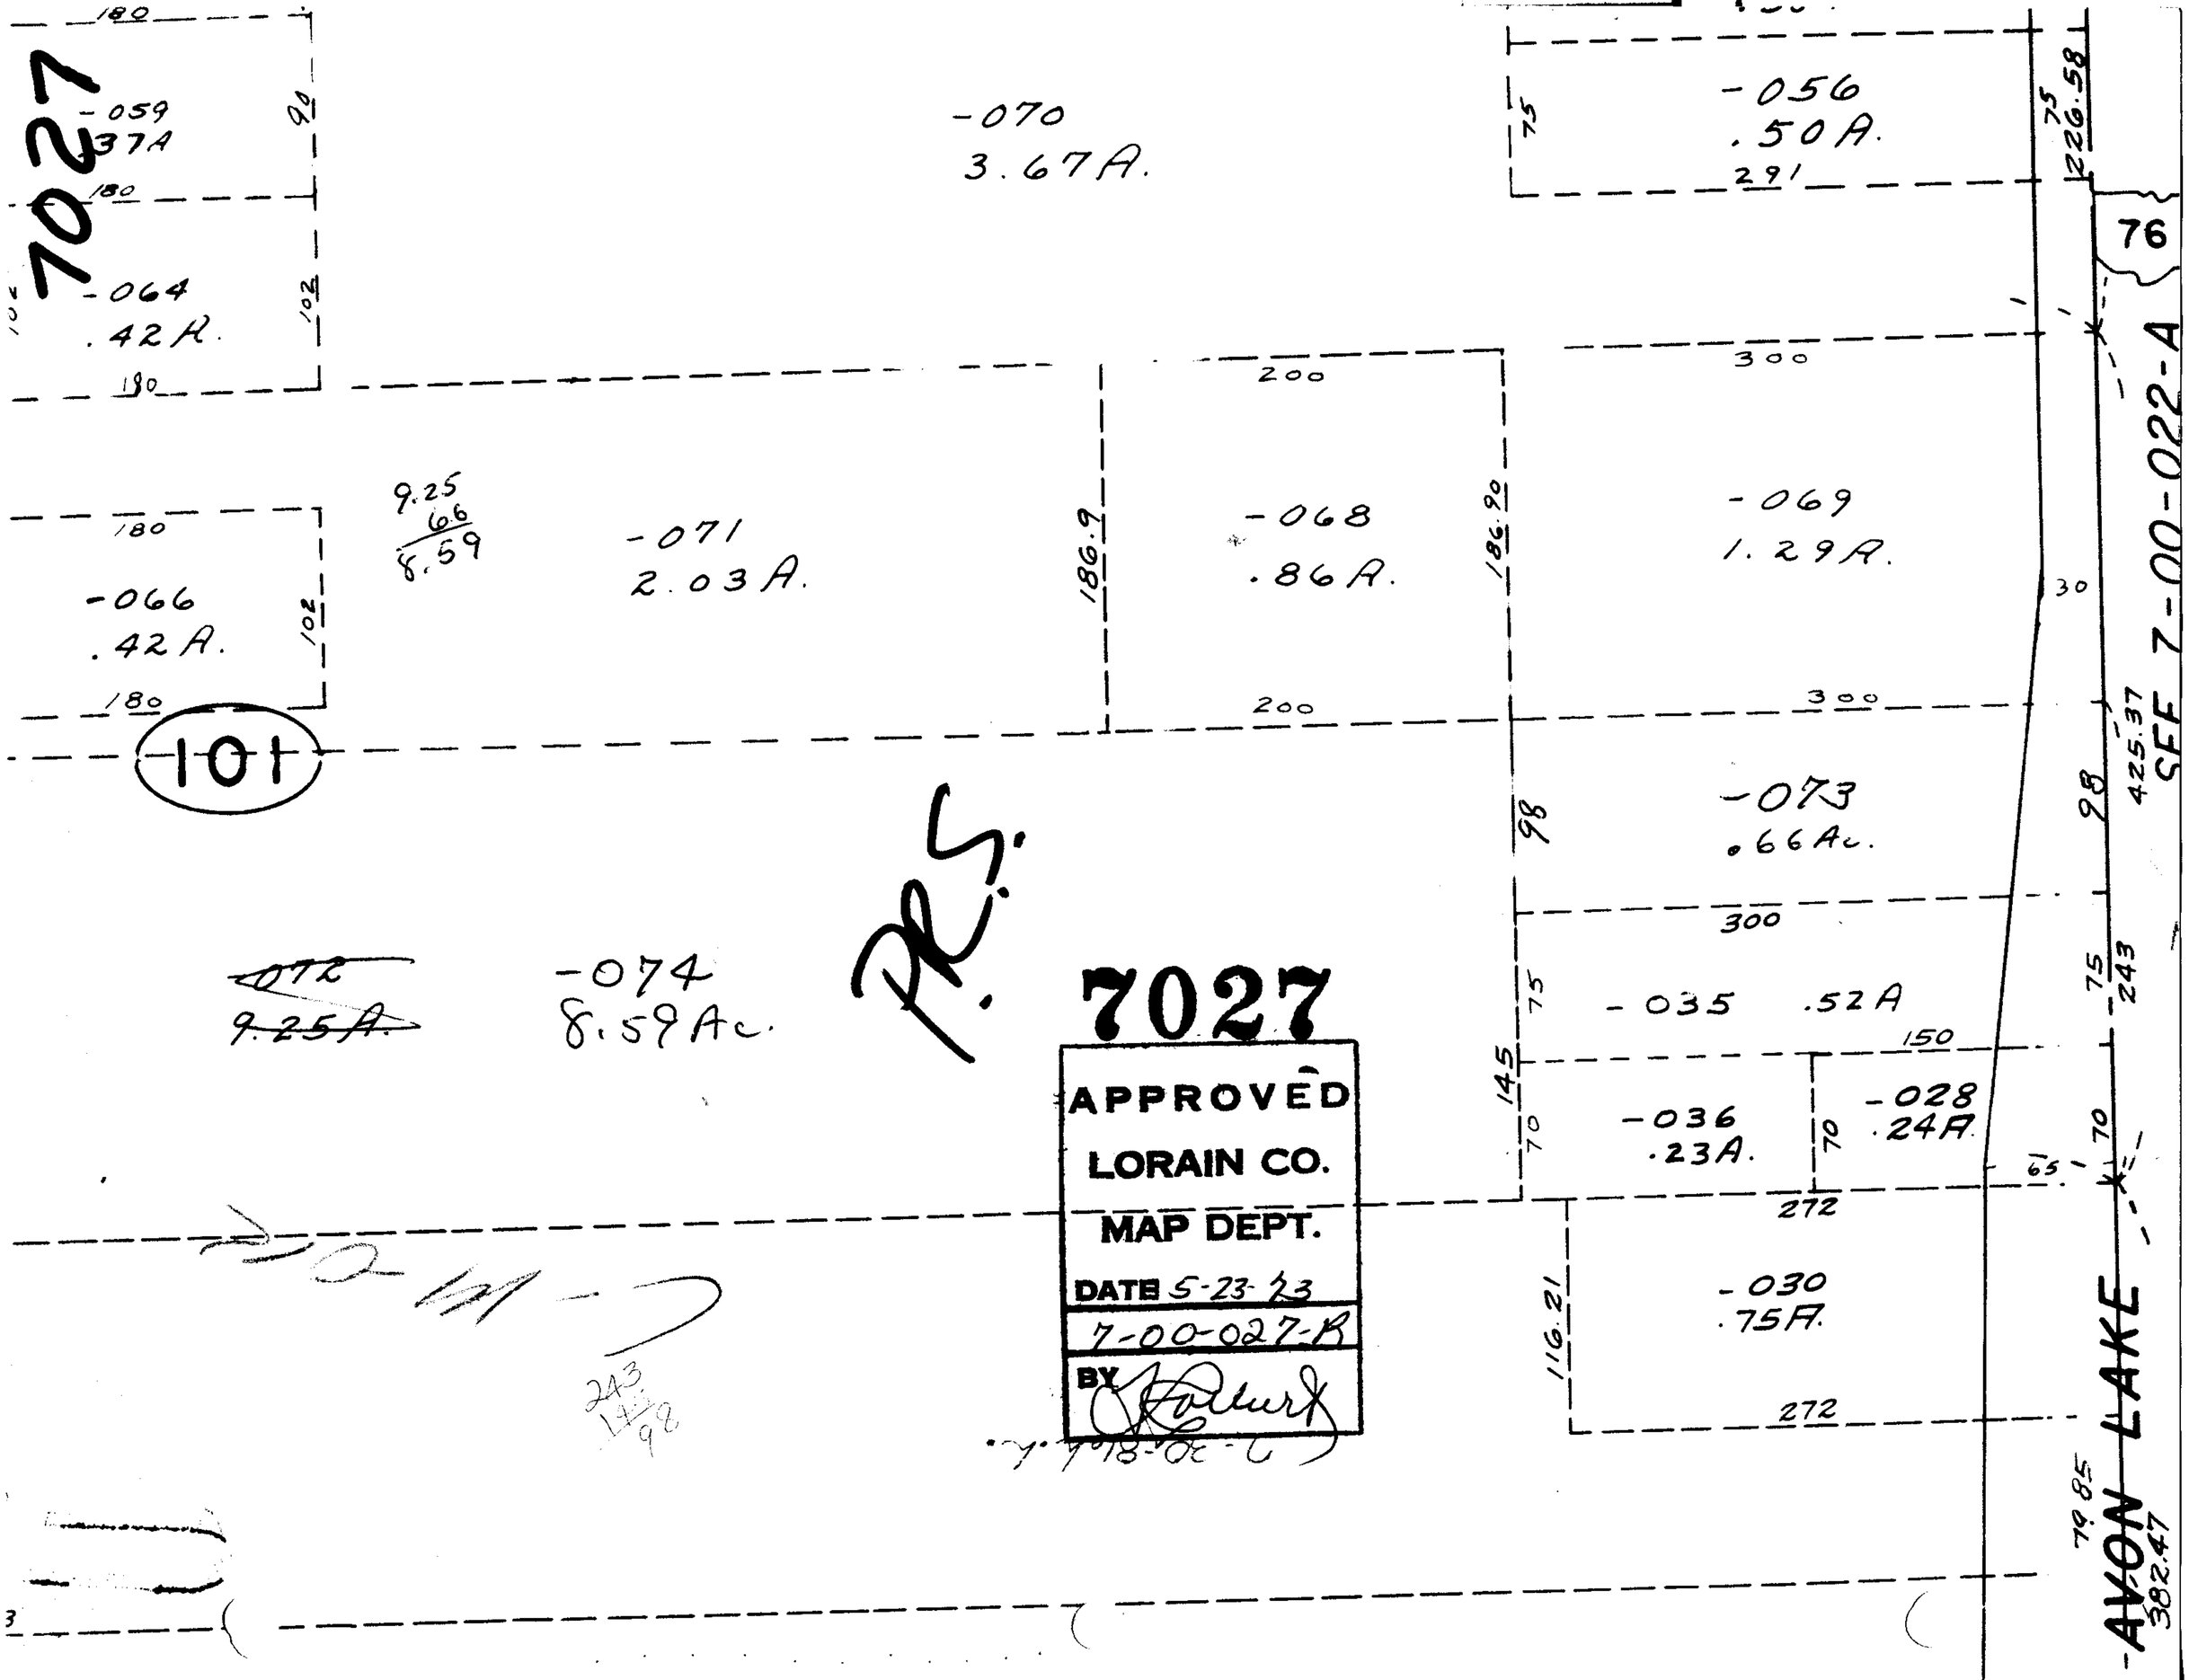
7027
-059
.37A
-064
.42A.
-070
3.67A.
-056
.50A.
76
-066
.42A.
9.25
66
8.59
-071
2.03A.
-068
.86A.
-069
1.29A.
101
-073
.66Ac.
-072
9.25A.
-074
8.59Ac.
-035
.52A
-036
.23A.
-028
.24A.
-030
.75A.
7027
APPROVED
LORAIN CO.
MAP DEPT.
DATE 5-23-23
7-00-027-B
BY
SEE 7-00-022-A
AVON LAKE
226.58
425.37
243
79.85
382.47