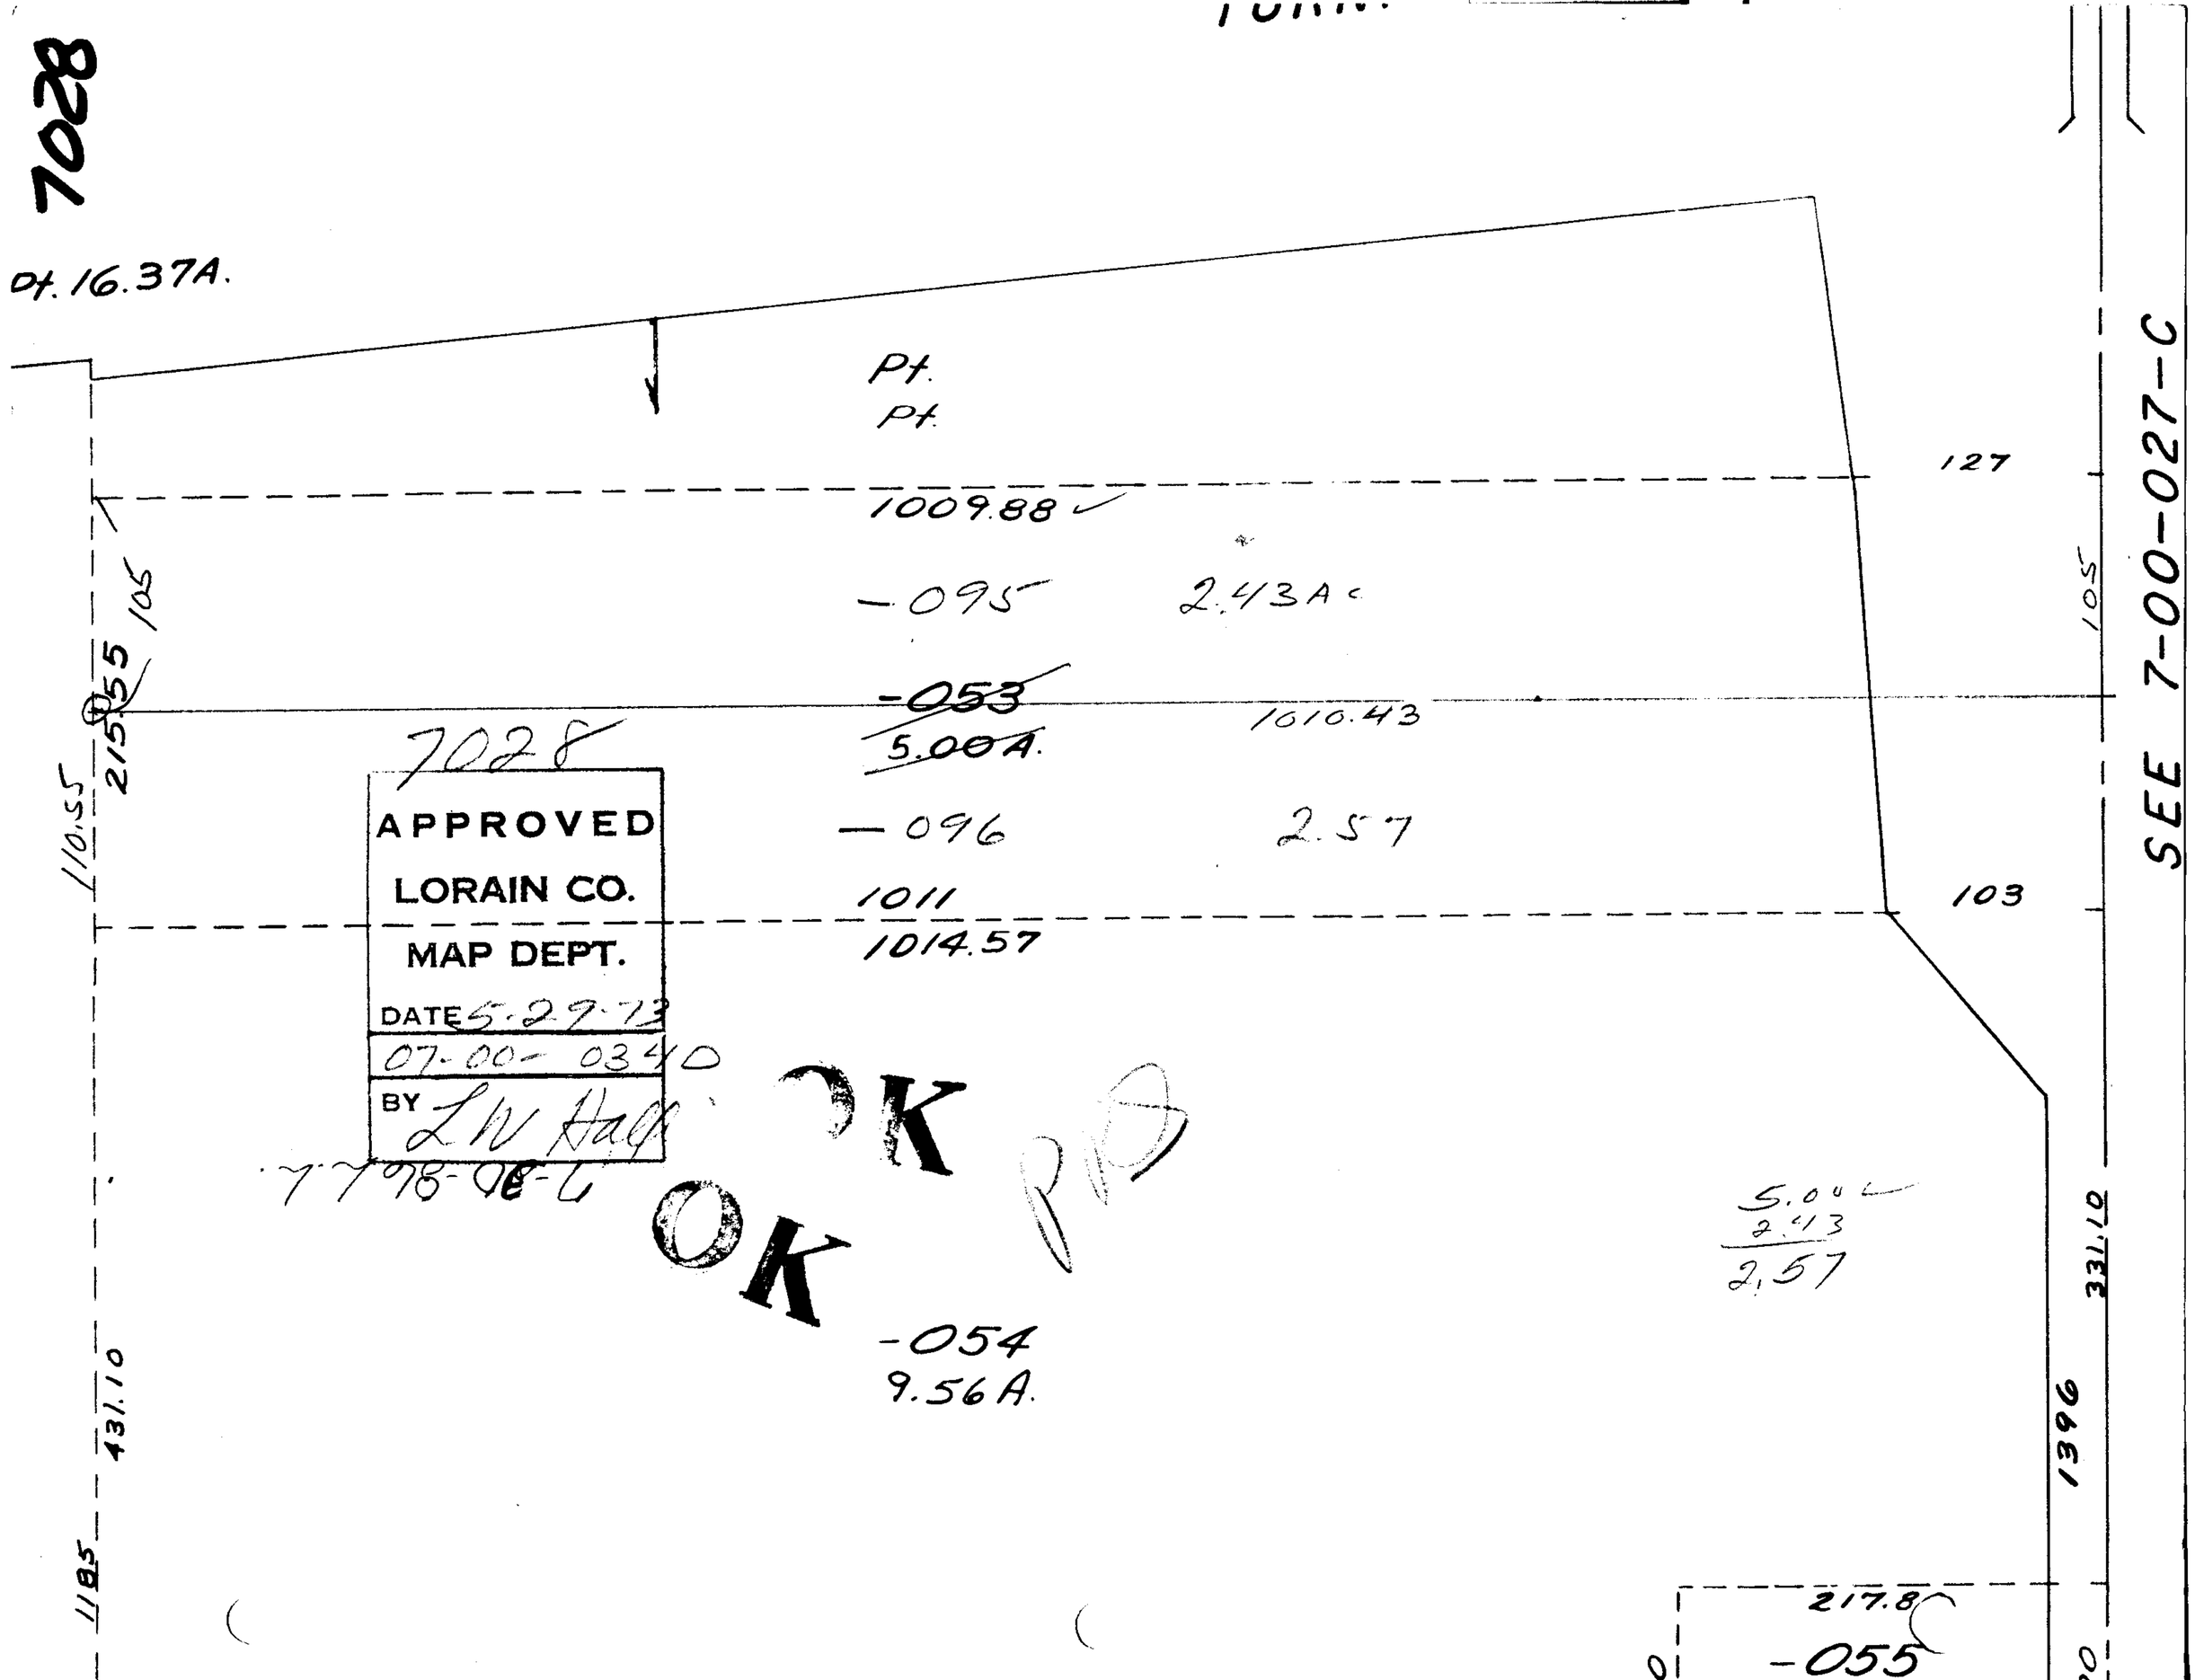
7028
Pt. 16.37A.
Pt.
Pt.
127
1009.88
105
-095
2.43A
105
215.55
-053
5.00A.
1010.43
7028
110.55
APPROVED
LORAIN CO.
MAP DEPT.
DATE 5-29-73
07-00-0340
BY LW Hall
-096
2.57
1011
1014.57
103
SEE 7-00-027-C
OK
OK
5.00
2.43
2.57
331.10
-054
9.56A.
431.10
1396
1185
217.8
-055