


7029

SEE 3-00-077-2

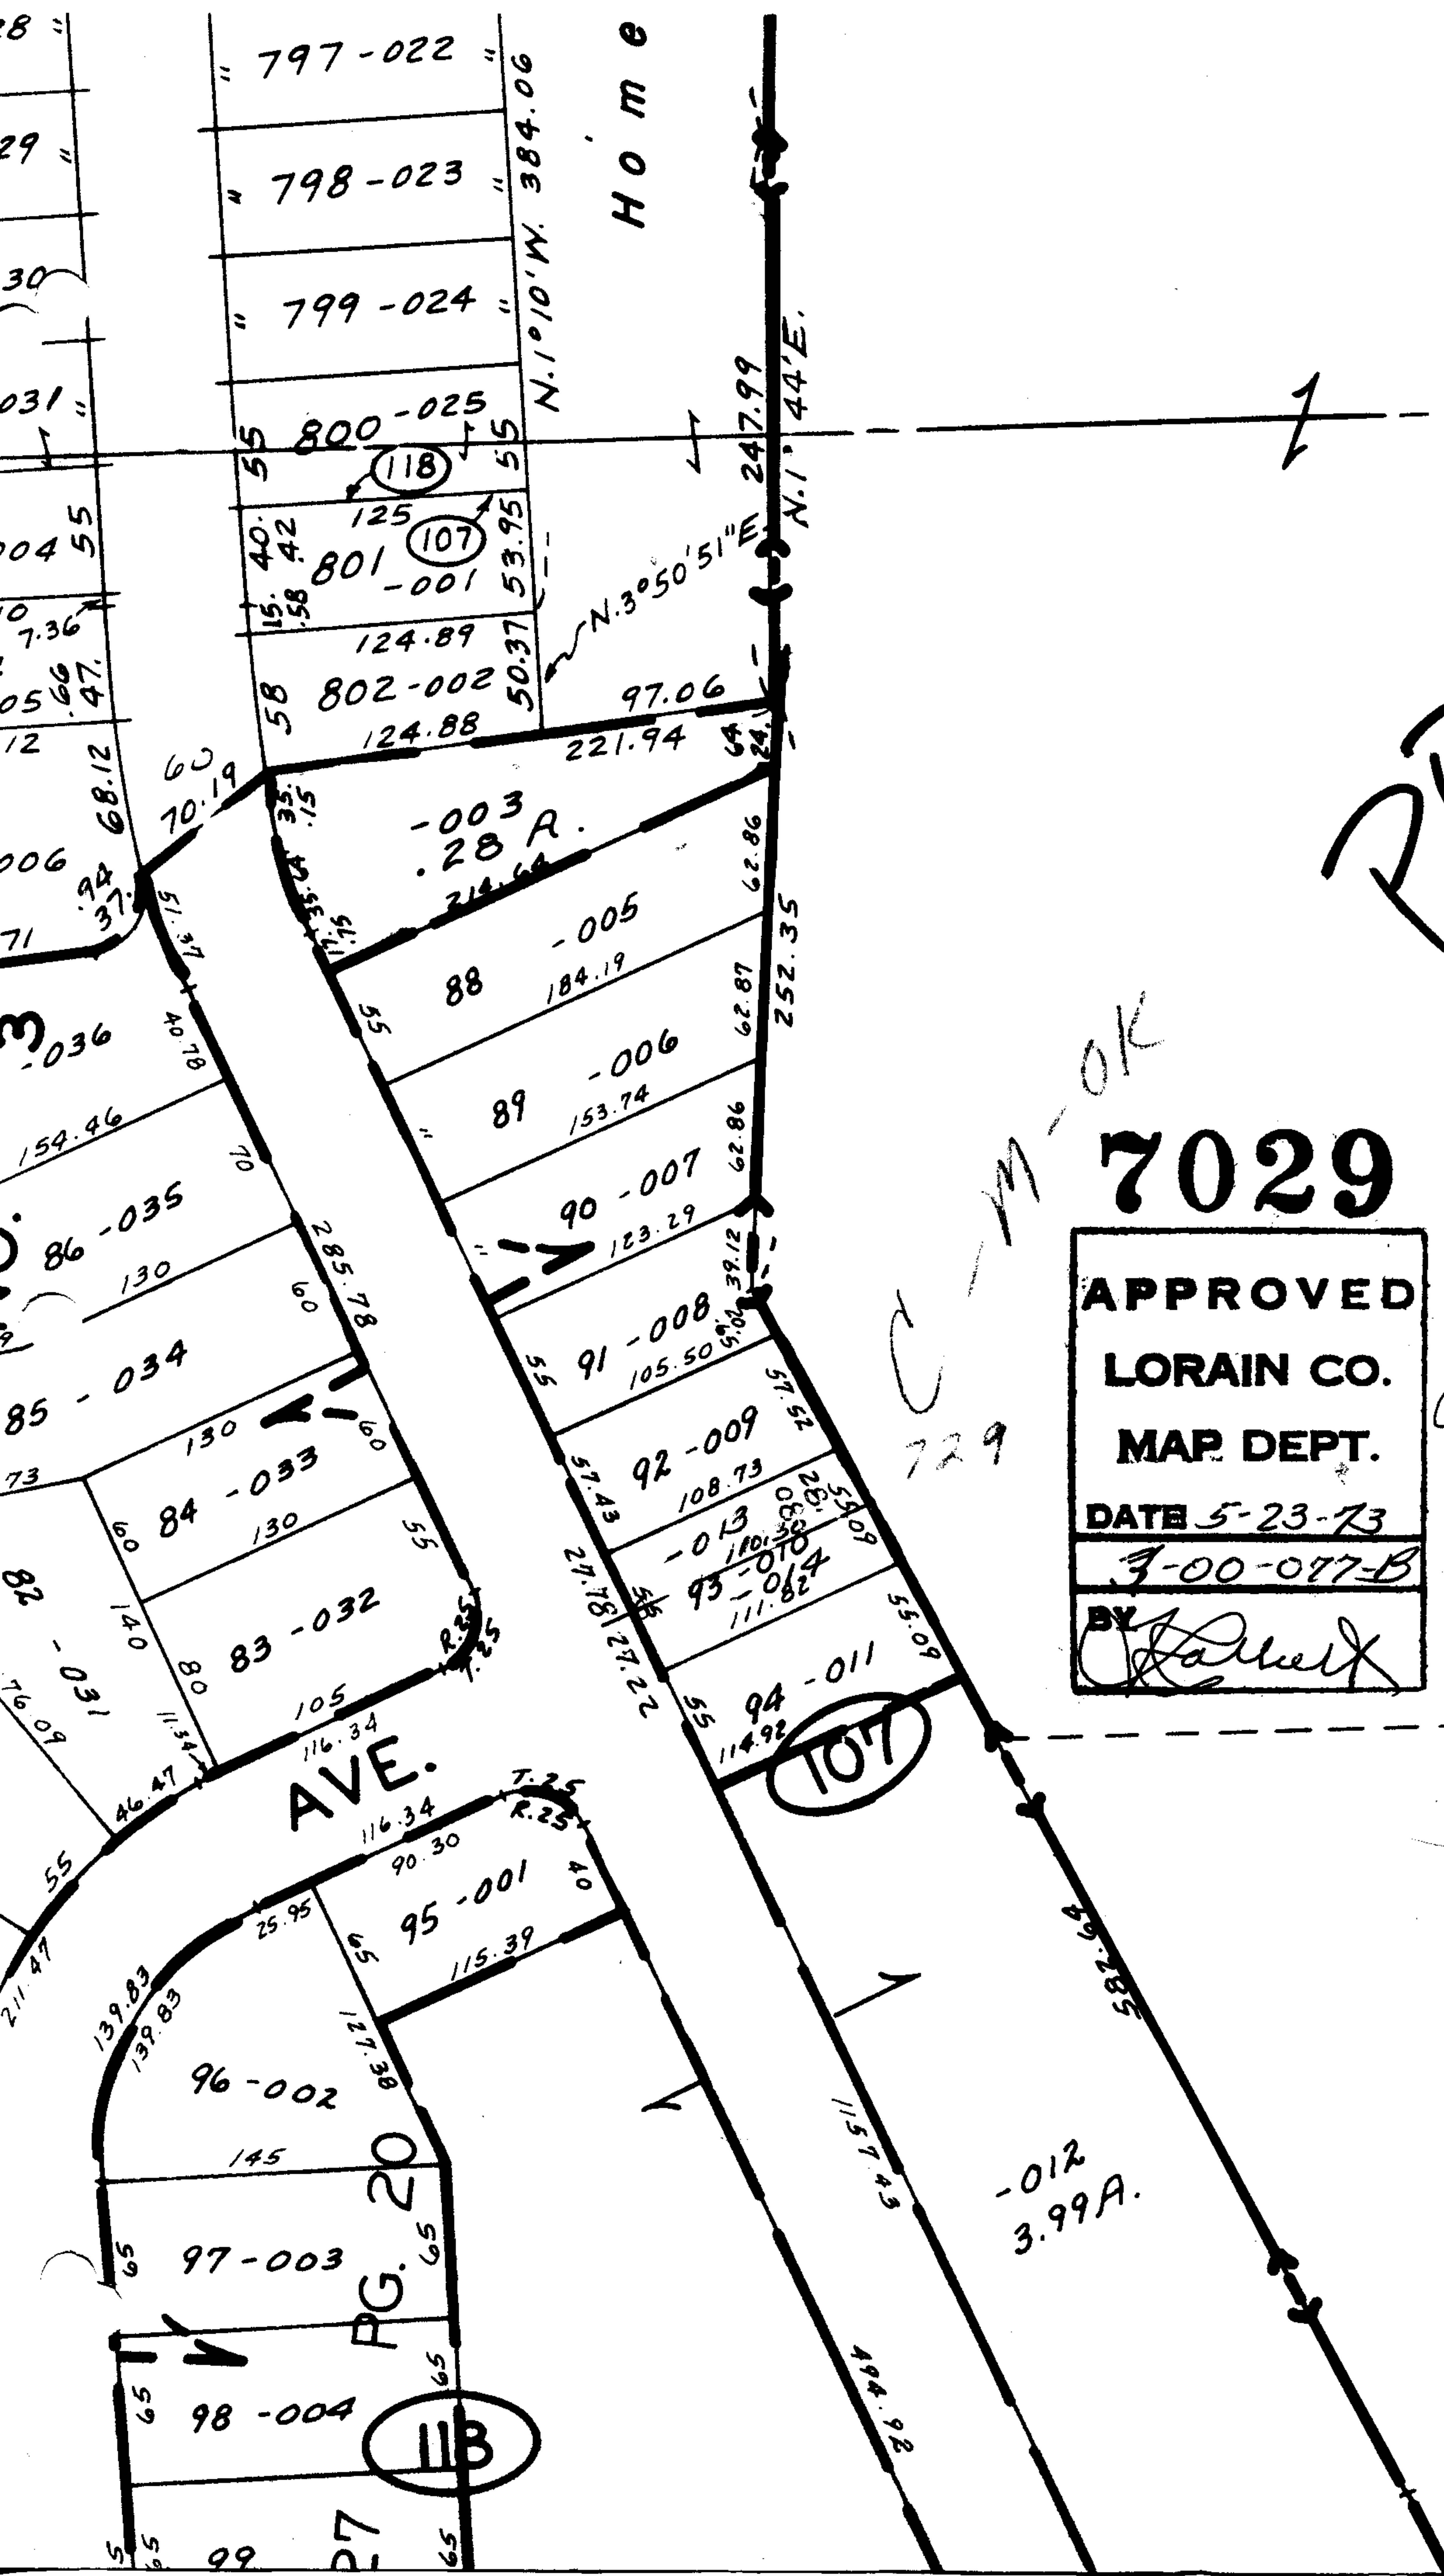

P.R.S.

C.M. - OK

7029

APPROVED

LORAIN CO.

MAP DEPT.

DATE 5-23-73

3-00-077-B

BY *[Signature]*

98-13-86

1201.30

Pt. -016
Pt. 15.60 A.

118

107

PG. 20