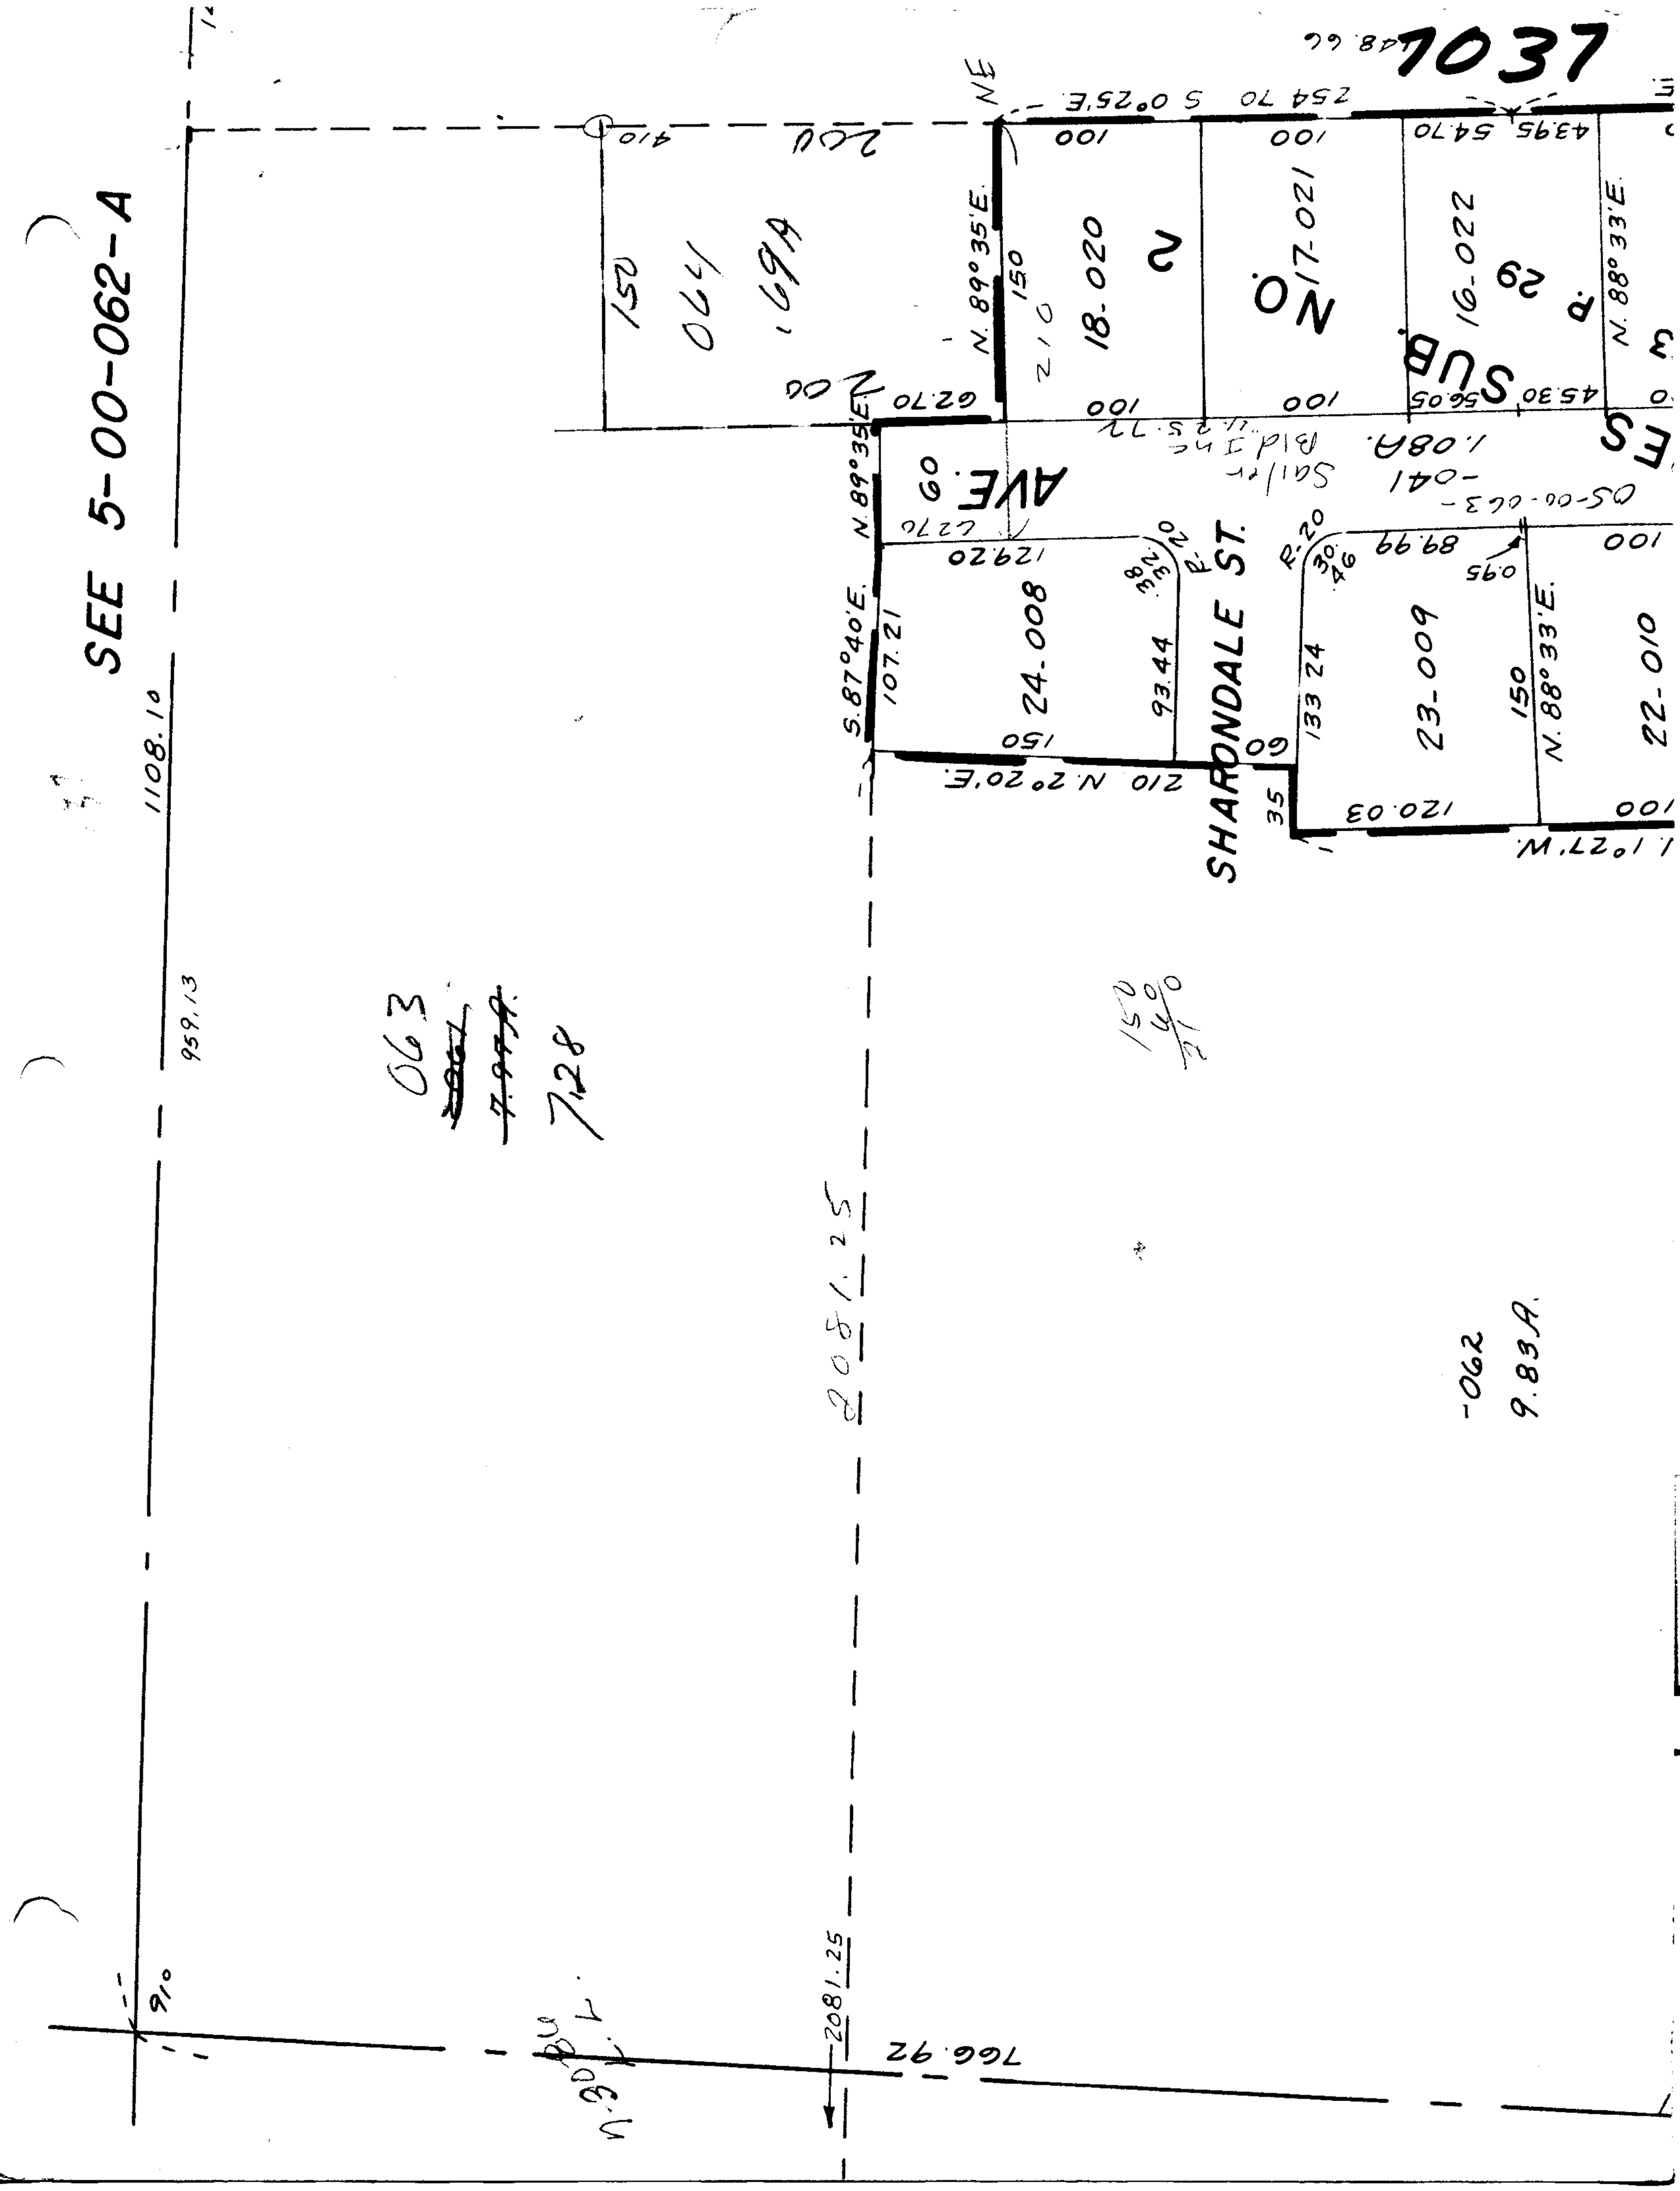

SEE 5-00-062-A
1108.10
959.13
7037
SUB. NO. 2
18.020
17.021
16.022
P. 29
AVE. 60
24.008
23.009
22.010
SHARONDALE ST.
N. 89°35'E.
N. 88°33'E.
S. 87°40'E.
N. 2°20'E.
S 0°25'E
2081.25
766.92
-062
9.83A.
063
7.28