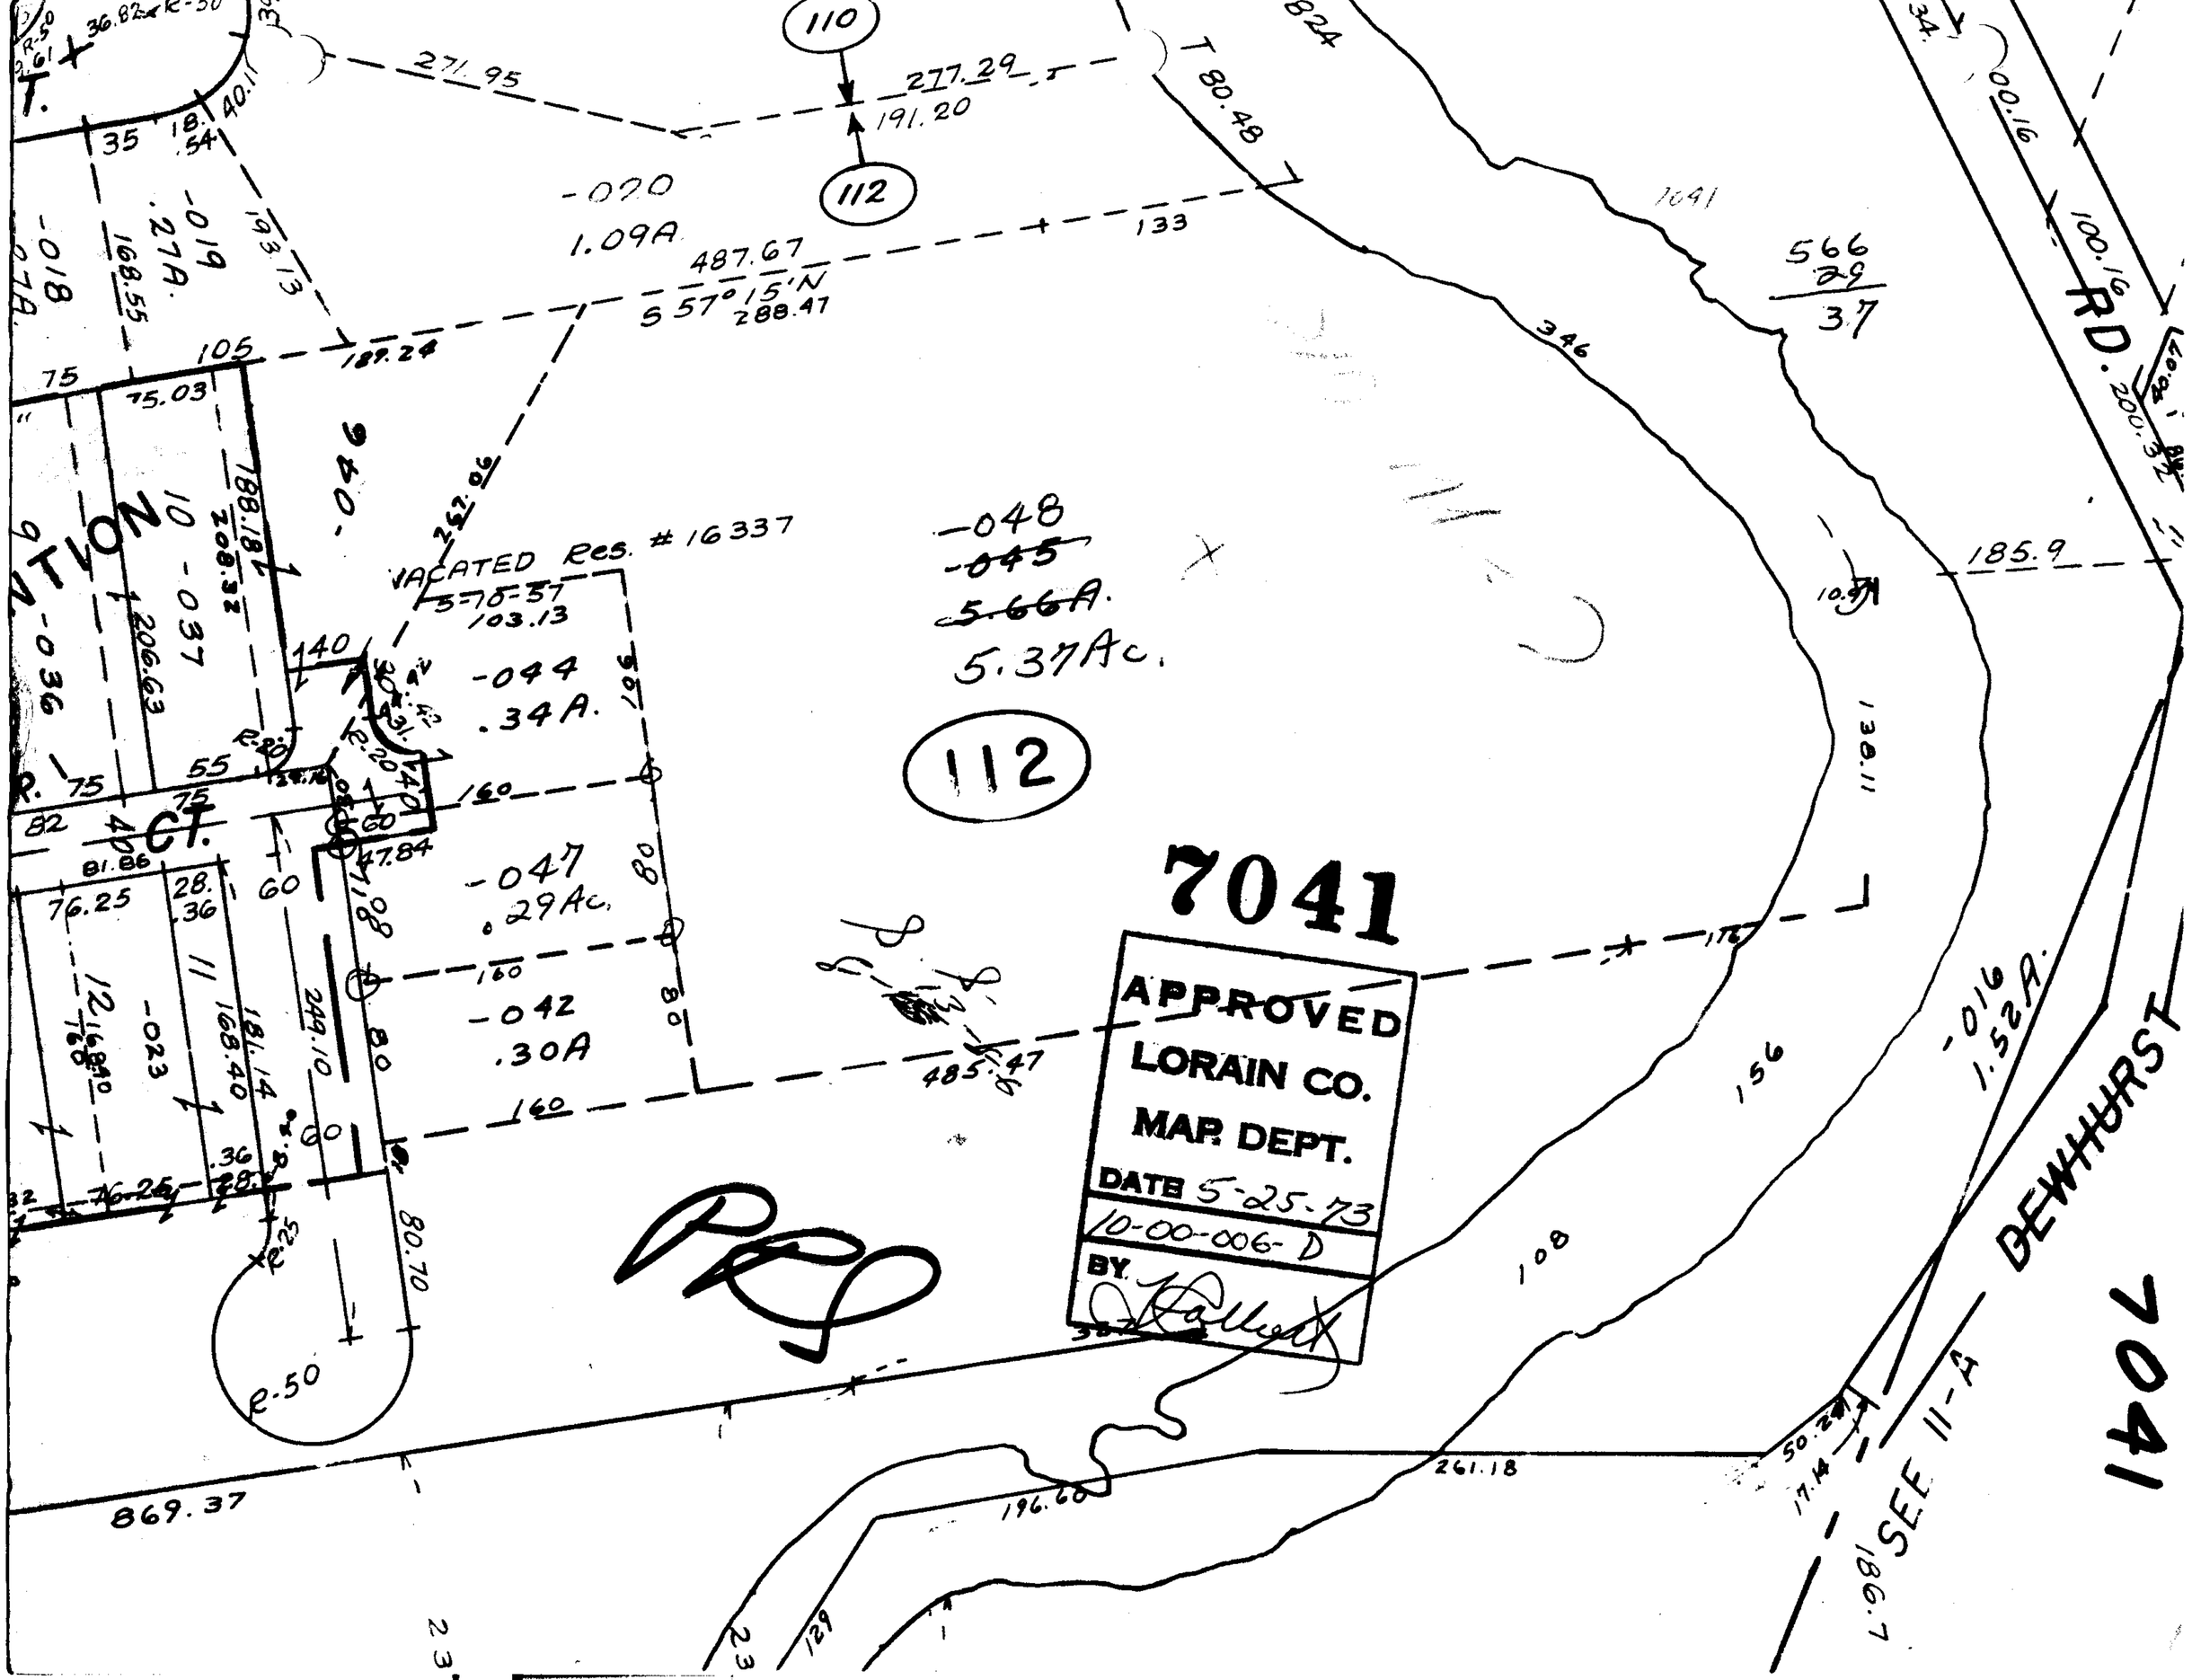

7041
APPROVED
LORAIN CO.
MAP DEPT.
DATE 5-25-73
10-00-006-D
BY
112
-020
1.09A
487.67
S 57° 15' N
288.47
-048
~~-045~~
~~5.66A.~~
5.37Ac.
VACATED Res. # 16337
5-10-57
103.13
-044
.34A.
-047
.29Ac.
-042
.30A
-016
1.52A.
566
29
37
RD.
DEWHURST
SEE 11-A
CT.
869.37
261.18
196.60
185.9
138.11