7053

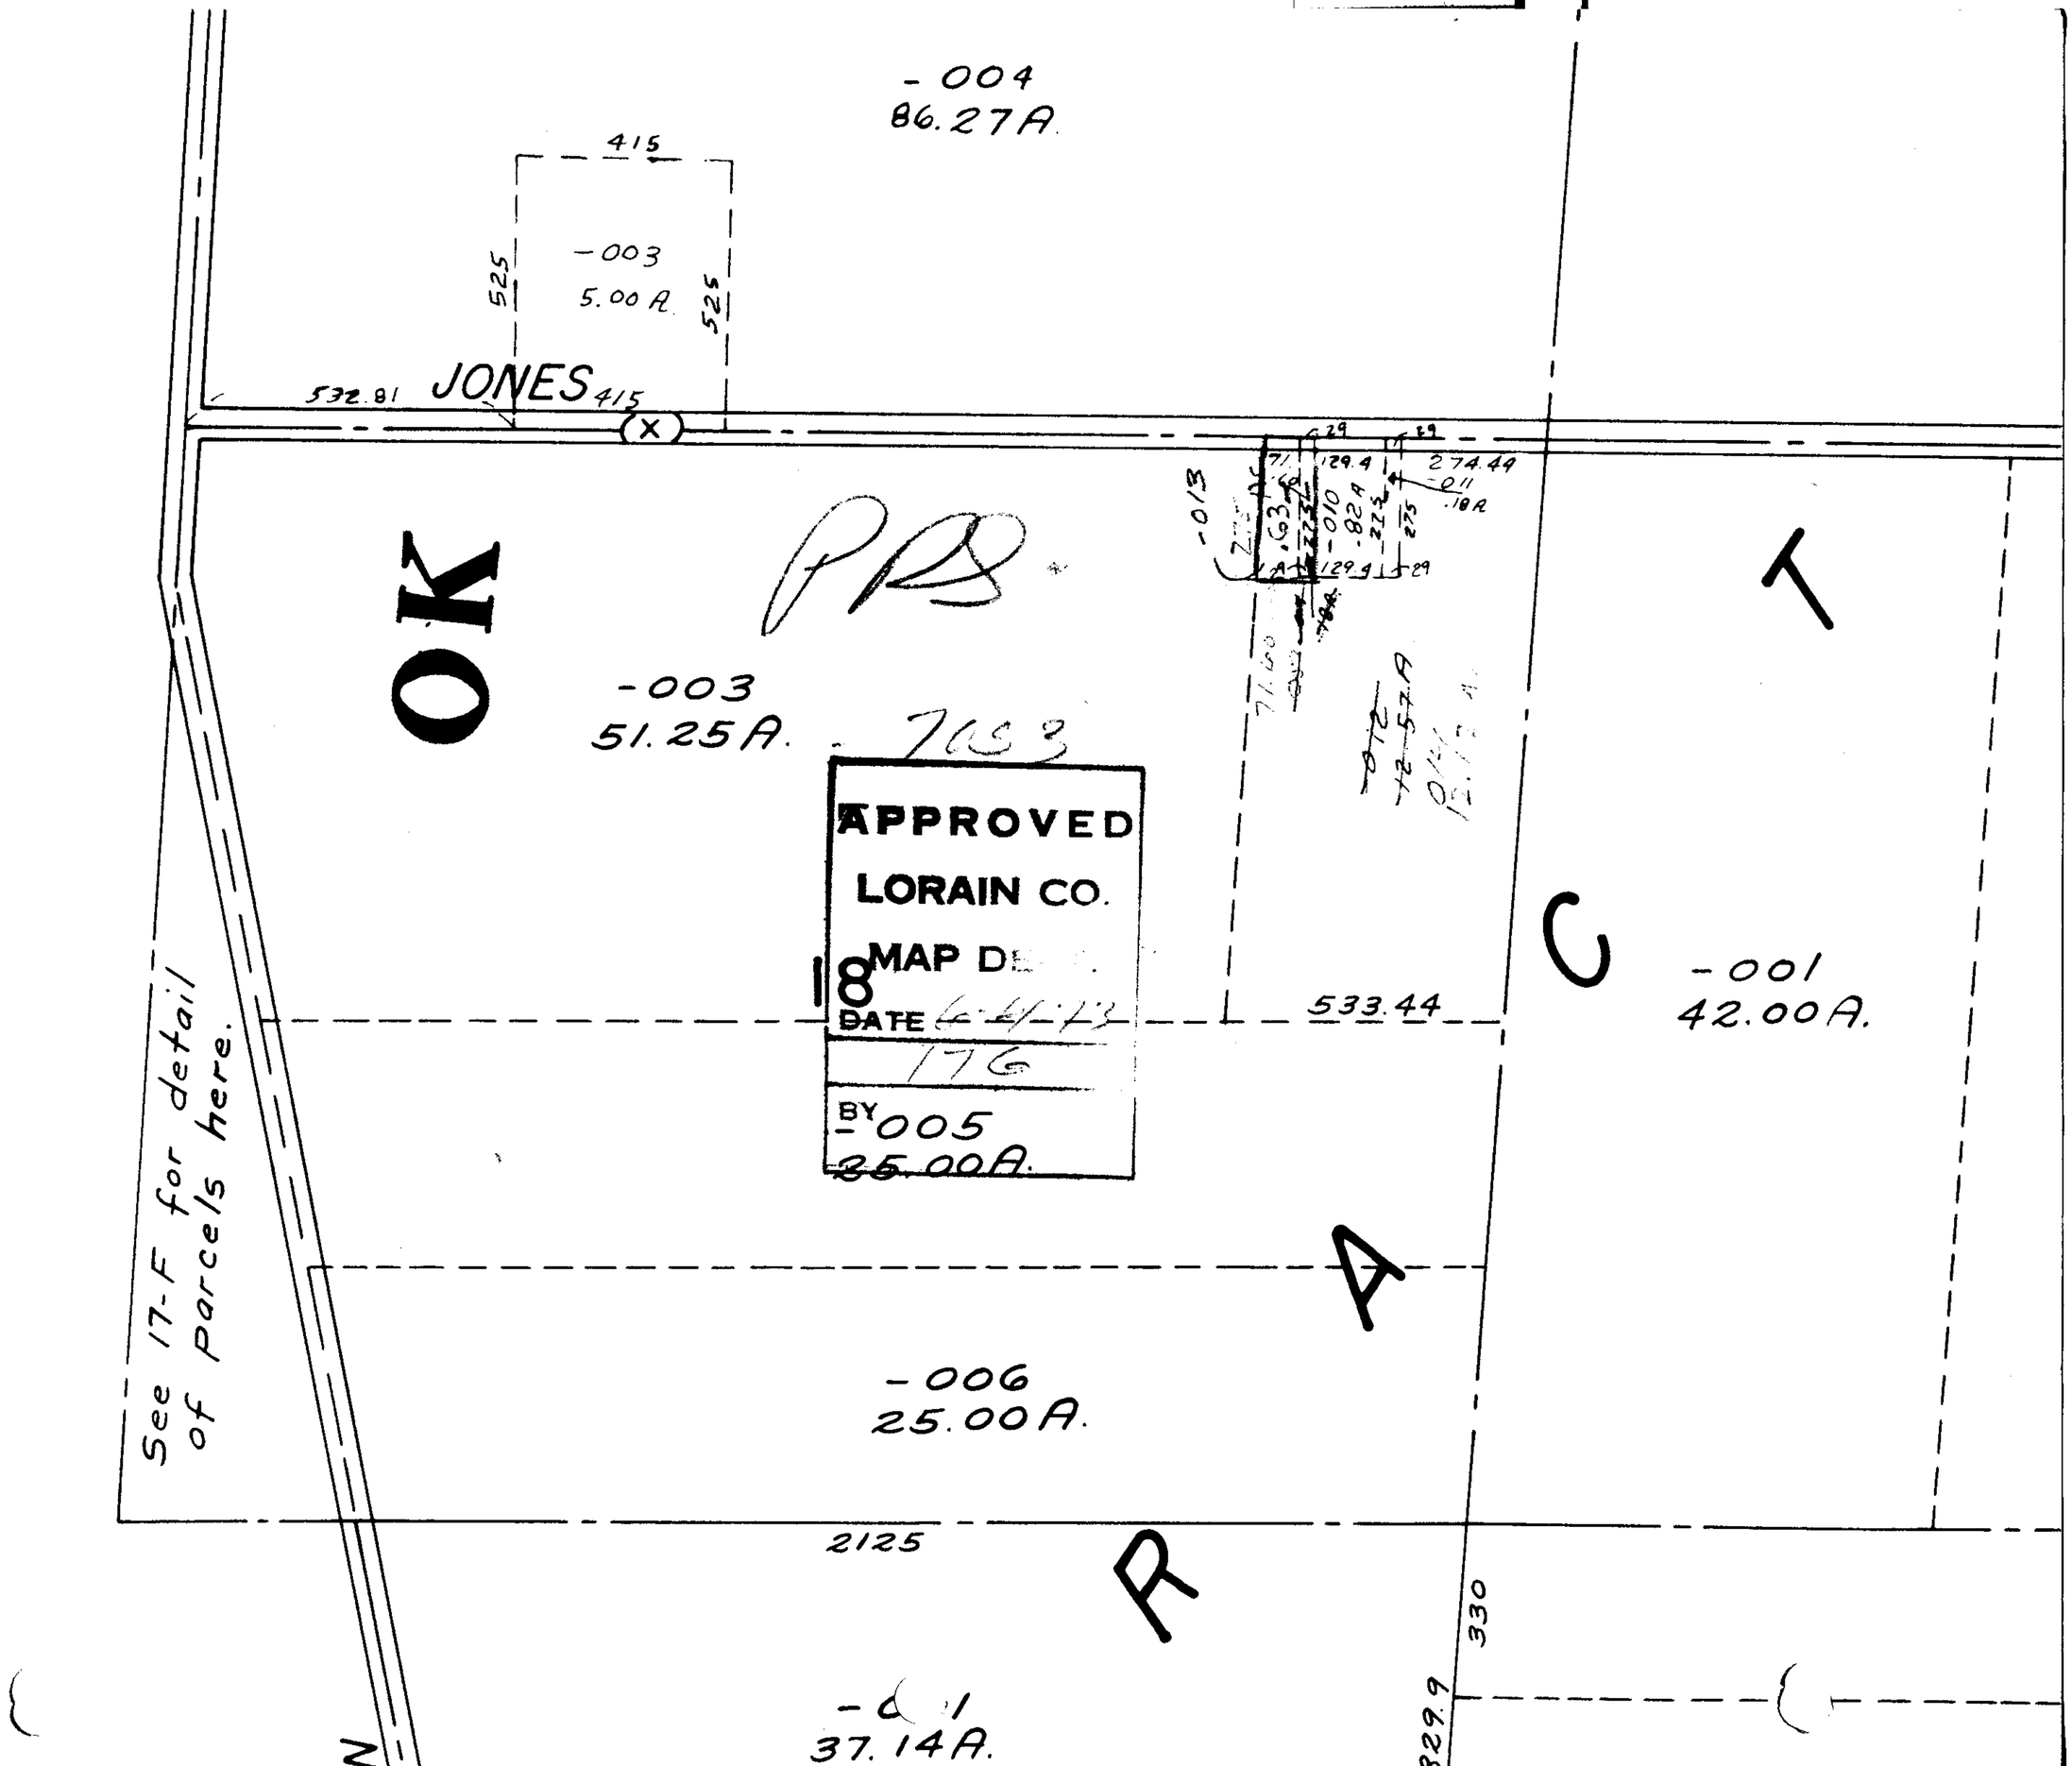

-004
86.27A.
415
-003
5.00 A.
525
525
532.81
JONES
415
OK
-003
51.25A.
7053
APPROVED
LORAIN CO.
MAP DE
DATE
BY
-005
25.00A.
18
533.44
-001
42.00A.
See 17-F for detail of parcels here.
-006
25.00A.
2125
330
329.9
-001
37.14A.