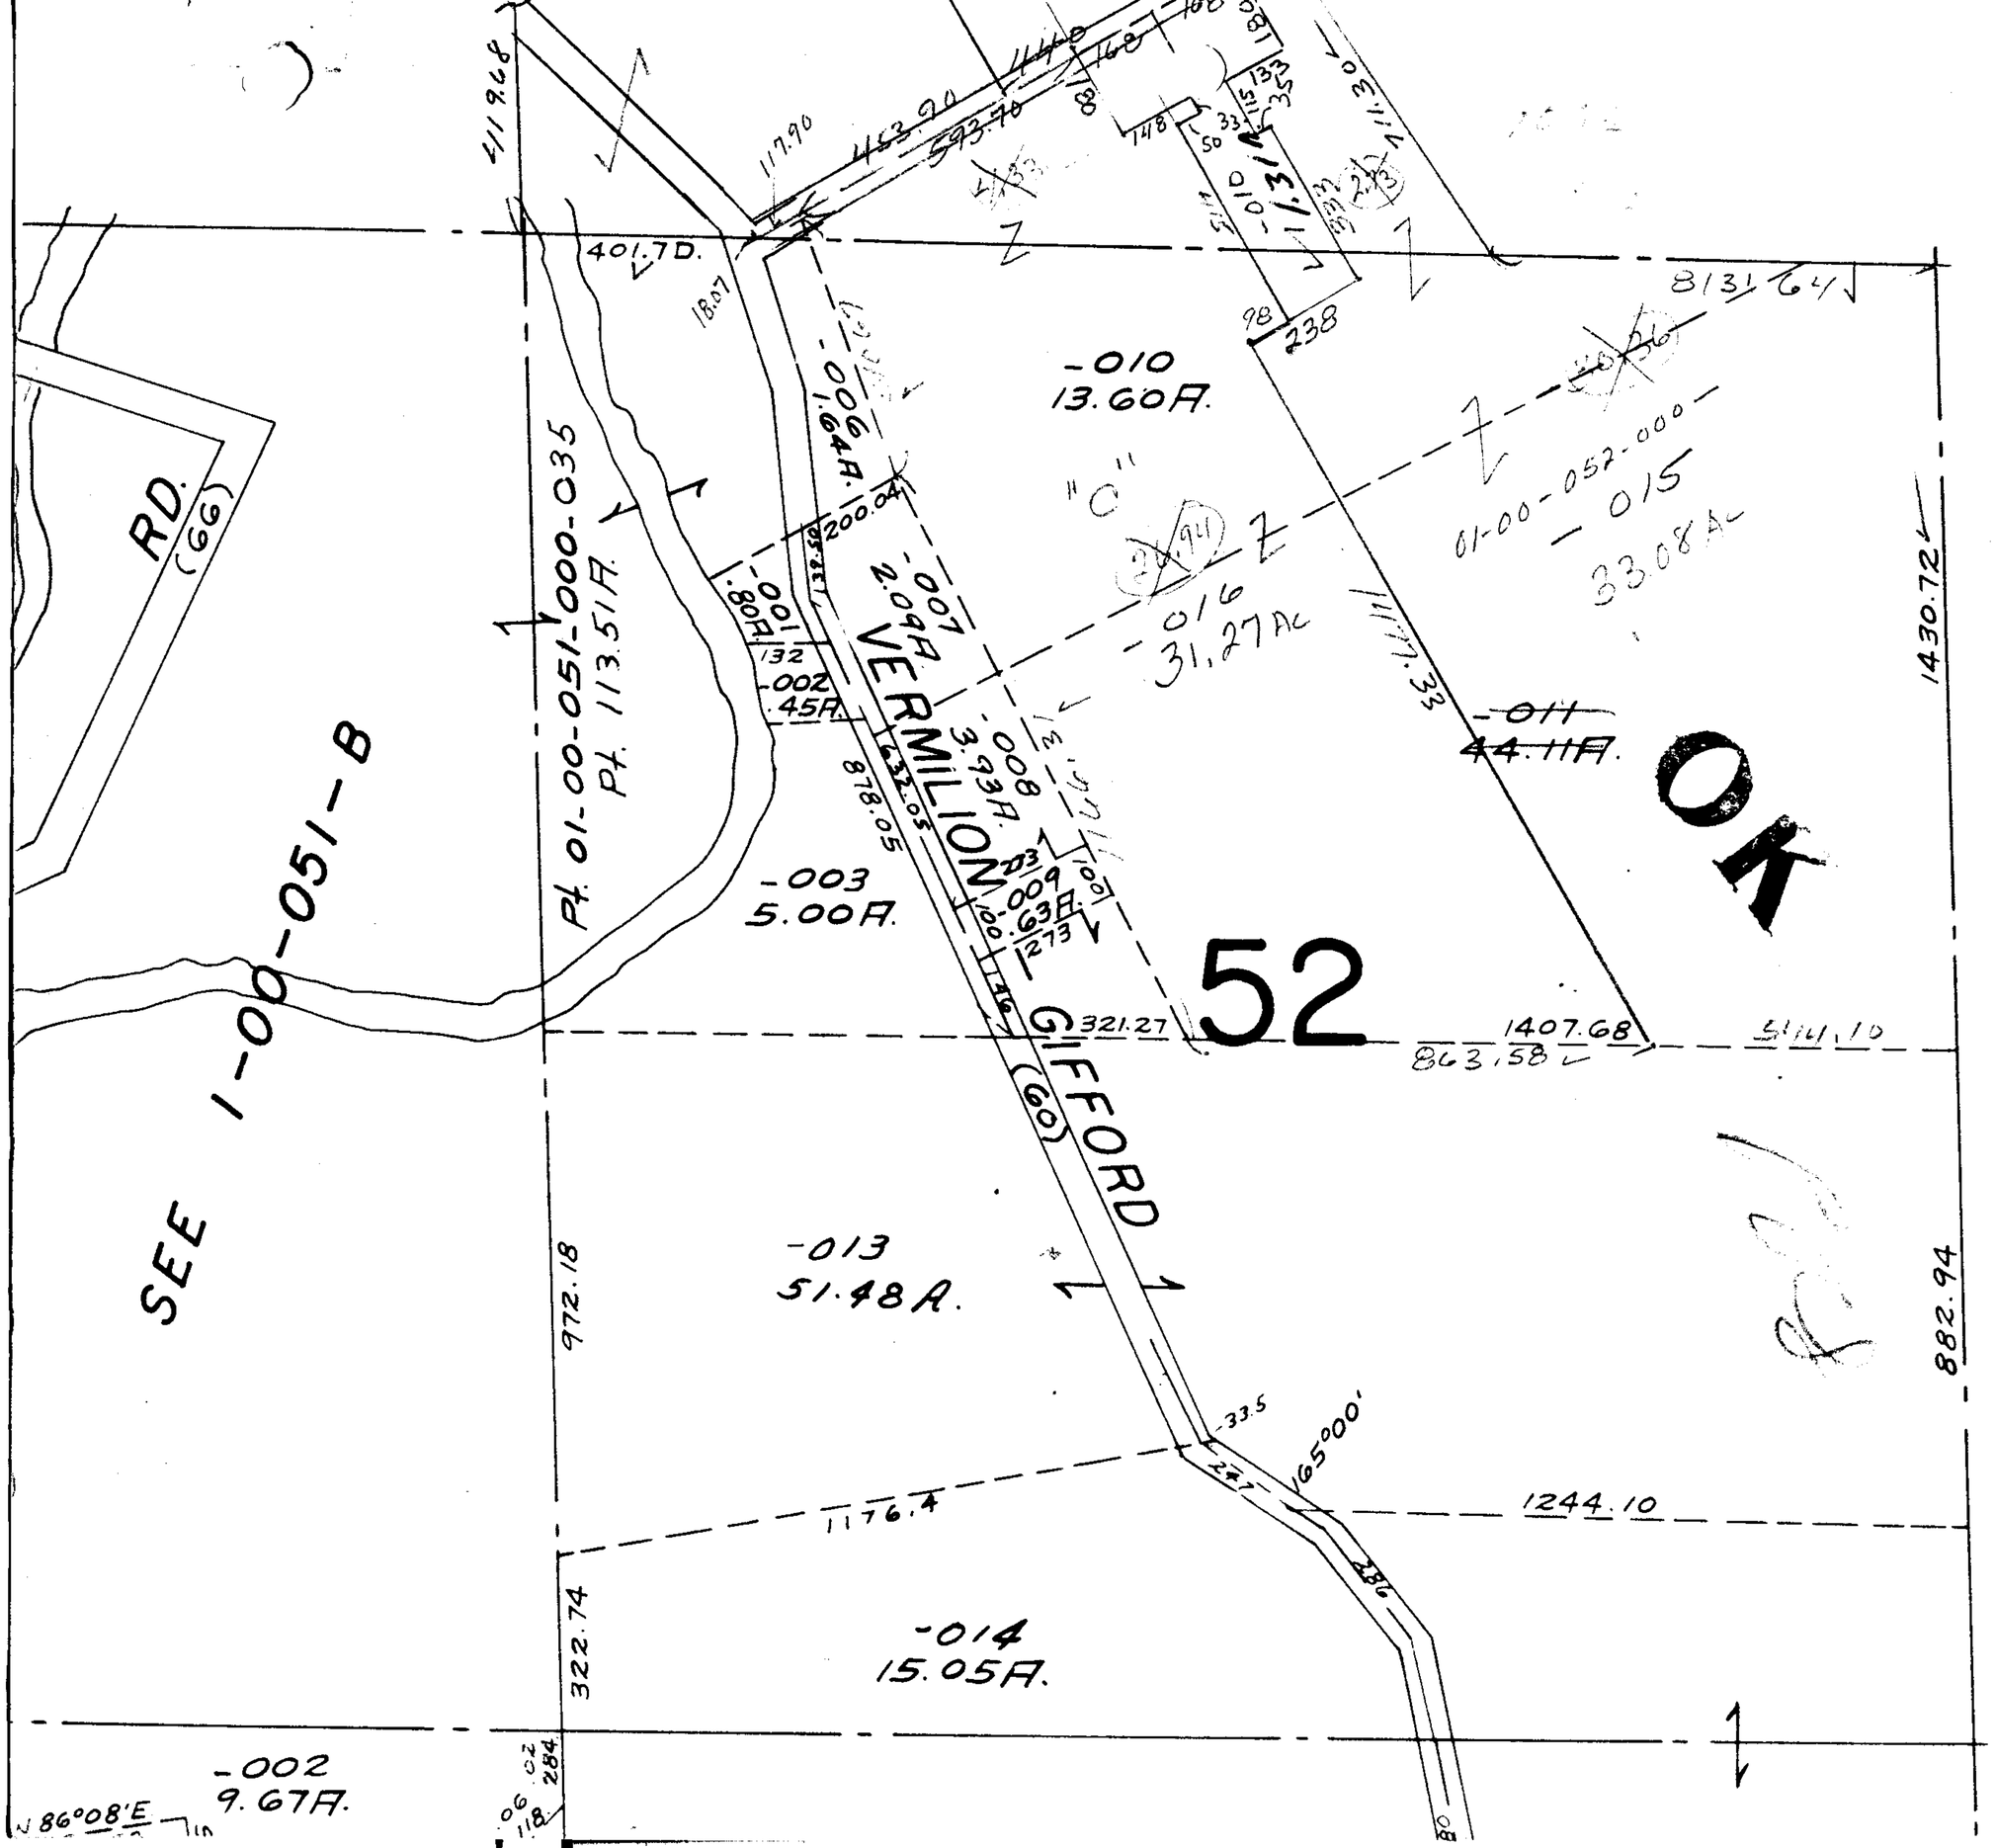

APPROVED
LORAIN CO.
MAP DEPT.
6-5-73

See SURVEY

7056
2/2