7059
OK
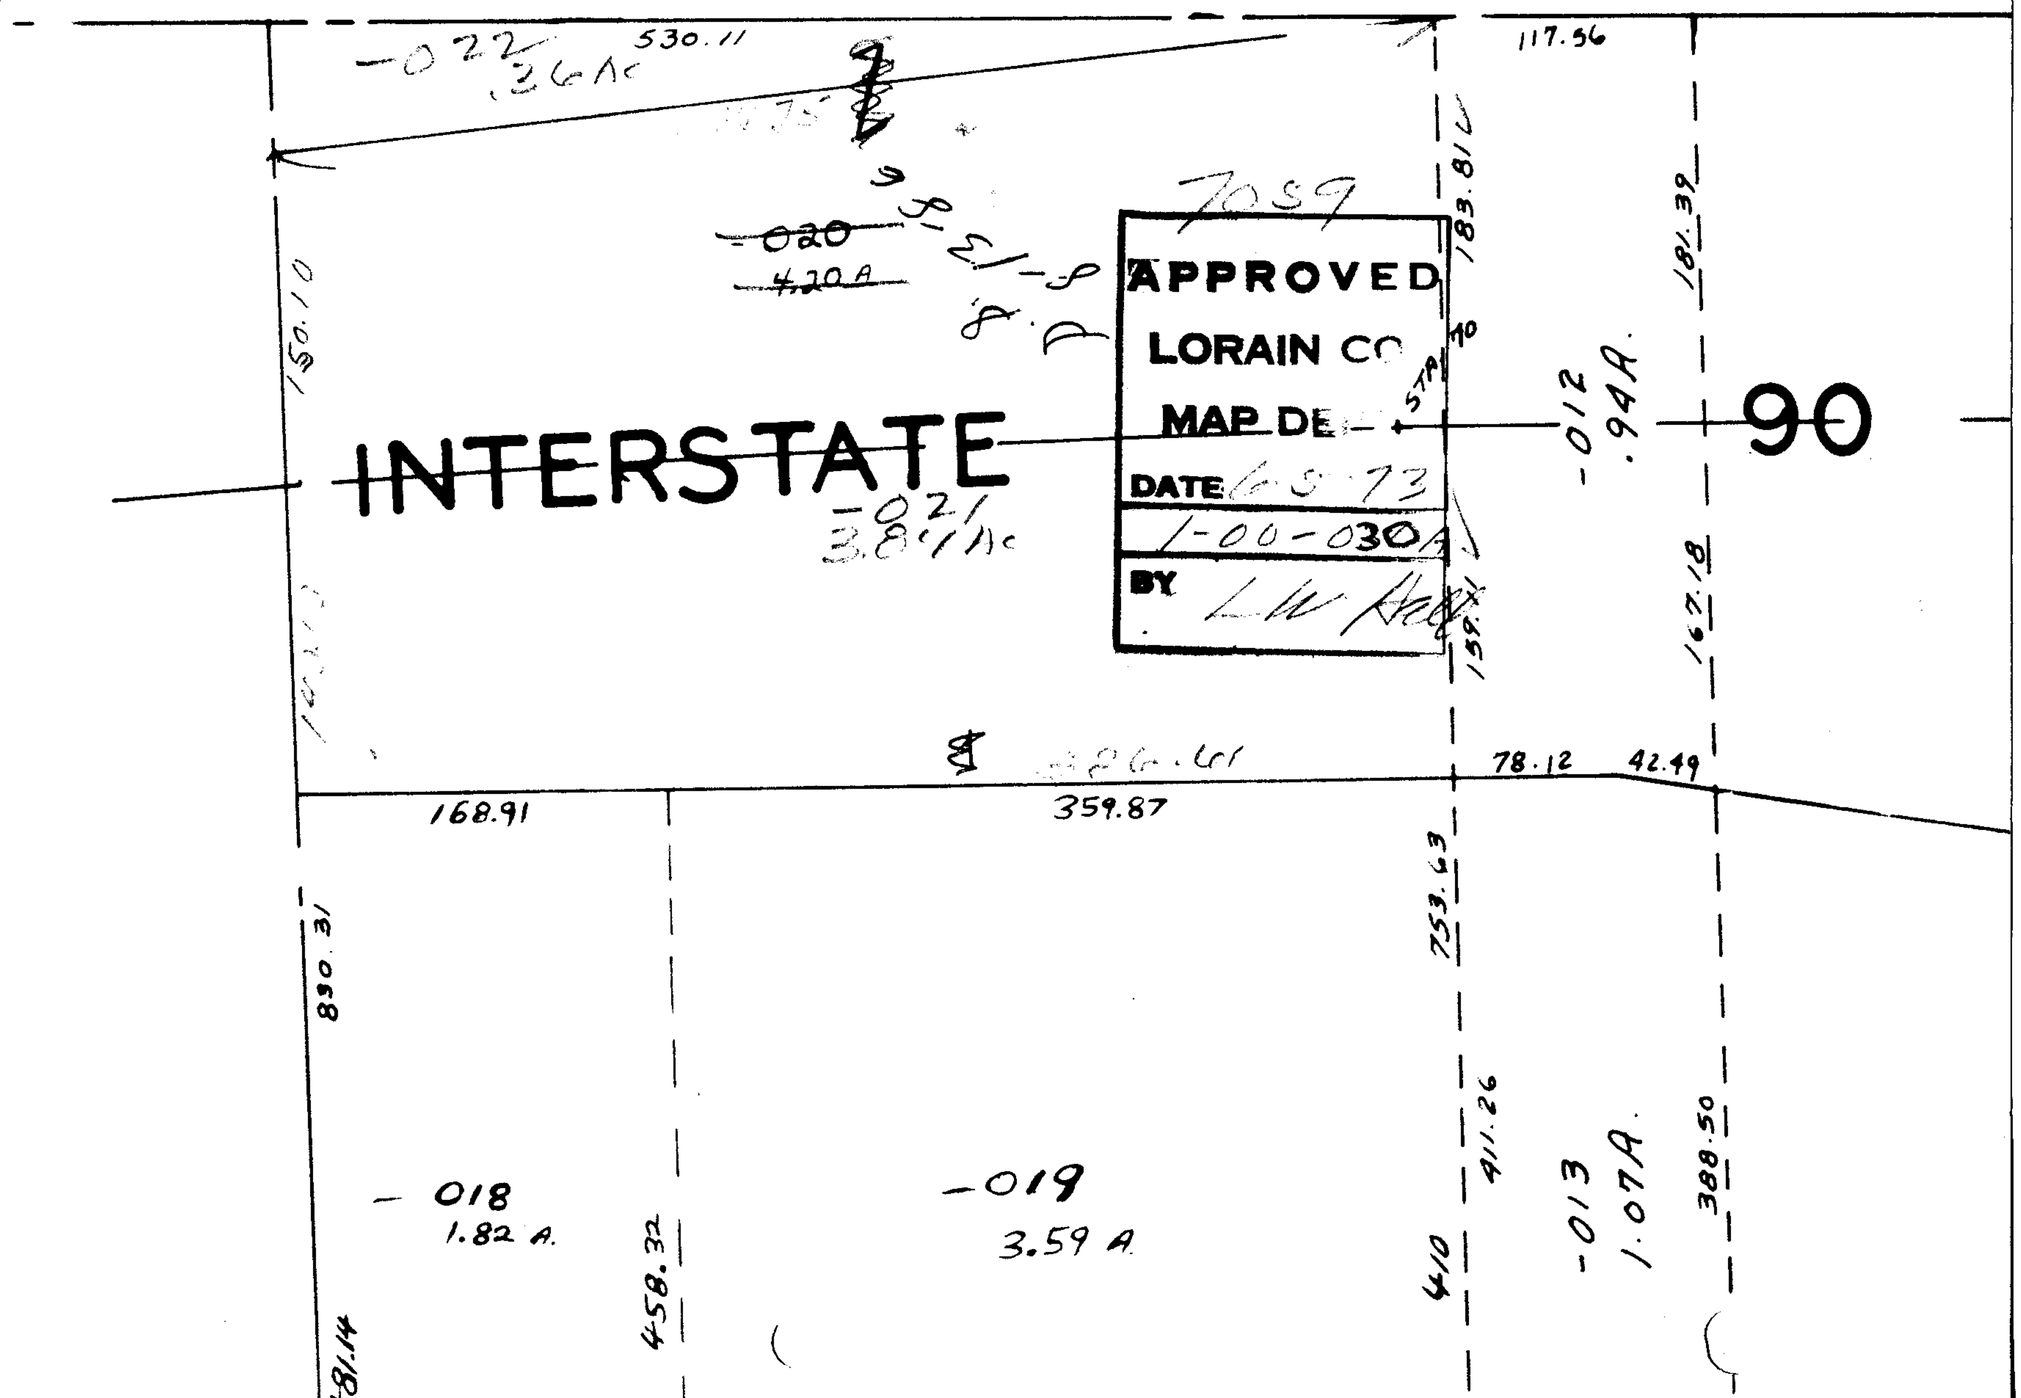
SEE 1-00-019-A