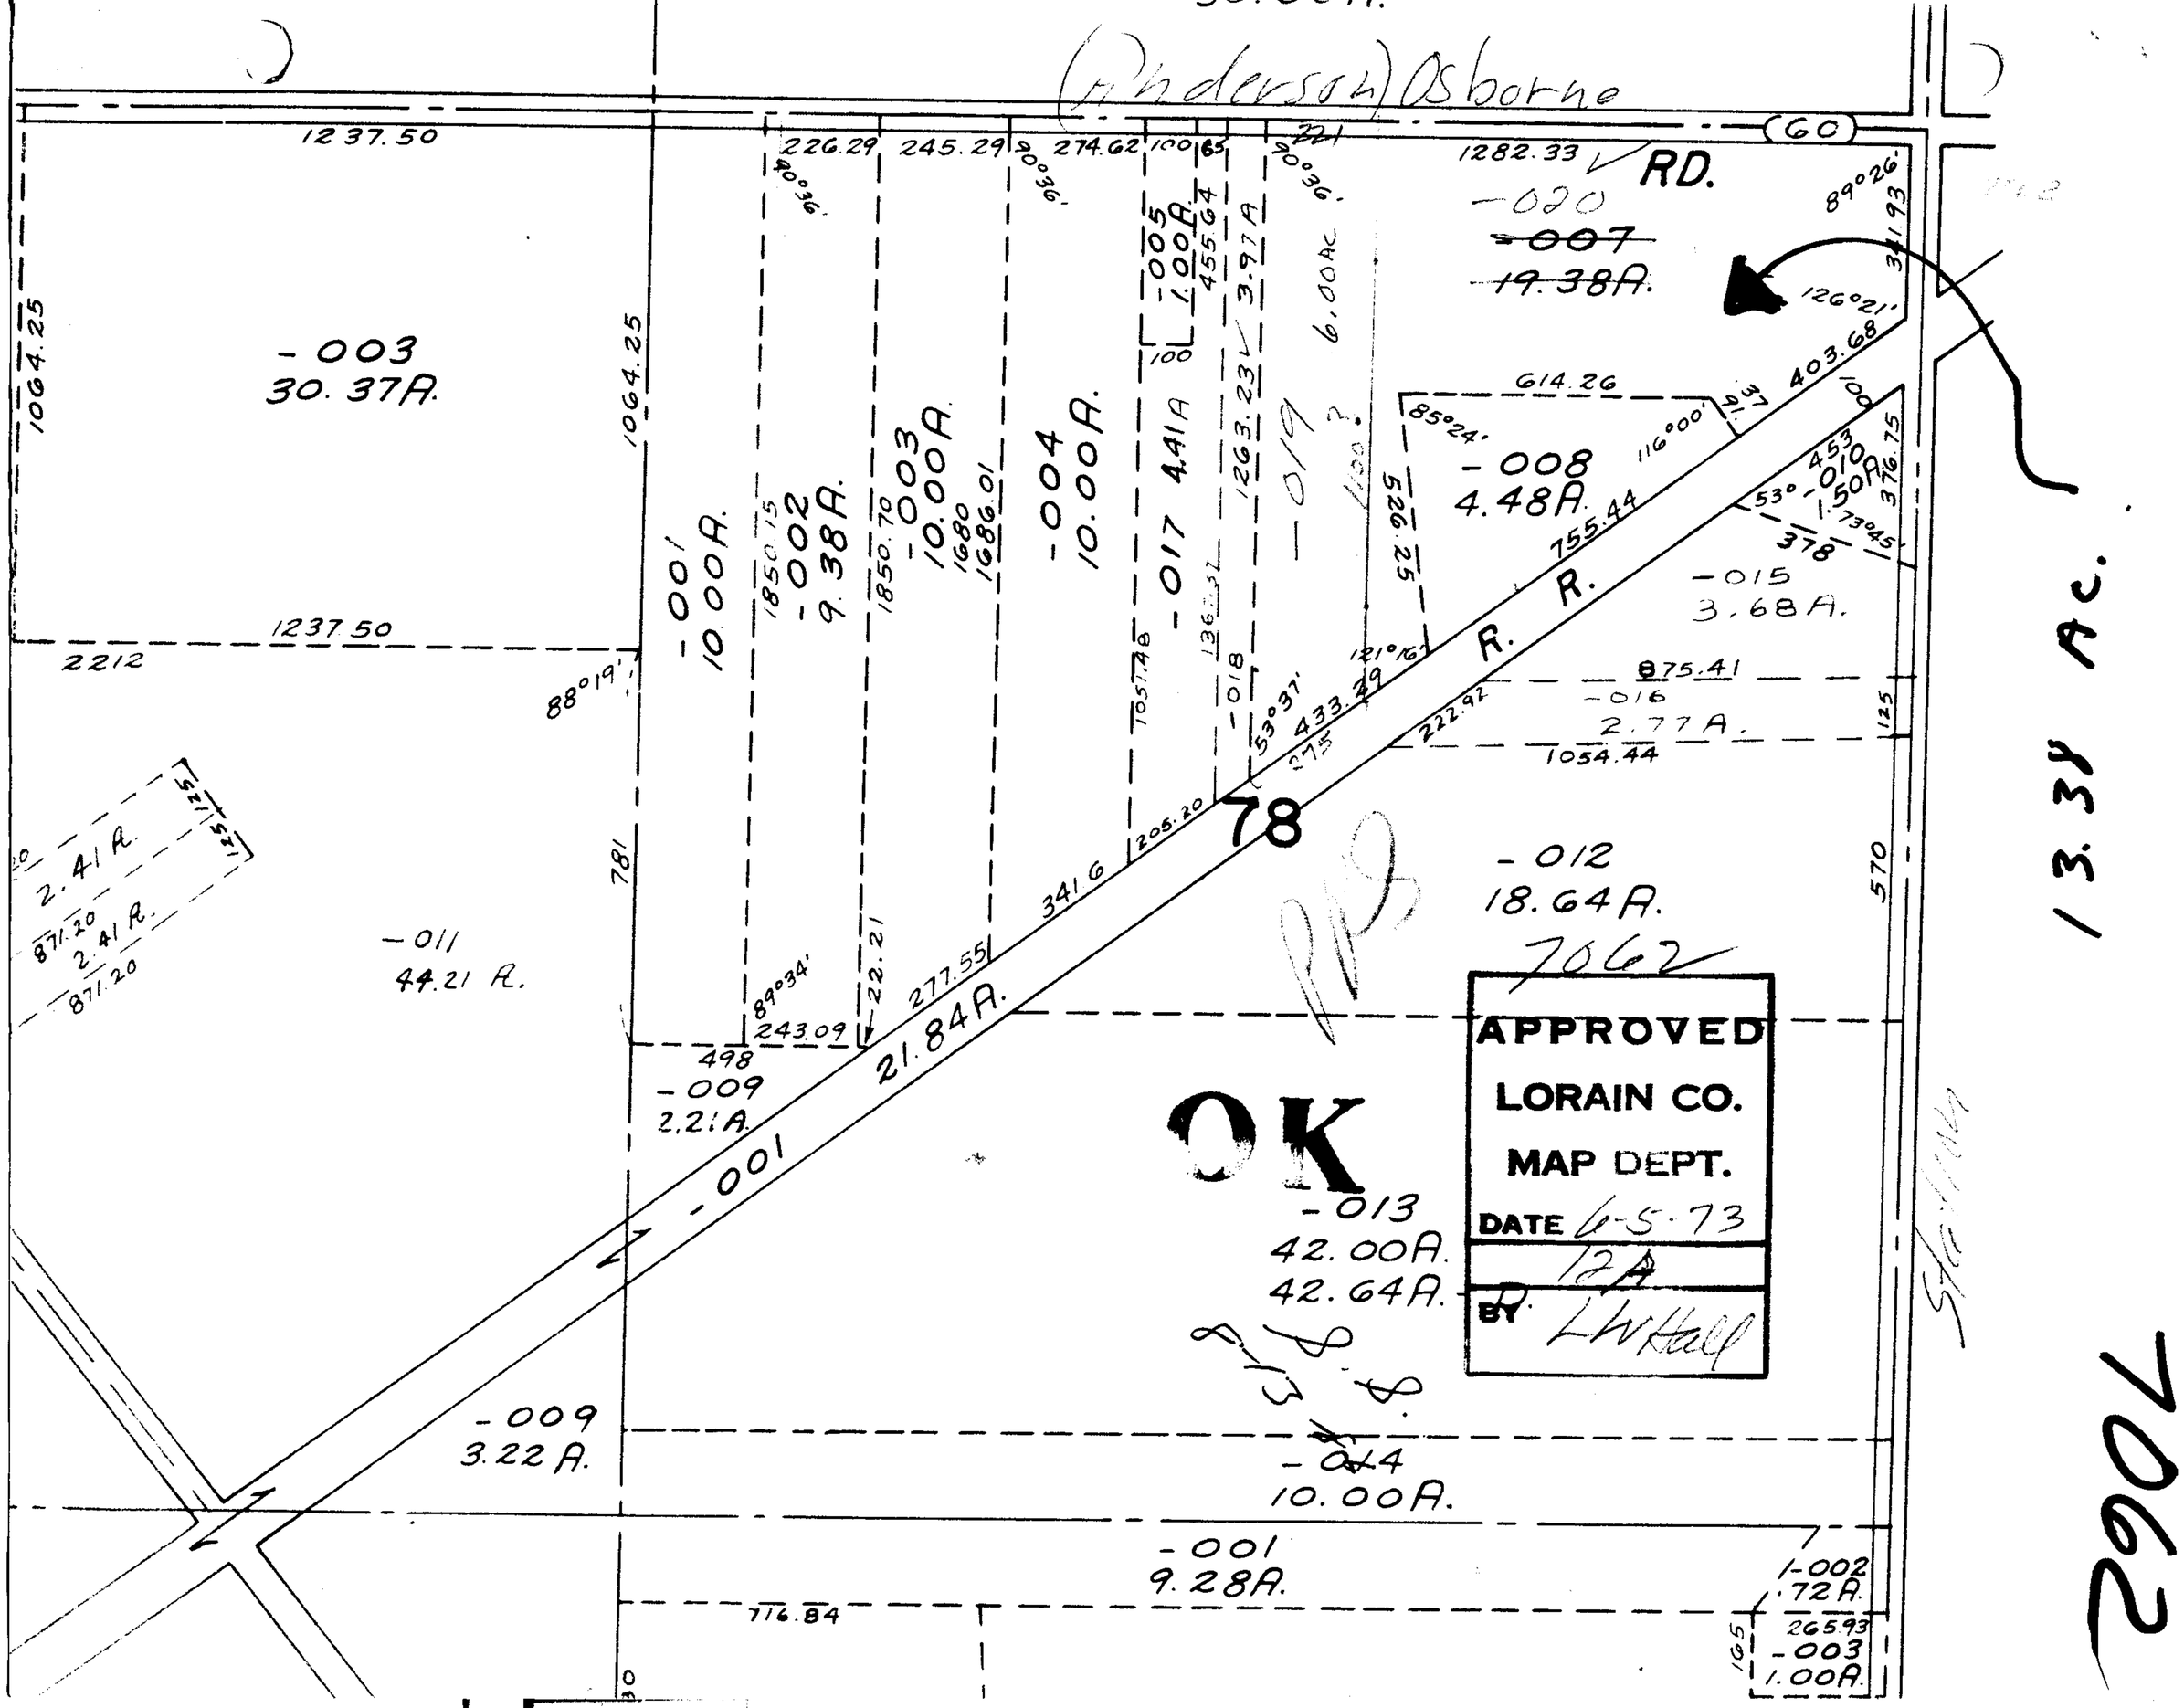
(Anderson) Osborne
60
RD.
1237.50
226.29
245.29
274.62
1282.33
-020
~~-007~~
~~19.38A.~~
89°26'
341.93
126°21'
403.68
-003
30.37A.
1064.25
-001
10.00A.
-002
9.38A.
-003
10.00A.
-004
10.00A.
-005
1.00A.
-017 4.41A
-019
6.00AC
-008
4.48A.
614.26
85°24'
116°00'
755.44
-010
1.50A.
-015
3.68A.
R. R.
875.41
-016
2.77A.
1054.44
1237.50
2212
88°19'
-012
18.64A.
78
-011
44.21 A.
2.41 A.
871.20
-009
2.21A.
-001
21.84A.
277.55
341.6
-013
42.00A.
42.64A.
-009
3.22 A.
-014
10.00A.
-001
9.28A.
-002
.72A.
-003
1.00A.
716.84
265.93
13.38 Ac.
7062
APPROVED
LORAIN CO.
MAP DEPT.
DATE 6-5-73
12A
BY LWHall
OK