


7064

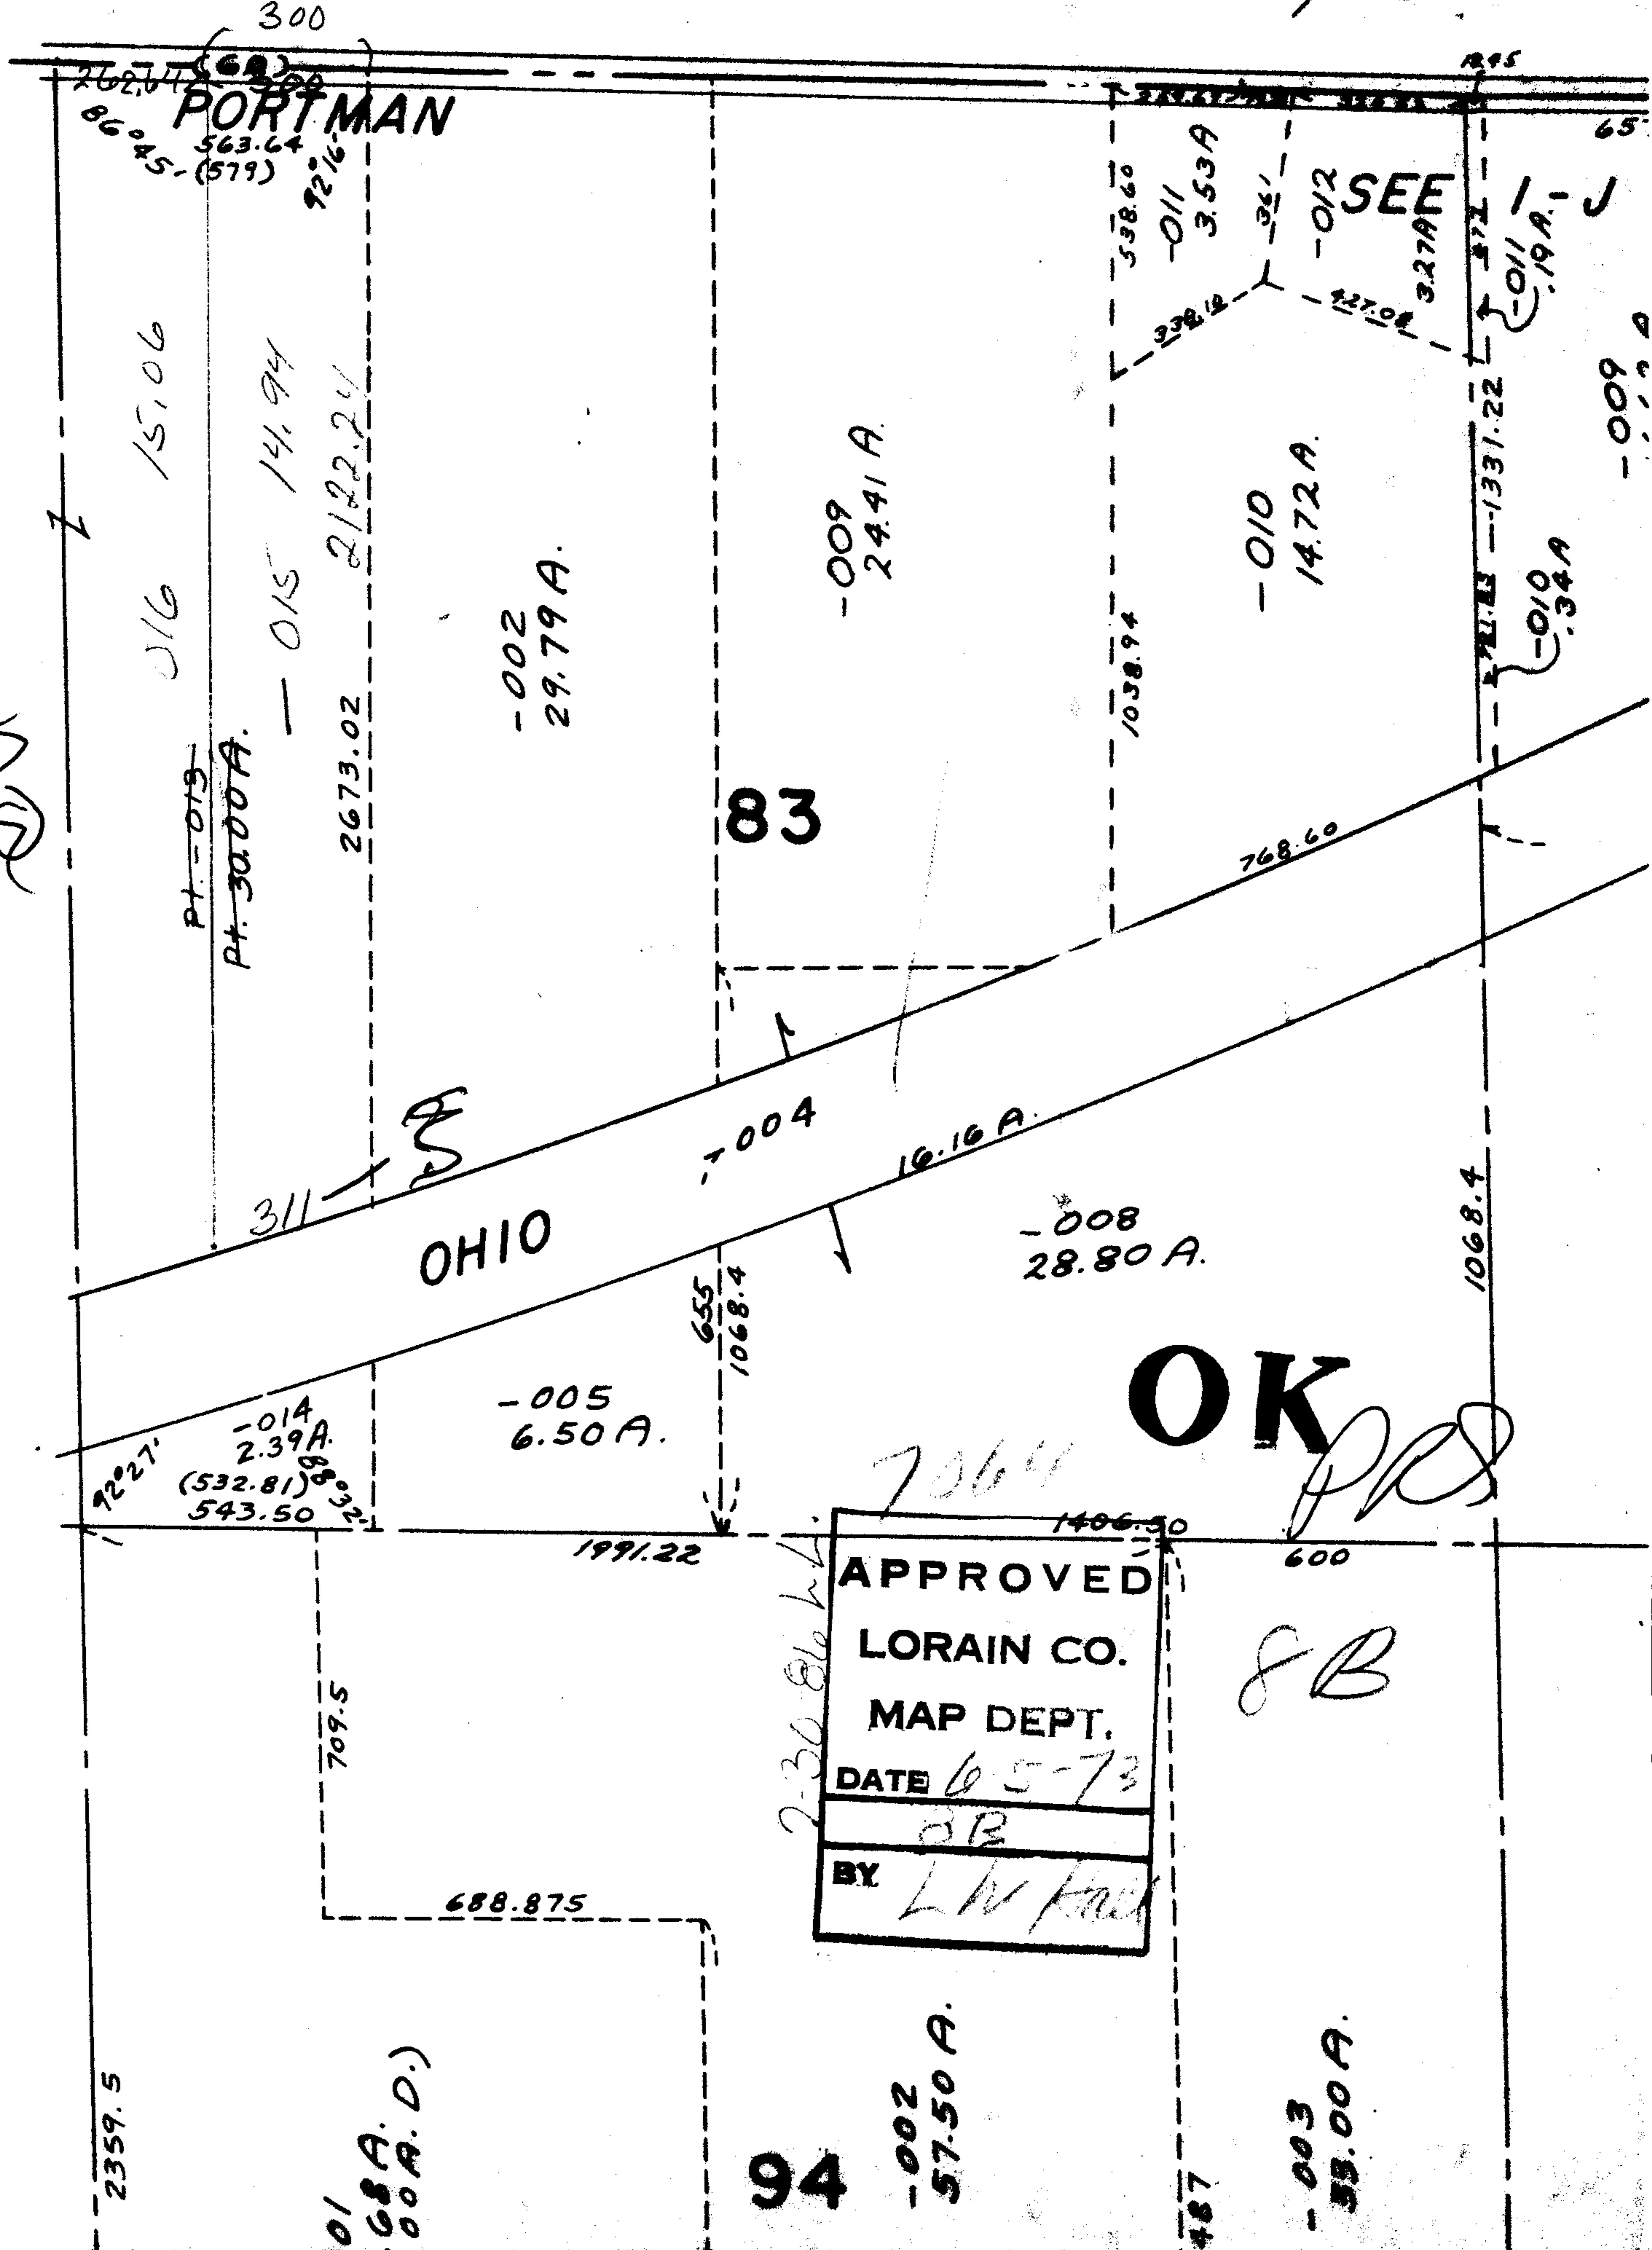

PORTMAN

OHIO

SEE

OK

APPROVED
 LORAIN CO.
 MAP DEPT.
 DATE 6-5-73
 BY LW Hall



300
 262.74
 86045-(579)
 563.64
 92 1/2'
 15.06
 14.94
 2122.24
 2673.02
 29.79 A.
 -002
 -009 24.41 A.
 538.60
 -011 3.53 A
 -012
 327 A
 1038.94
 -010 14.72 A.
 1331.22
 -011 1.19 A.
 -010 .34 A
 -009
 65
 768.60
 311
 -004
 16.16 A.
 -008 28.80 A.
 1068.4
 -014 2.39 A.
 (532.81)
 543.50
 1991.22
 655
 1068.4
 1406.50
 600
 709.5
 688.875
 2359.5
 68 A. D.)
 00 A. D.)
 94
 -002 57.50 A.
 487
 -003 55.00 A.