


7067

7.59
30.04
59

0133 Brighton Twp

See Brighton Twp

7.59
104
671022

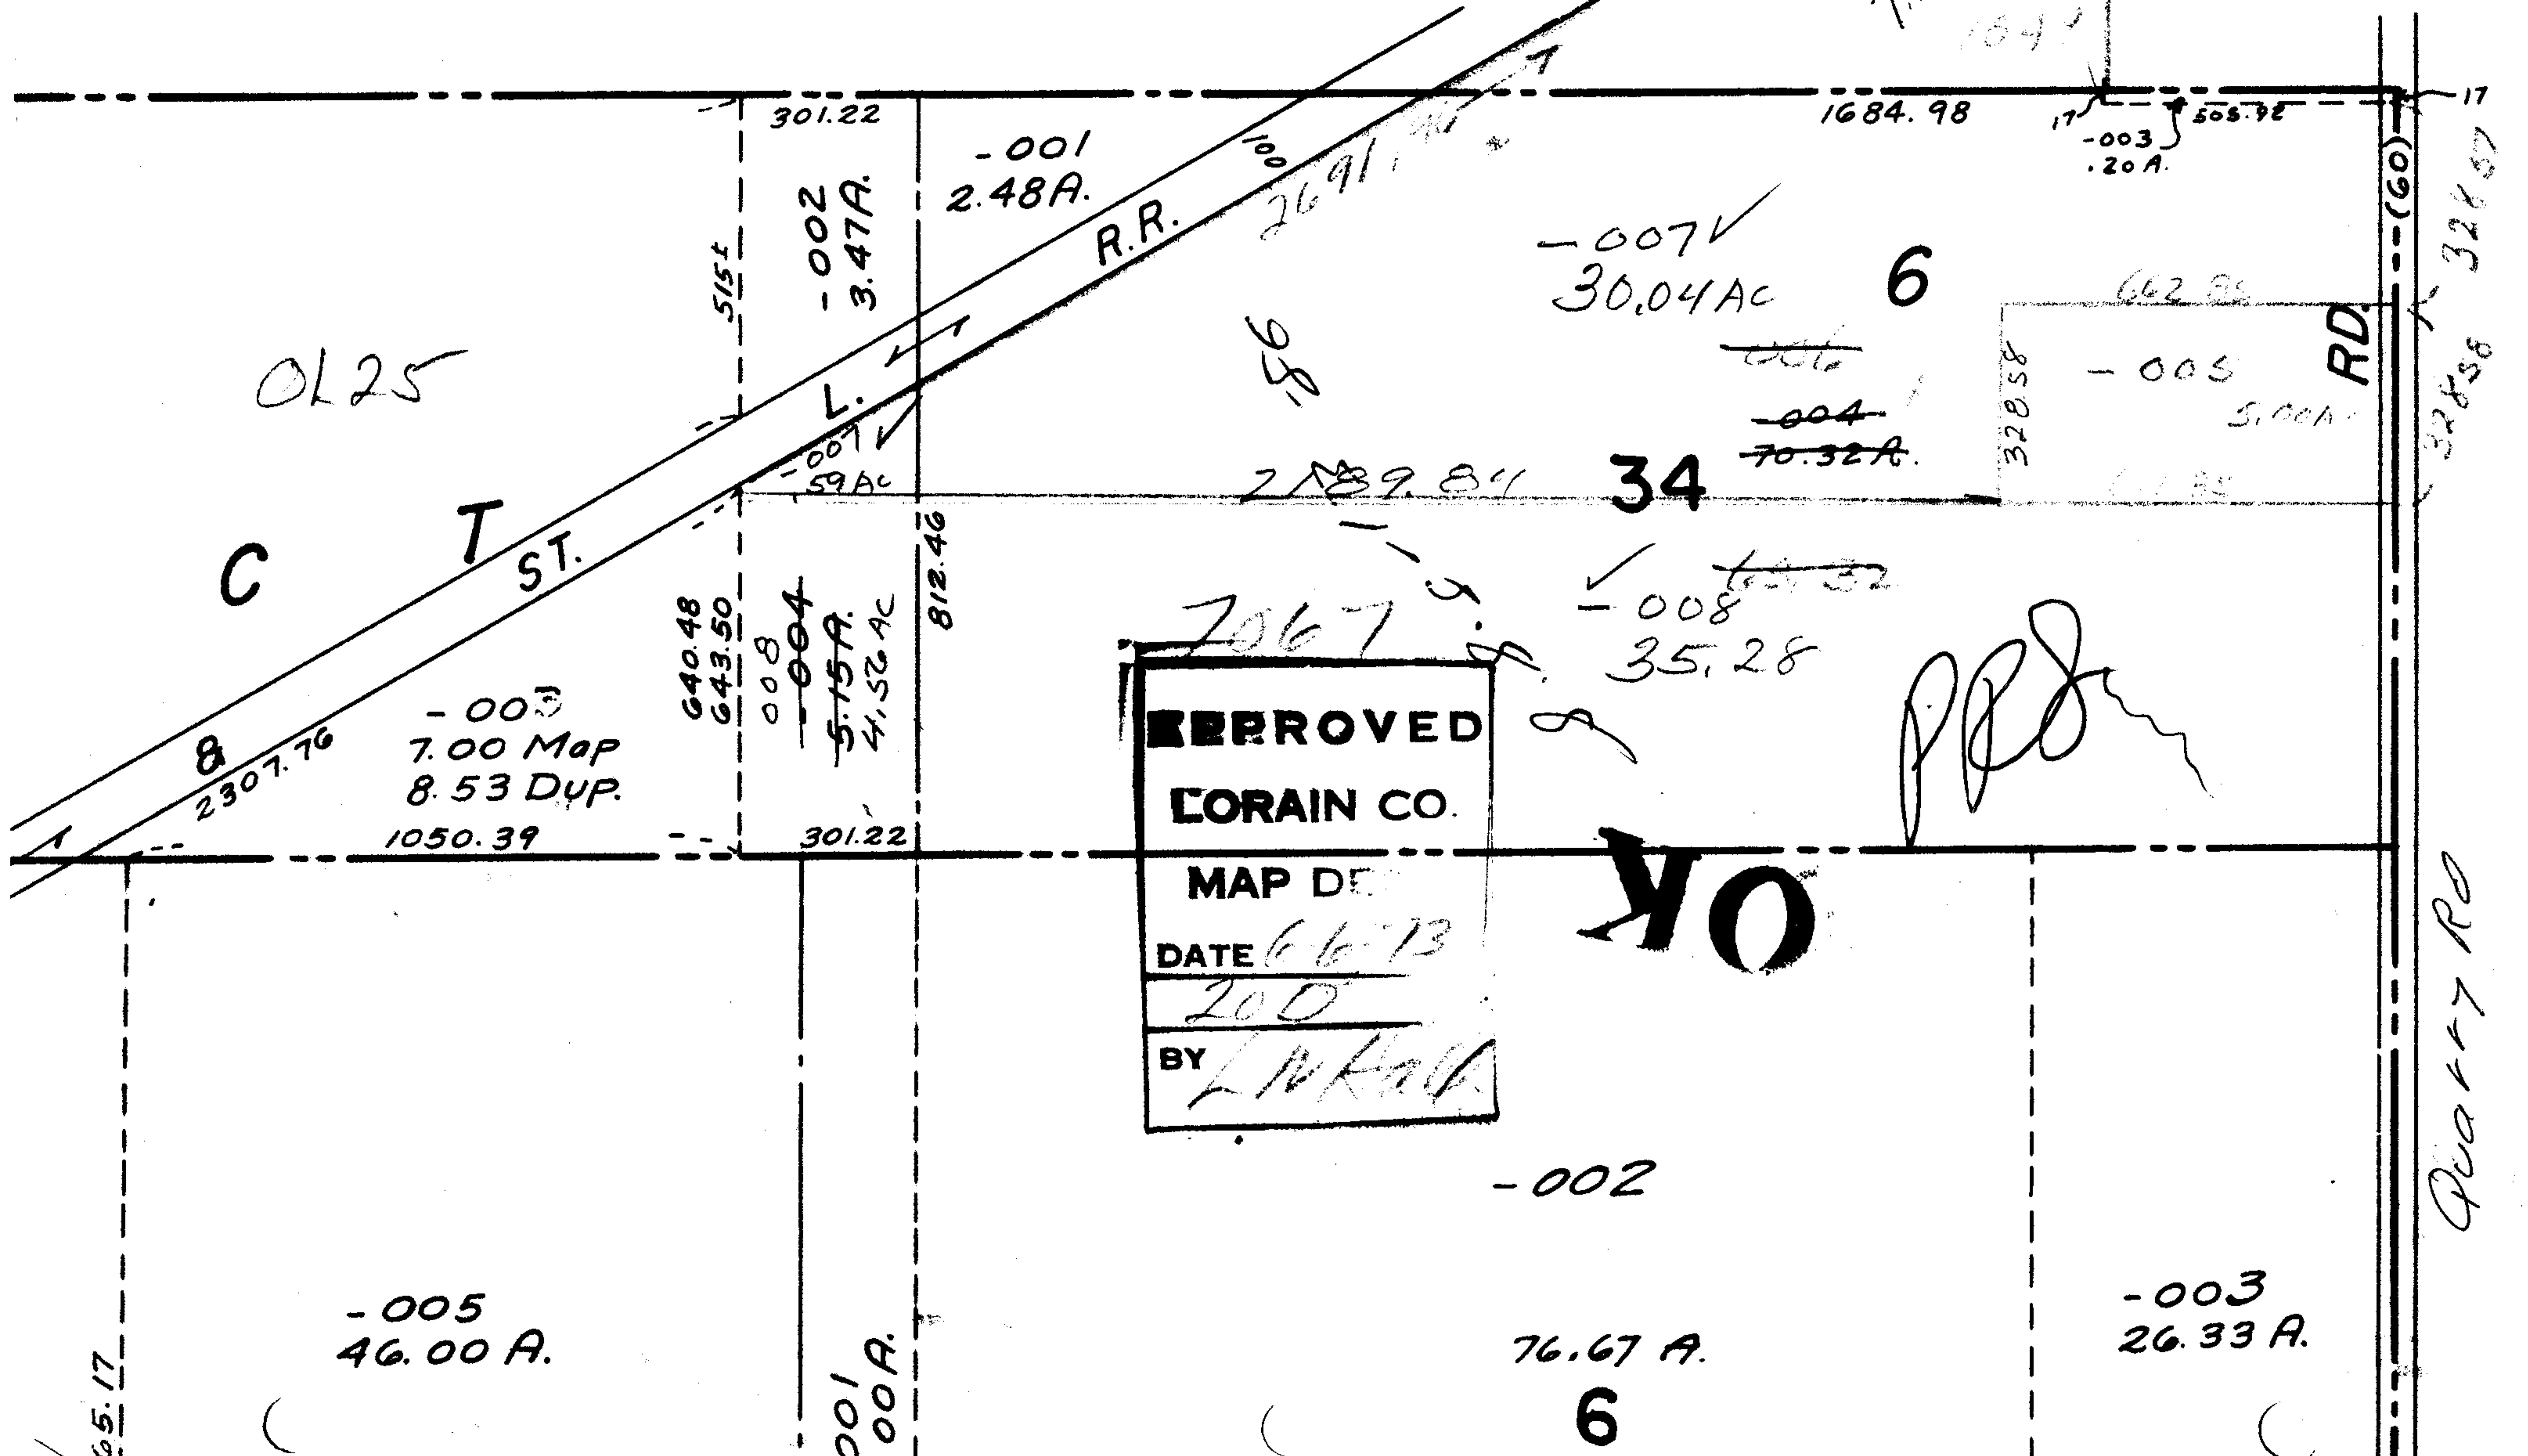

0125

C

T ST.

APPROVED
CORAIN CO.
 MAP DE
 DATE 6/6/73
 200
 BY L.W. Hall

OK

PPD

Quarry Rd

-005
46.00 A.

-001
2.00 A.

-002

76.67 A.

6

-003
26.33 A.

-001
2.48 A.

-002
3.47 A.

-007V
30.04 AC 6

-005
5.00 A.

34

-008
35.28

-003
7.00 Map
8.53 Dup.
1050.39

-004
5.15 A.
4.52 AC

2789.84

-004
70.32 A.

8
2307.76

640.48
643.50

008
-004

812.46

301.22

1684.98

-003
.20 A.

RD.

328.58
328.58

665.17

5151

R.R.

56

100
2691

17

17