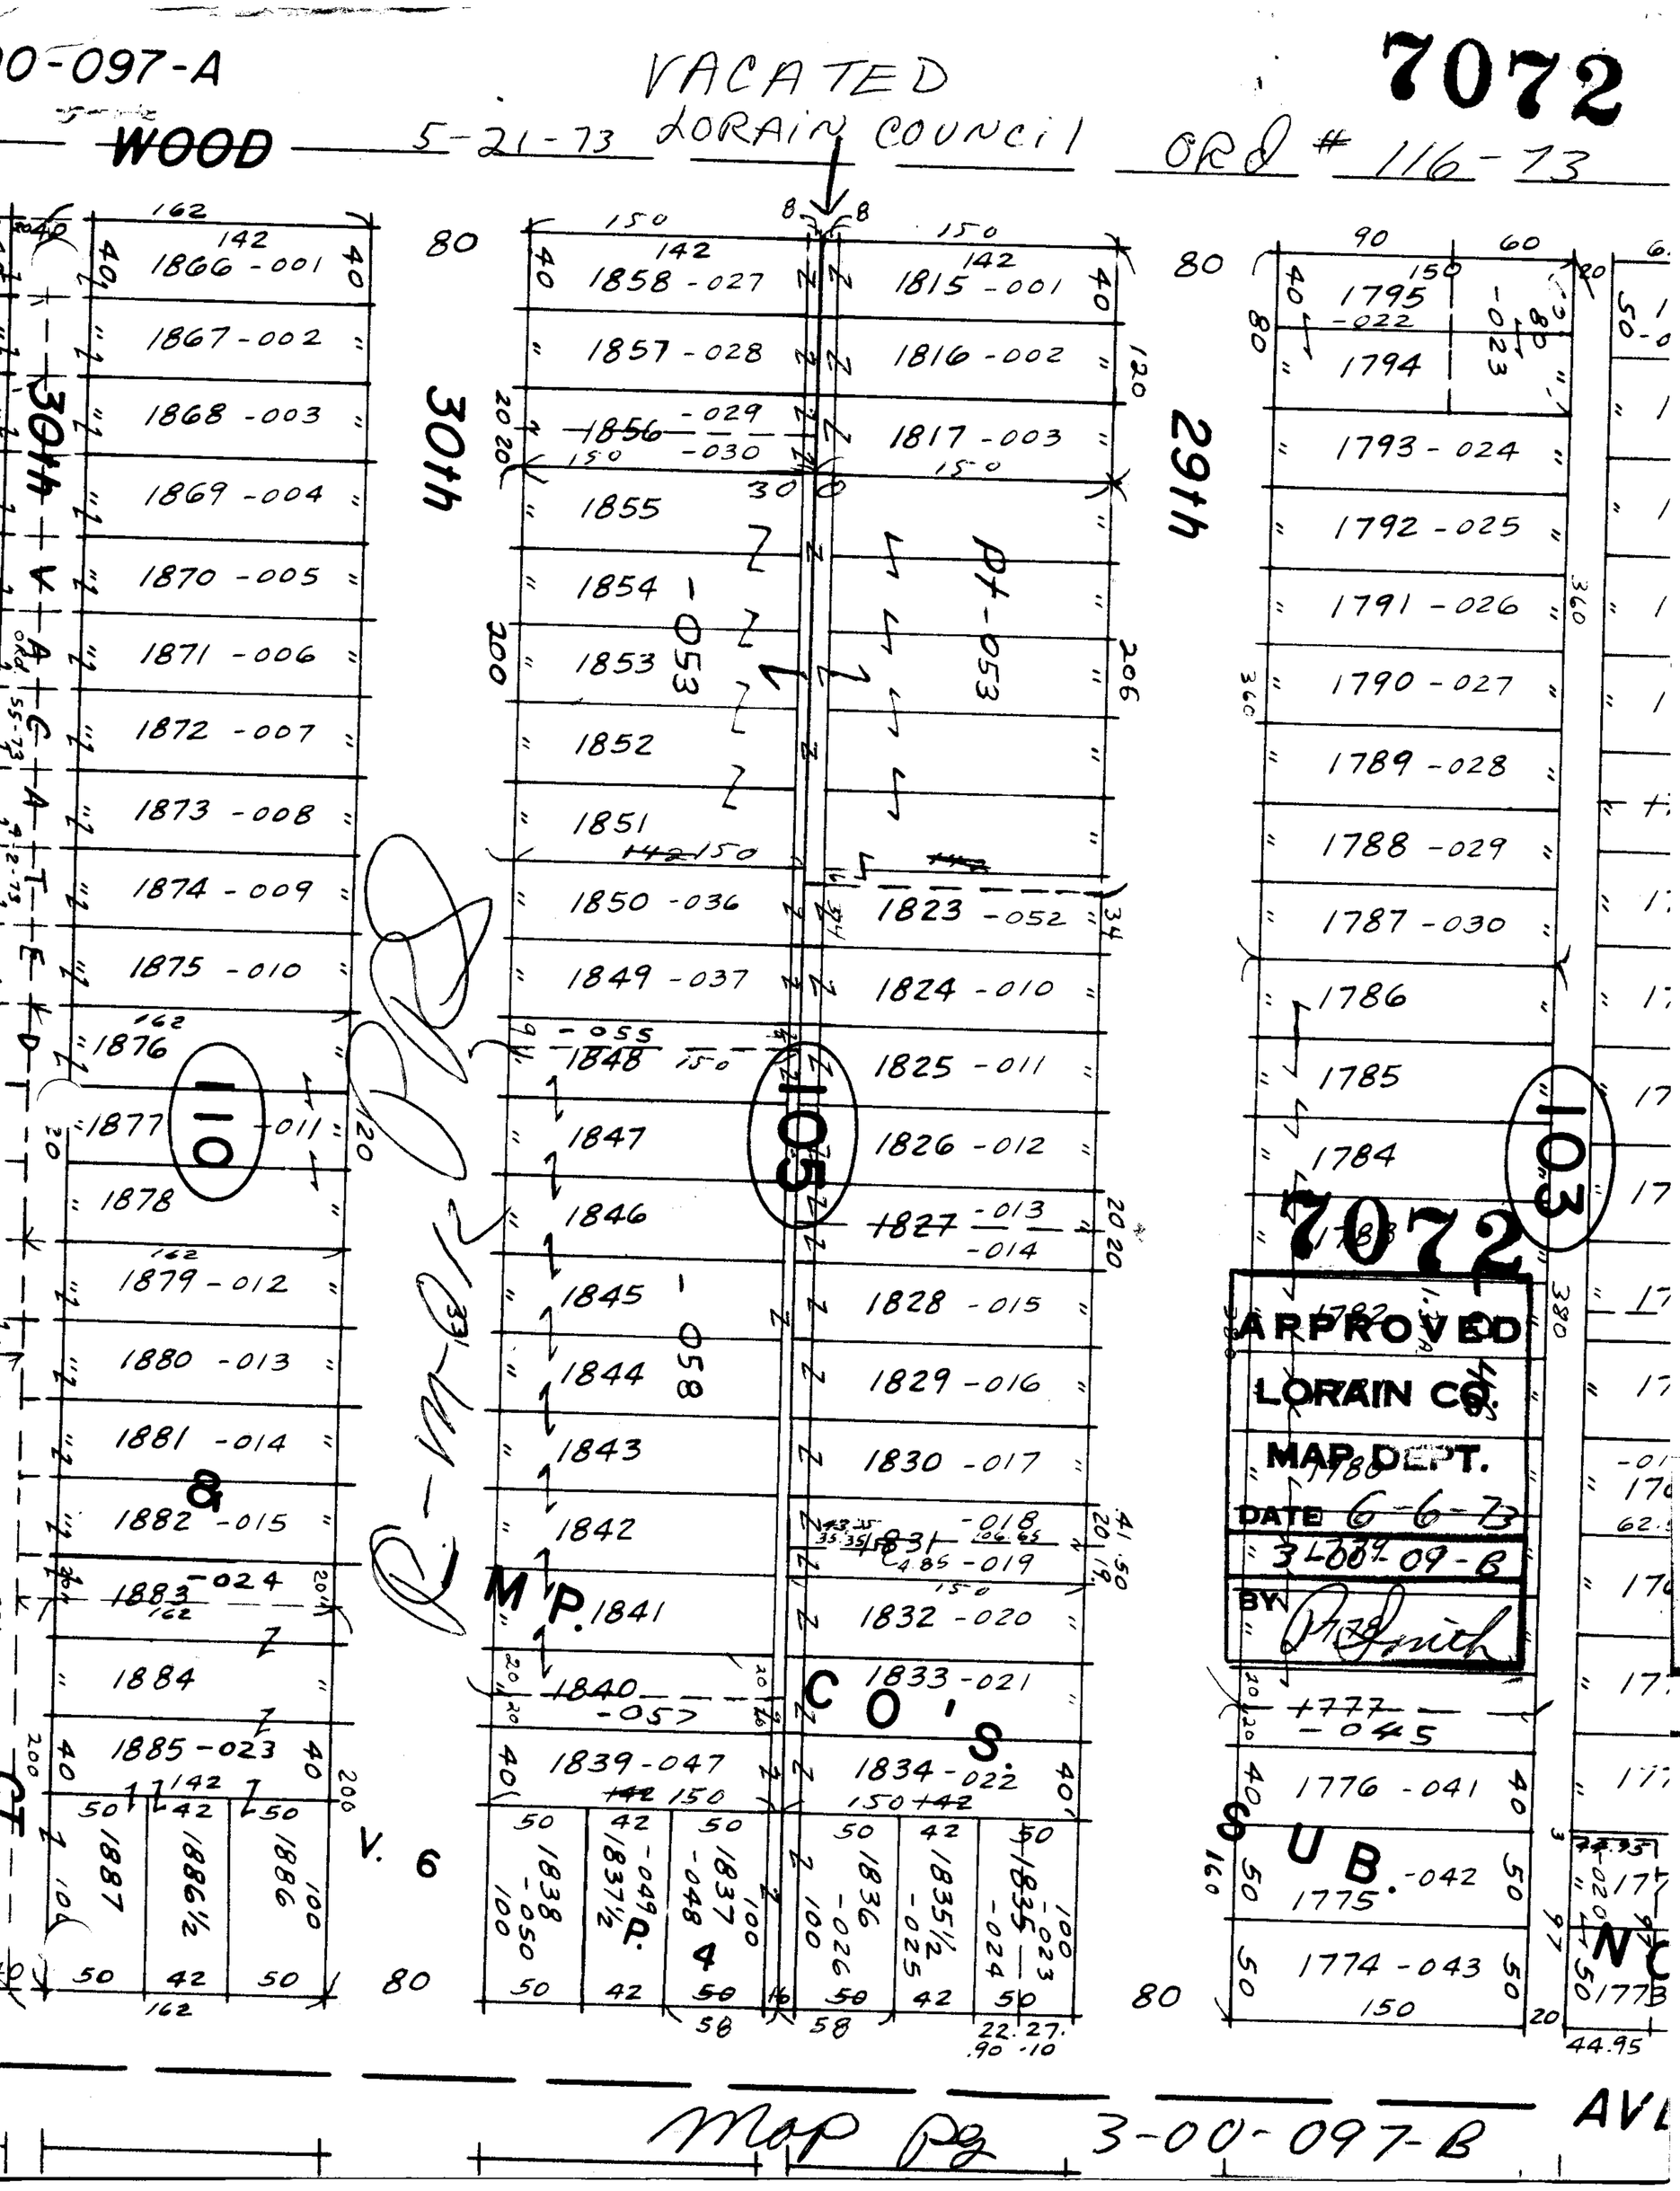

0-097-A
VACATED
7072
WOOD
5-21-73
LORAIN COUNCIL
ORD # 116-73
30th
29th
VACATED
1866-001
1867-002
1868-003
1869-004
1870-005
1871-006
1872-007
1873-008
1874-009
1875-010
1876
1877-011
1878
1879-012
1880-013
1881-014
1882-015
1883-024
1884
1885-023
1887
1886½
1886
1858-027
1857-028
1856-029
-030
1855
1854
1853
1852
1851
1850-036
1849-037
1848-055
1847
1846
1845
1844
1843
1842
1841
1840-057
1839-047
1838-050
1837½-049
1837-048
1836-026
1835½-025
1835-024
1815-001
1816-002
1817-003
1823-052
1824-010
1825-011
1826-012
1827-013
-014
1828-015
1829-016
1830-017
1831-018
-019
1832-020
1833-021
1834-022
1795-022
1794
1793-024
1792-025
1791-026
1790-027
1789-028
1788-029
1787-030
1786
1785
1784
1783
1782
1780
1779
1777-045
1776-041
1775-042
1774-043
110
105
103
8
MP.
CO'S.
SUB.
V. 6
P. 4
7072
APPROVED
LORAIN CO.
MAP DEPT.
DATE 6-6-73
3-00-09-B
BY
Map Pg 3-00-097-B
AVL