

SEE 9-00-108-A

OK

*[Handwritten signature]*

S.S.  
8-13-86

7073  
 APPROVED  
 LORAIN CO.  
 MAP DEPT.  
 DATE 6-8-73  
 9-00-108B  
 BY L.W. Hall

033  
 -002  
 36.63A.  
 3349 AC


7073  
 APPROVED  
 LORAIN CO.  
 MAP DEPT.  
 DATE 6-8-73  
 9-00-108B  
 BY L.W. Hall

# 7073

-035  
 -005  
 15.91A.  
 14.12

SEE 9-00-109-A

7073

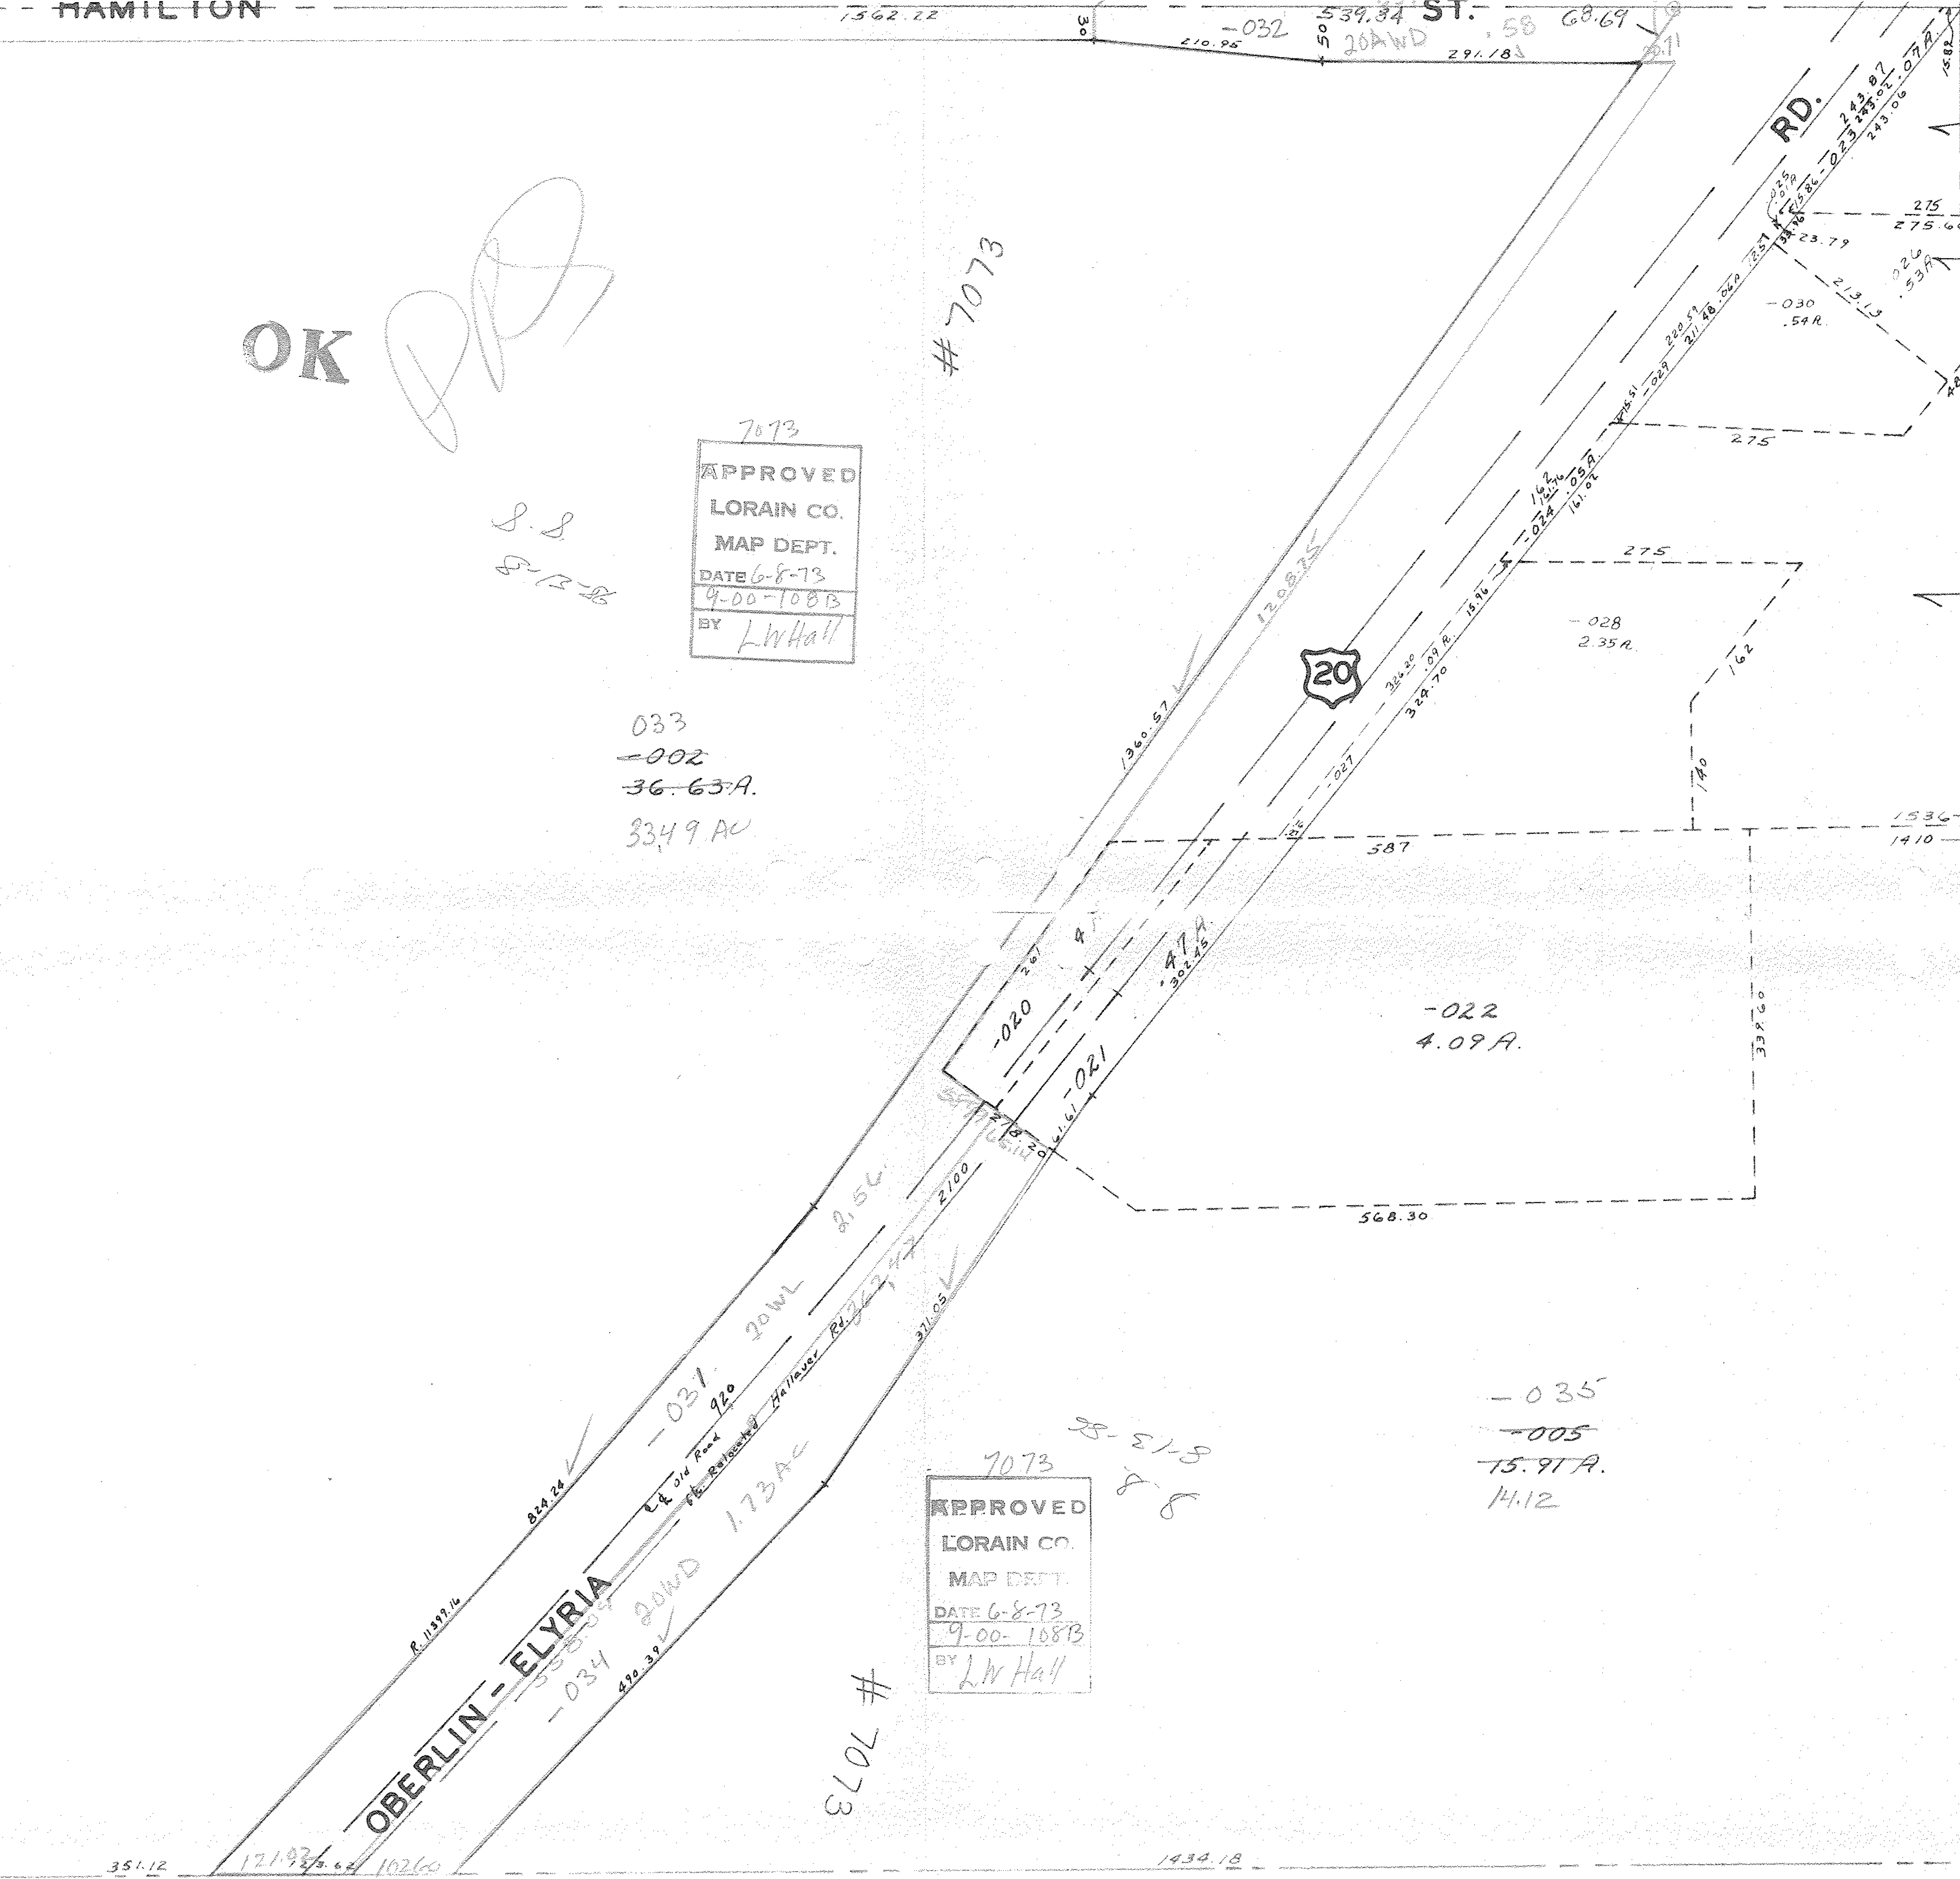

351.12

121.93  
10260

1434.18