

SEE 6-11


1146.42

WEST - RIVER 410.90
620.72

APPROVED
LORAIN CO.
MAP DEPT.
DATE 6-8-73
BY *[Signature]*

OK
7081

-002
4.12A

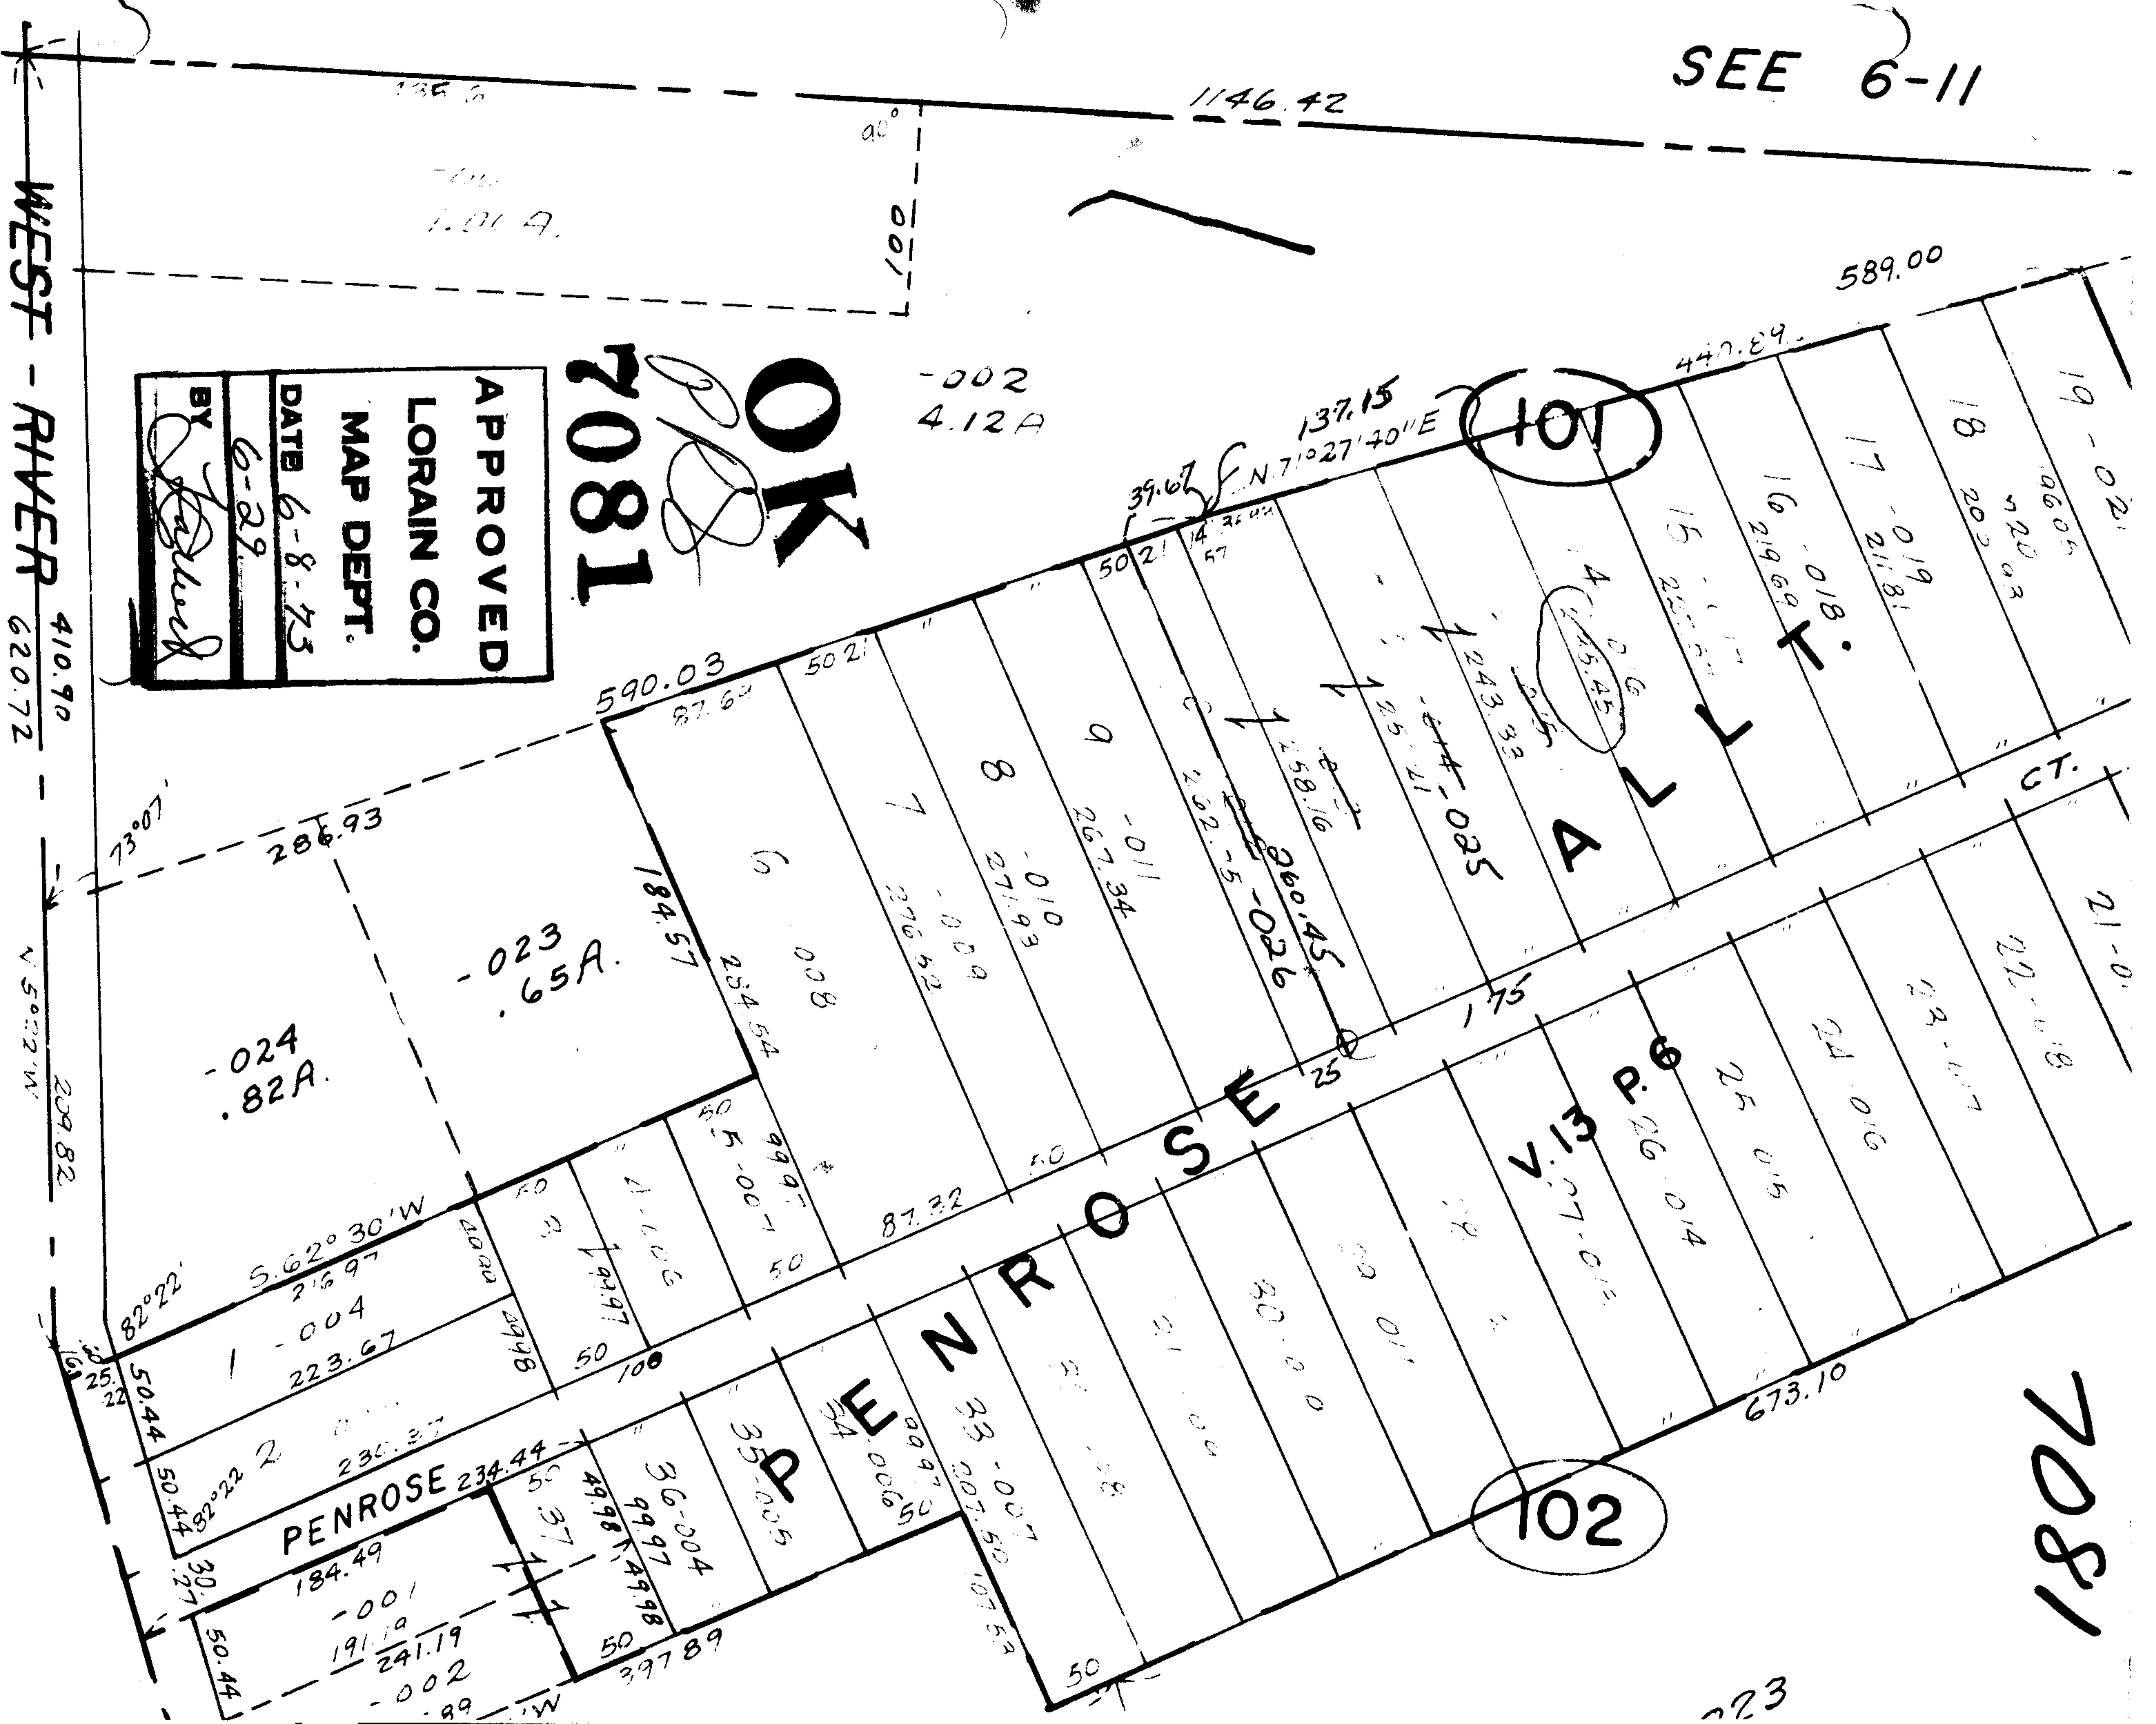

7081

223