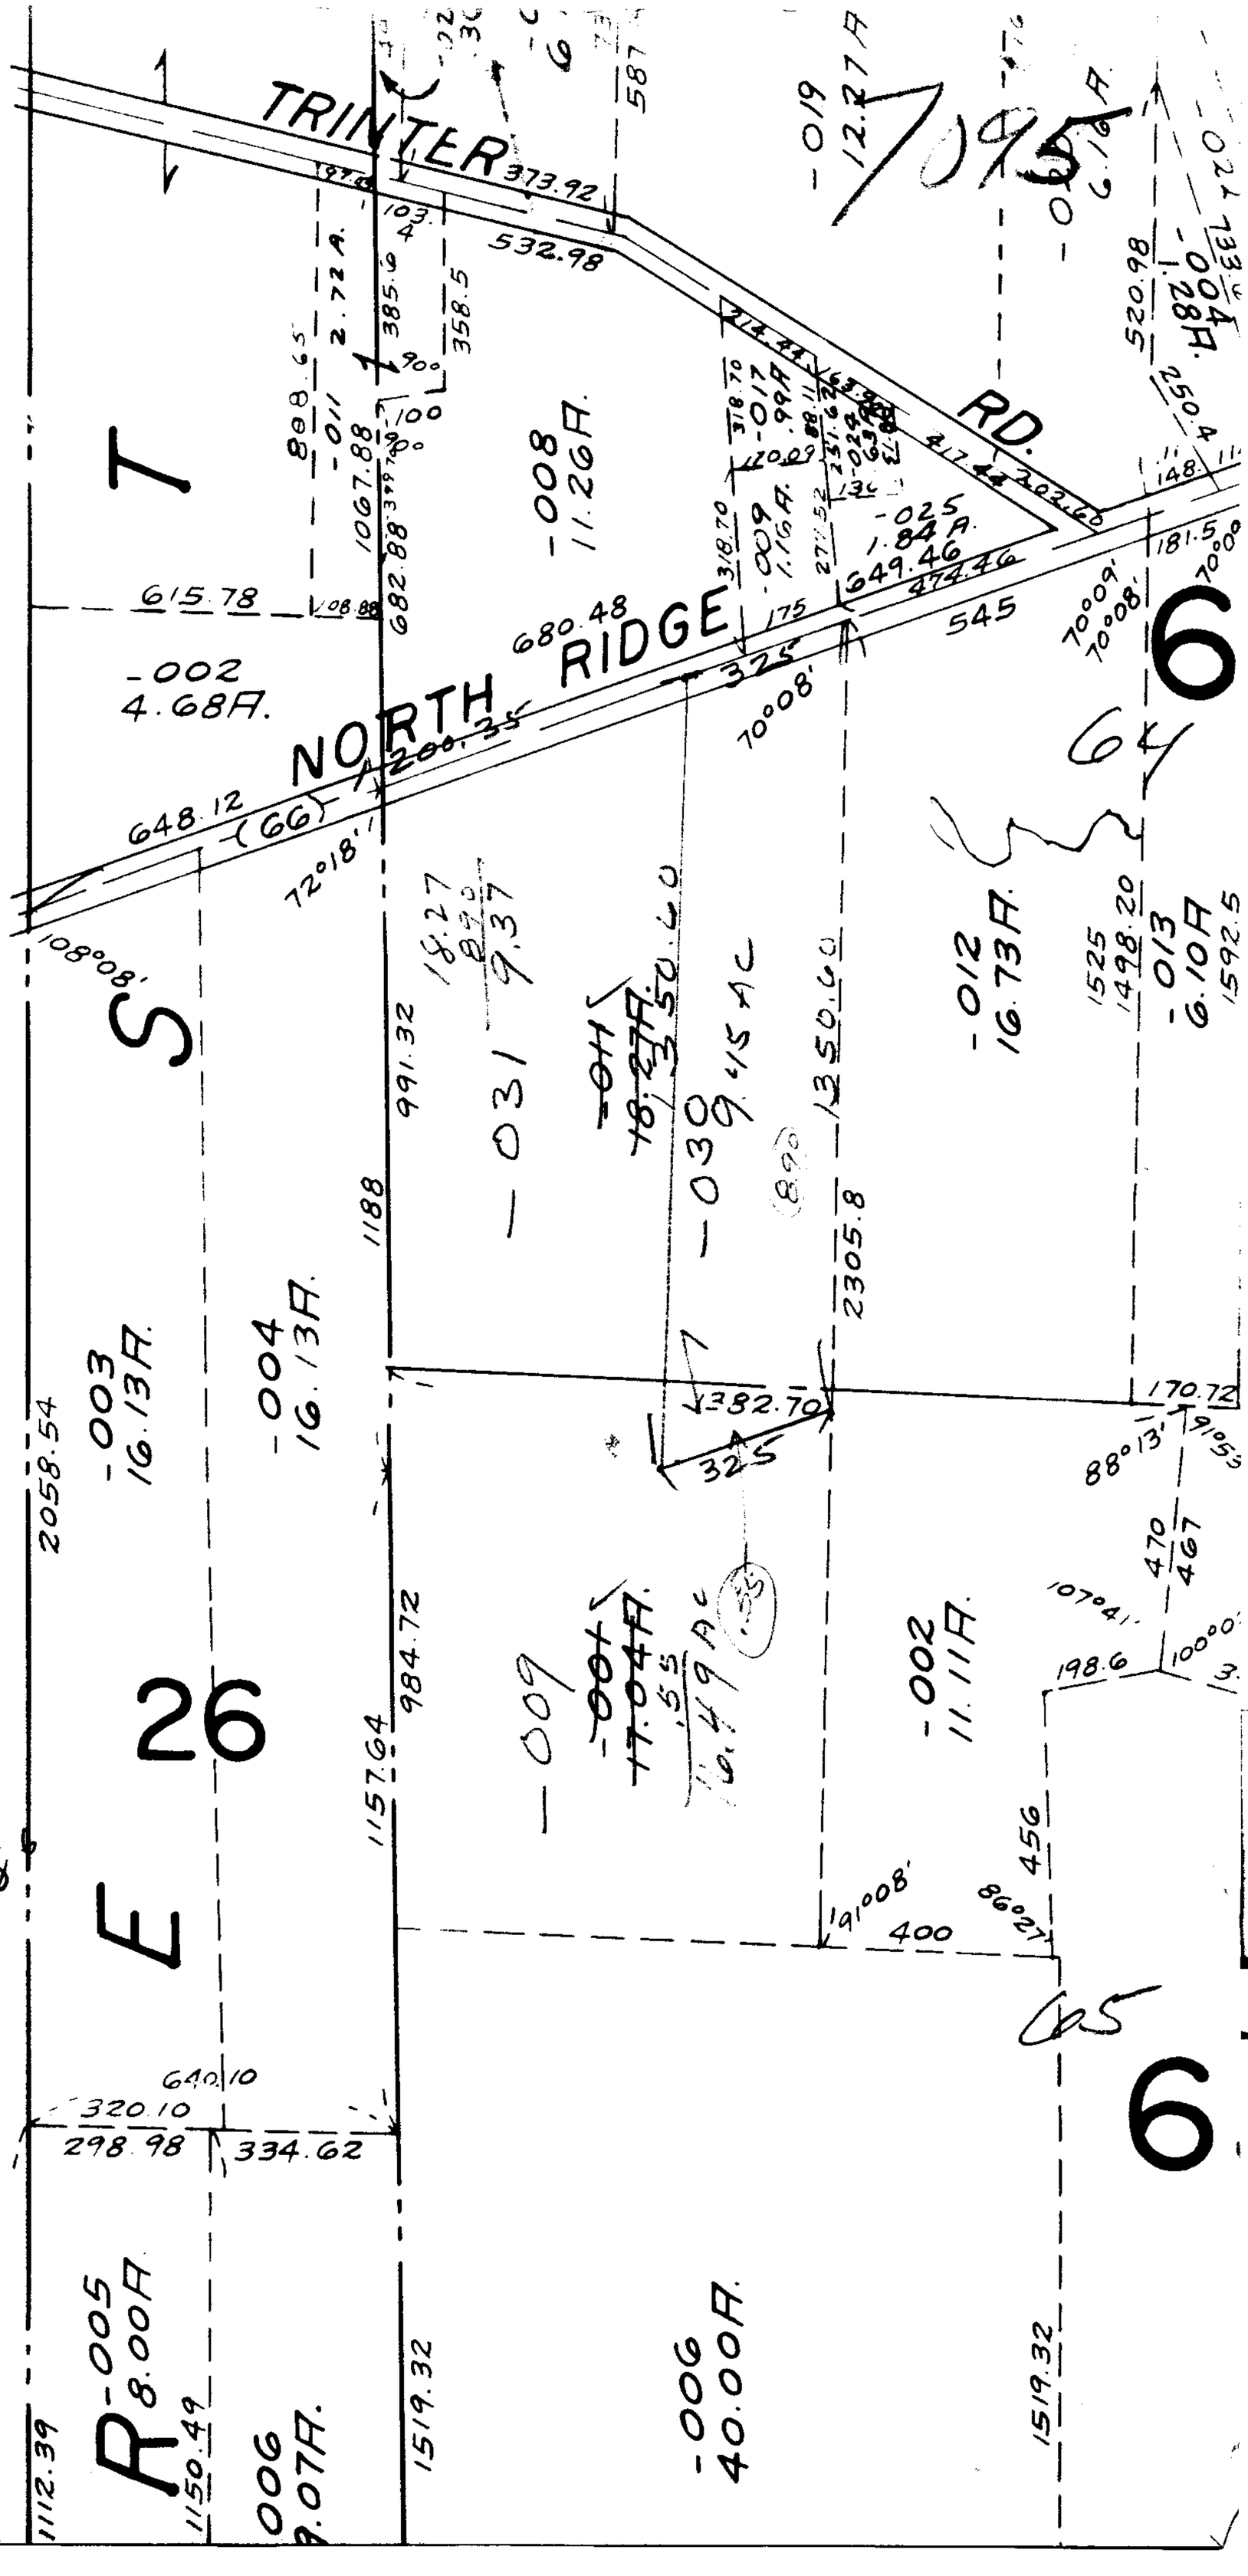
TRINTER
373.92
532.98
214.44
RD.
417.44
203.26
-019
12.77A.
-021
-004
1.28A.
520.98
250.4
148.
-017
9.99A.
-025
1.84A.
649.46
474.46
181.5
70°09'
70°08'
-008
11.26A.
587
385.6
358.5
103.4
90°
-011
2.72A.
808.65
1067.88
92.88
-100
-002
4.68A.
615.78
108.88
682.
680.48
NORTH RIDGE
325
545
648.12
(66)
200.35
72°18'
108°08'
991.32
18.27
9.37
-031
-030
9.15AC
-012
16.73A.
1525
1498.20
-013
6.10A
1592.5
64
6
S
26
E
1188
-003
16.13A.
-004
16.13A.
2058.54
1157.64
984.72
-009
-001
11.49AC
-002
11.11A.
1382.70
325
170.72
88°13'
91°55'
470
467
107°41'
100°00'
198.6
191°08'
400
86°27'
456
65
640.10
320.10
298.98
334.62
R-005
8.00A.
1150.49
1112.39
006
9.07A.
1519.32
-006
40.00A.
OK
7095
APPROVED
LORAIN CO.
MAP DEPT.
DATE 6-14-73
BY L.H. Hall
I I