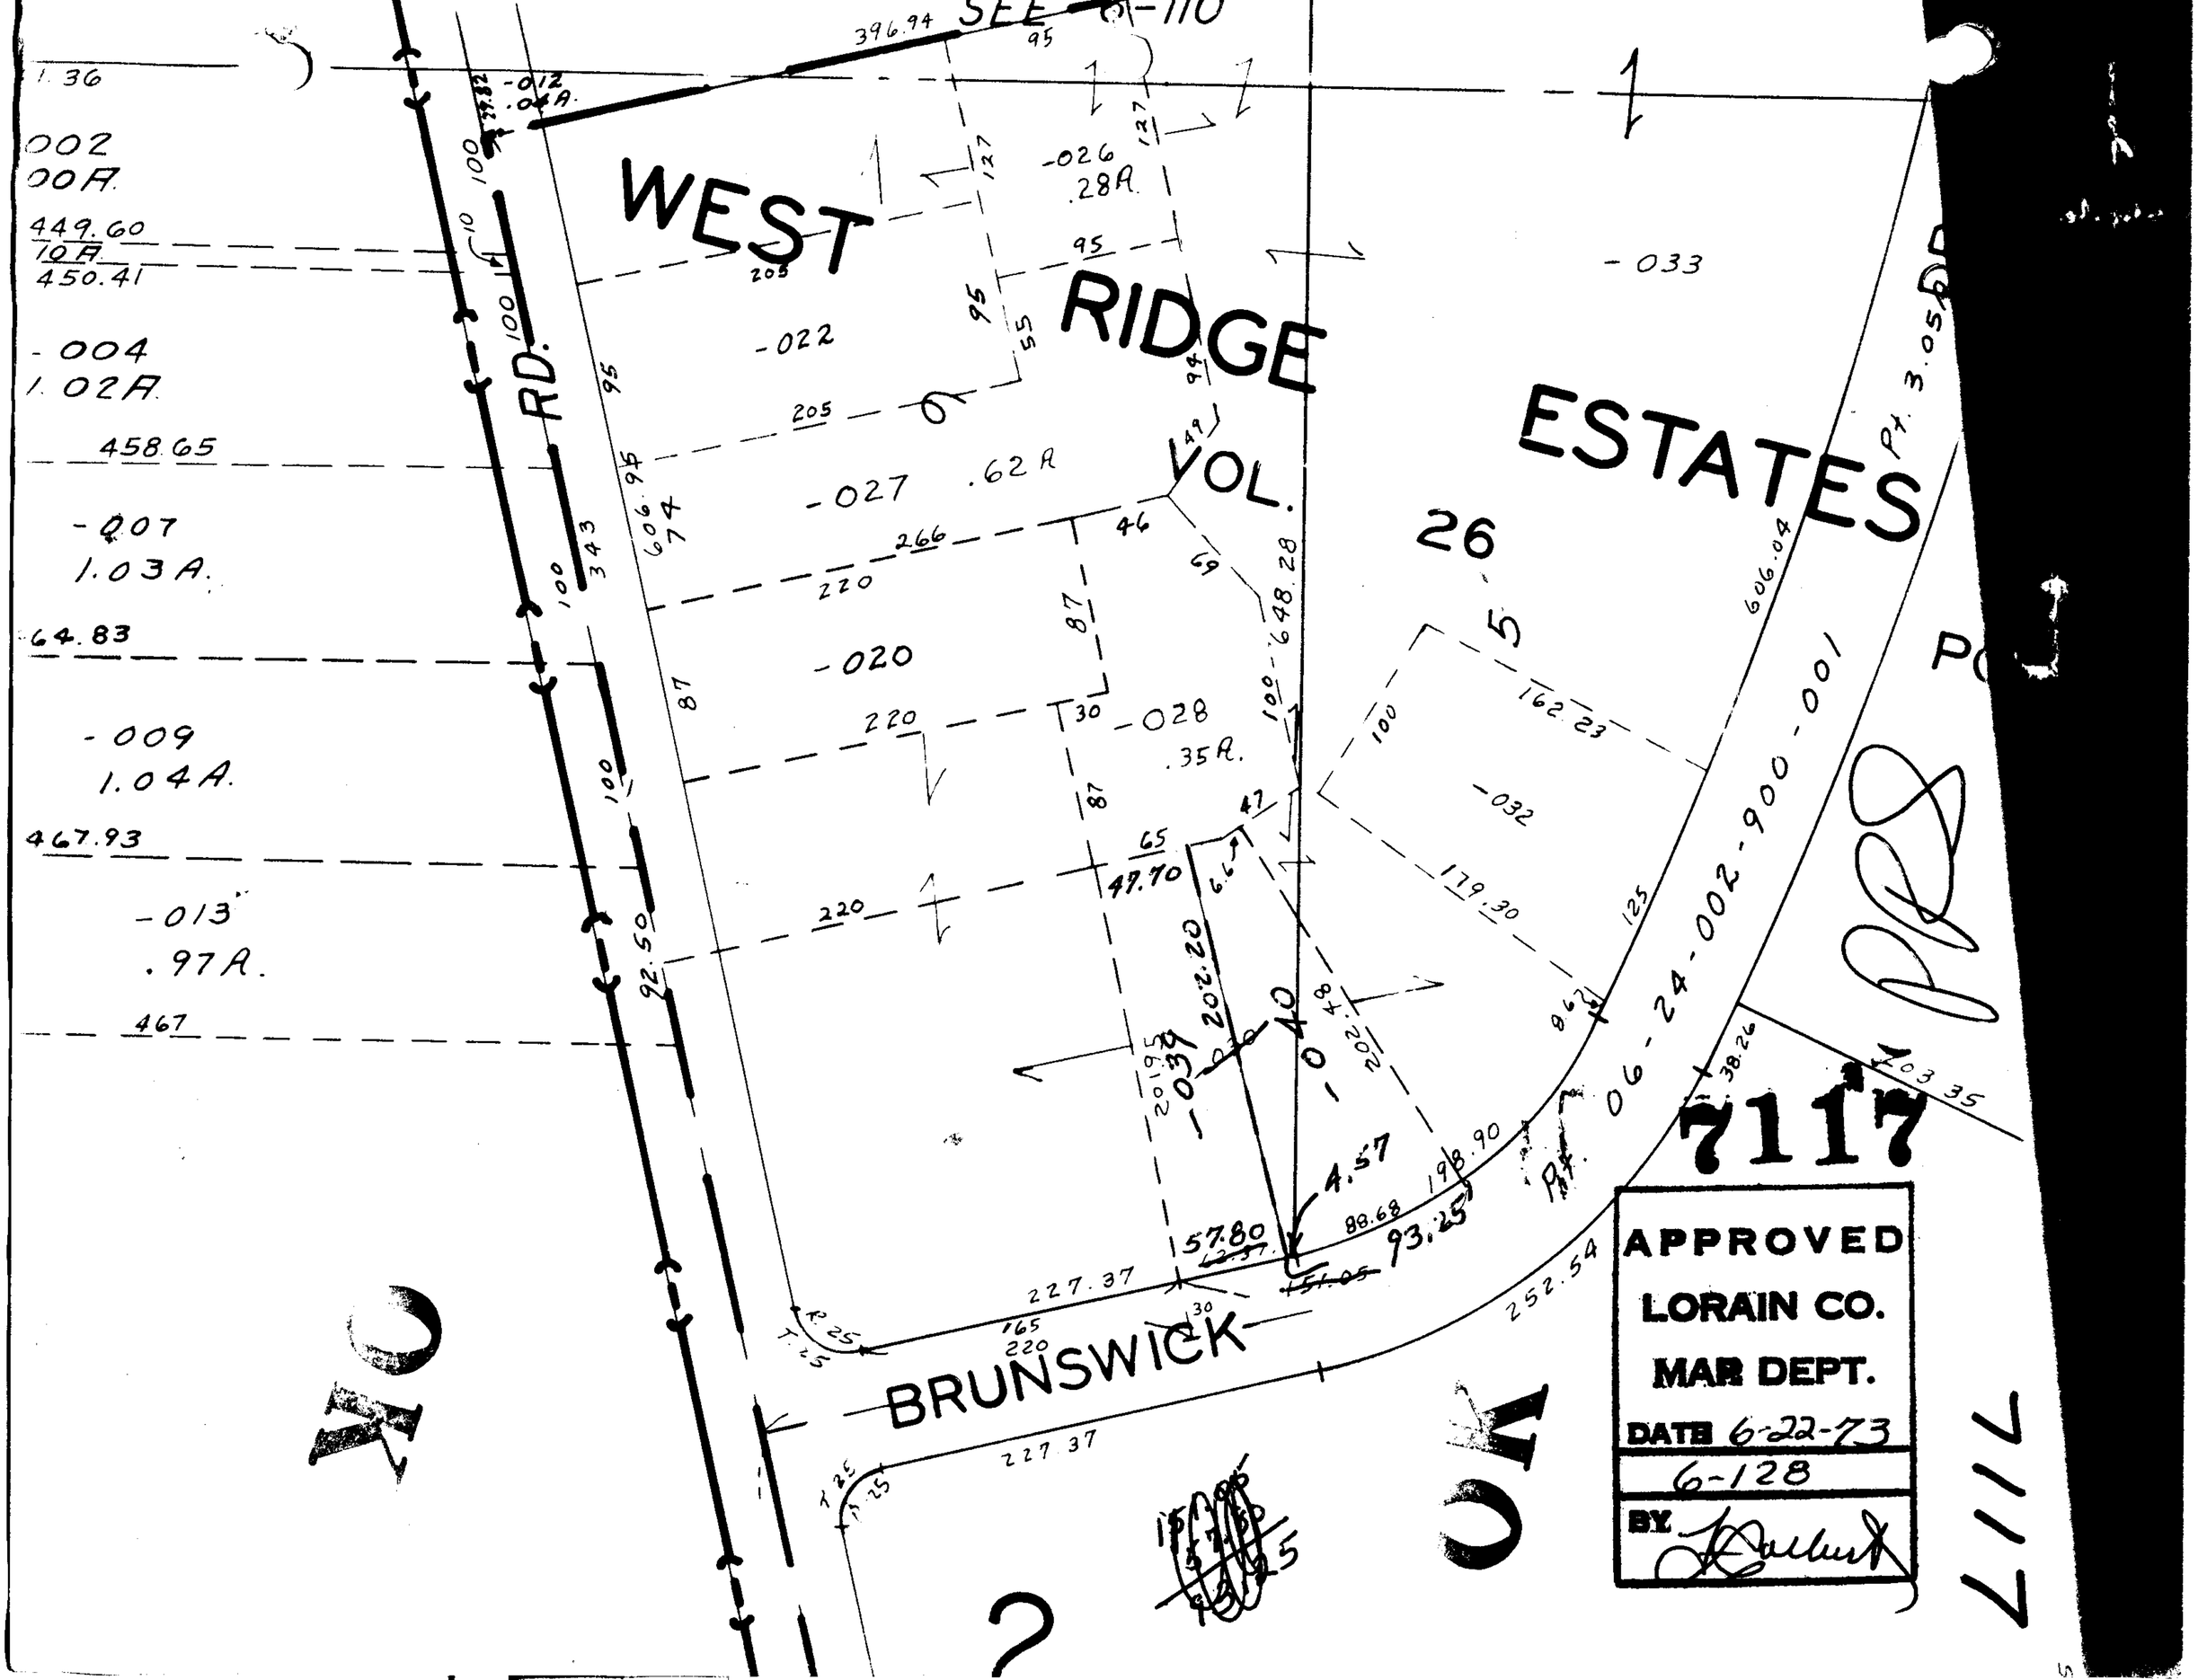

WEST RIDGE ESTATES
VOL. 26
BRUNSWICK
RD.
SEE 6-110
7117
APPROVED
LORAIN CO.
MAR DEPT.
DATE 6-22-73
6-128
BY