


7128

SOUTH AMHERST

PYLE

RUSSIA

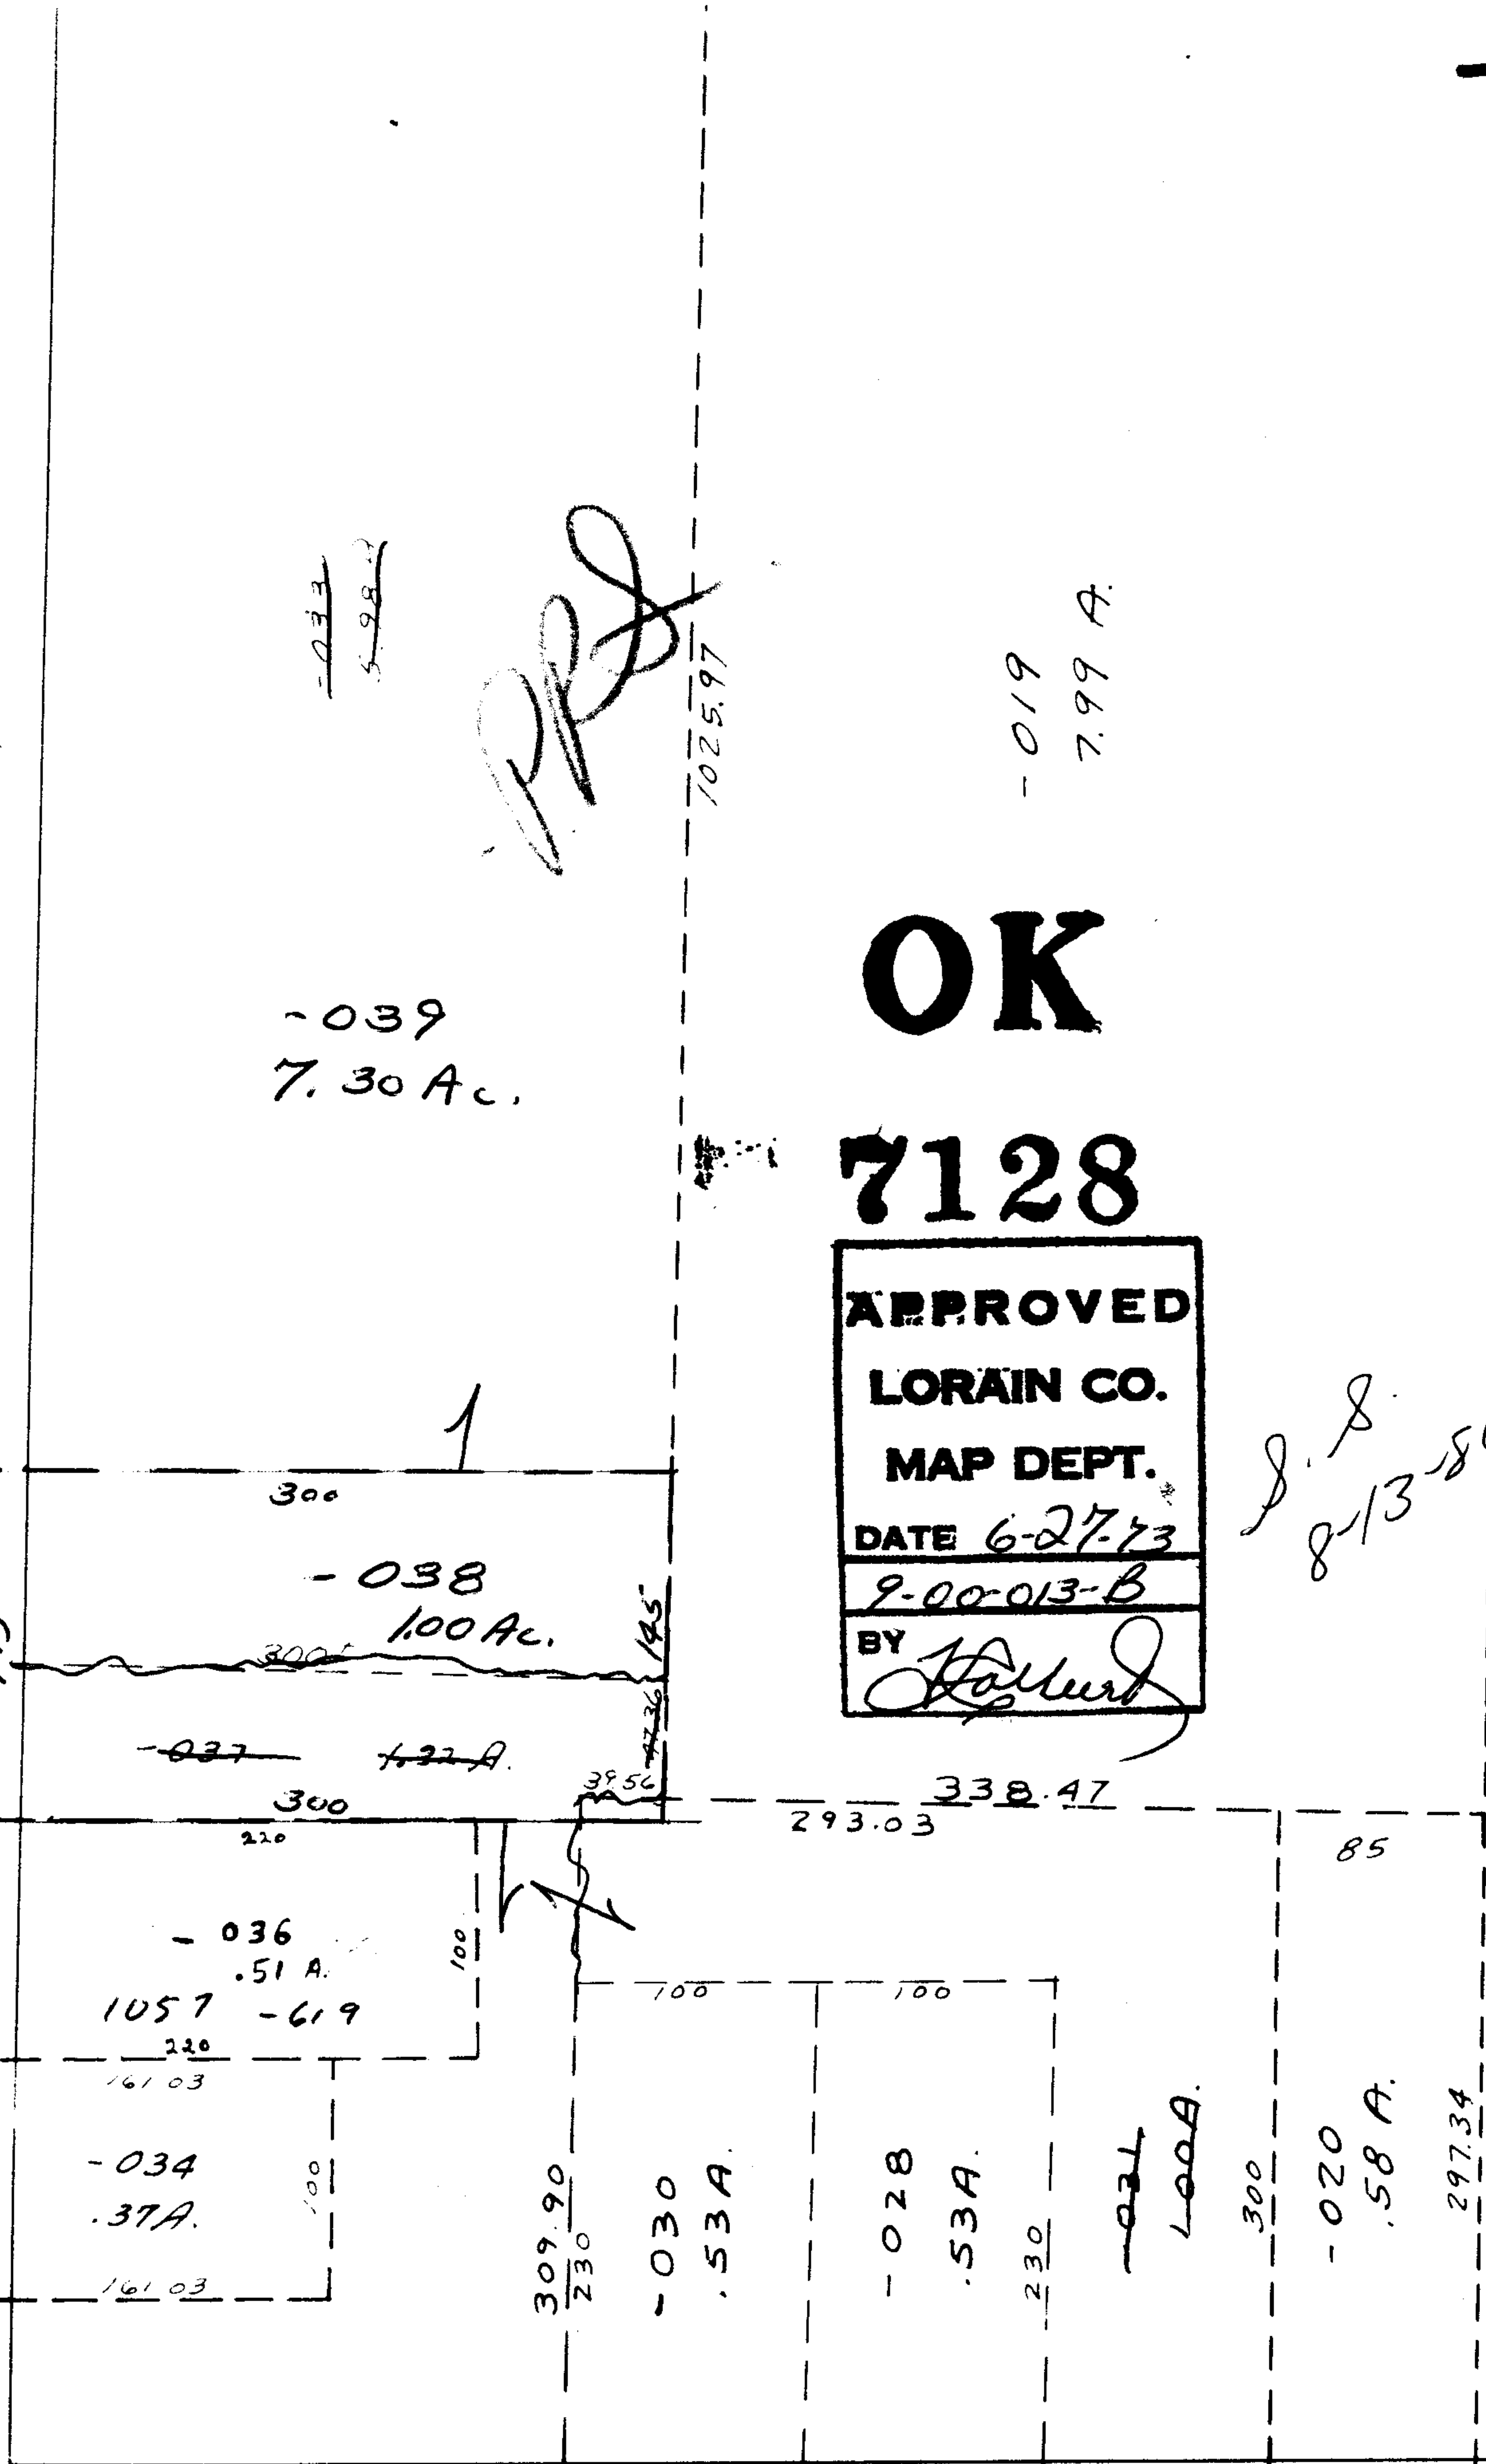

OK

7128

APPROVED  
 LORAIN CO.  
 MAP DEPT.  
 DATE 6-27-73  
 9-00-013-B  
 BY *[Signature]*

*S.S.*  
8-13-86

1.00  
 5.98  
 ---  
 6.98  
 7.30

SEE 9-00-023